
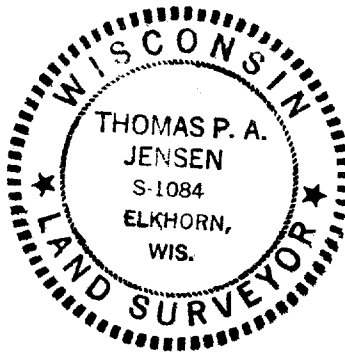


PLAT OF SURVEY

OF

LOT 56 LYNNDALE SUBDIVISION ADDITION NO. ONE,
LOCATED IN THE SW 1/4 OF THE NW 1/4 OF SECTION 20,
T4N R18E, VILLAGE OF EAST TROY, WALWORTH CO. WISCONSIN

UNPLATTED LANDS

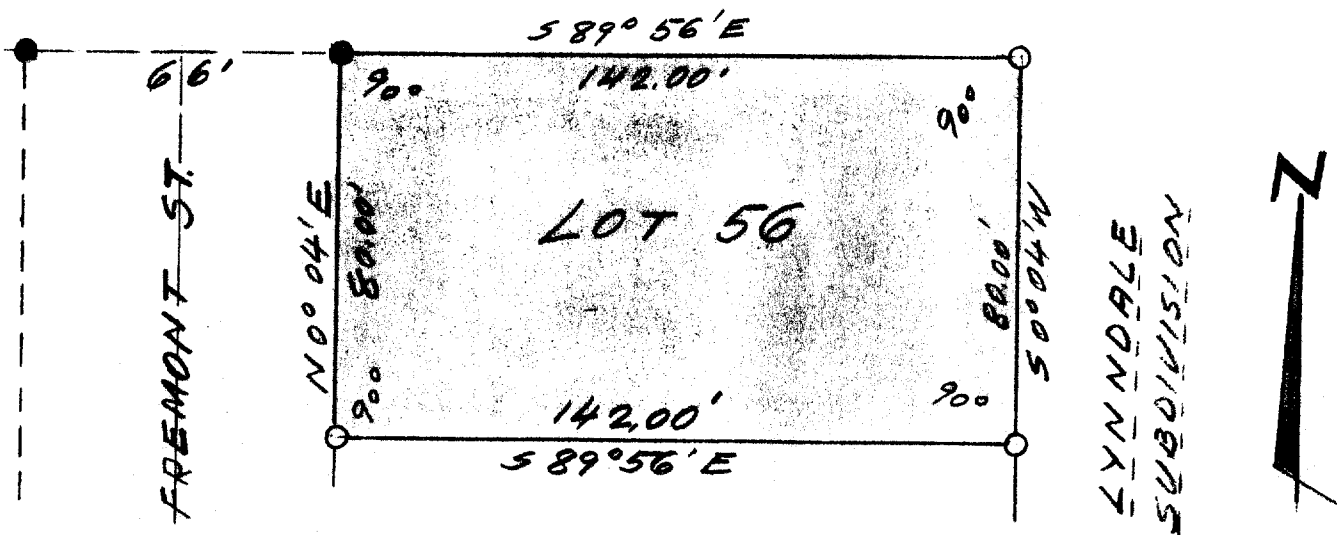

SURVEYED FOR:

JAMES BLOCK
2602 W. BOLIVAR AVE
MILWAUKEE, WIS 53221

LEGEND

- — Iron Pipe FOUND
- — IRON ROD FOUND
- — Concrete Monument

Scale 1" = 40'

WE CERTIFY: That we have surveyed the above described property and that the plat shown hereon is an accurate survey and a true representation thereof and correctly shows the exterior boundary lines and all divisions of said property.

Date JUNE 8, 1976

Thomas P. A. Jensen
THOMAS P. A. JENSEN

Wisconsin Registered Land Surveyor, No. S-1084