


KOLB LAND CONSULTING, INC.
LAND SURVEYING • SUBDIVIDING • LAND PLANNING

LAKE GENEVA, WISCONSIN 53147

WHITEWATER, WISCONSIN 53190

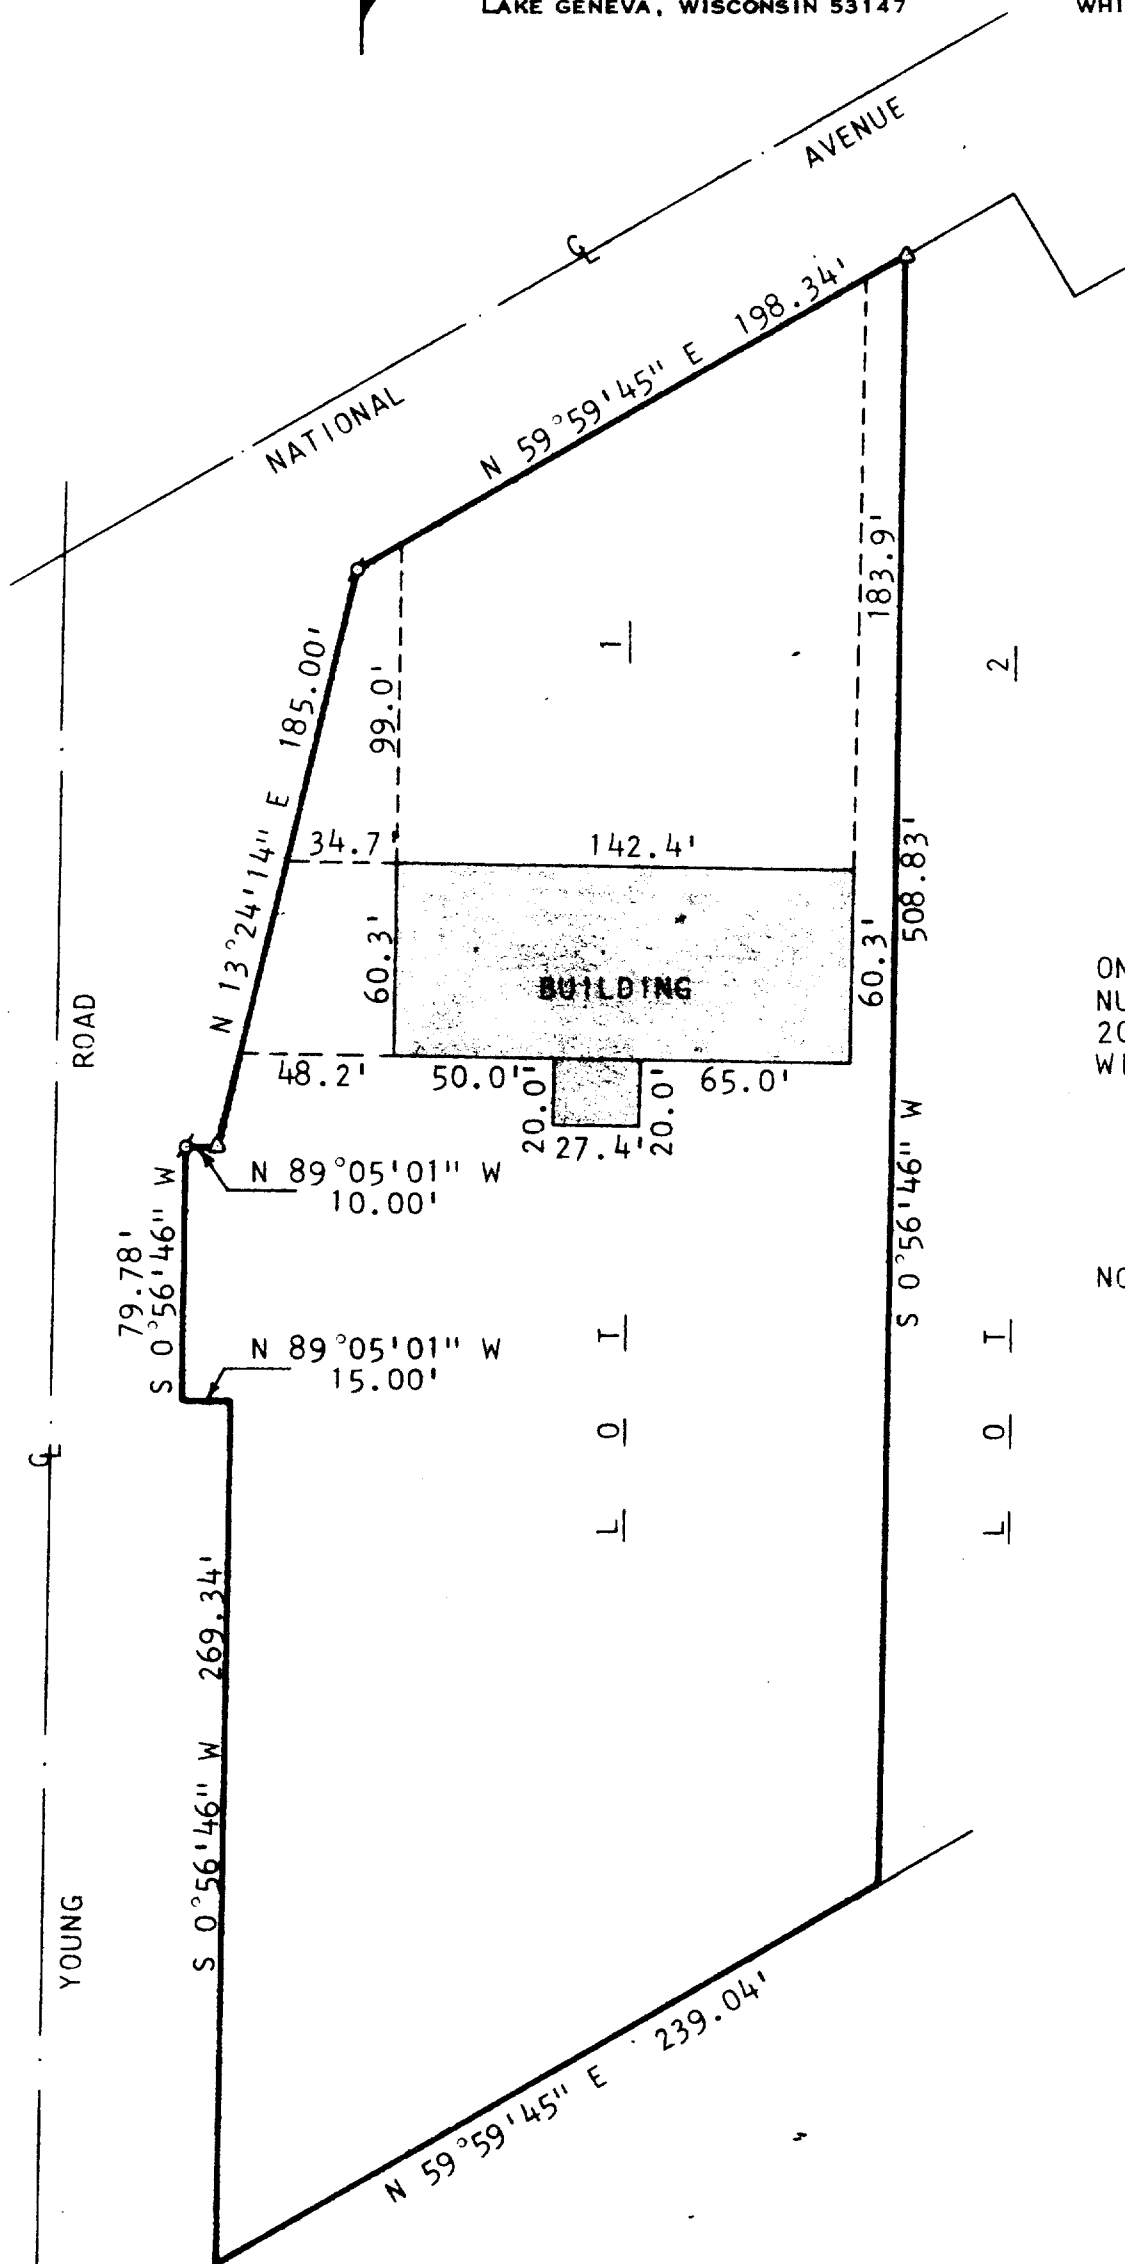

BUILDING LOCATION

ON LOT 1, CERTIFIED SURVEY MAP
NUMBER 839. LOCATED IN SECTION
20, T4N, R18E, WALWORTH COUNTY,
WISCONSIN.

NOTE: SURVEY INFORMATION TAKEN
FROM CERTIFIED SURVEY MAP
NUMBER 839, BY WILLIAM A.
SHEARMAN, JULY 25, 1978.



SCALE : 1"=60'
LEGEND

⊙ - IRON PIPE FOUND
△ - IRON ROD FOUND



I, HAROLD H. KOLB DO HEREBY CERTIFY THAT I
HAVE SURVEYED THE PROPERTY HEREON AS DES-
CRIBED ABOVE, AND THAT THE PLAT HEREON IS
A CORRECT REPRESENTATION OF THE LOT LINES
AND THE PRINCIPLE LINES OF THE BUILDINGS
THEREON.

Harold H. Kolb

WISCONSIN REGISTERED LAND SURVEYOR, S-187
DATE June 28, 1979