


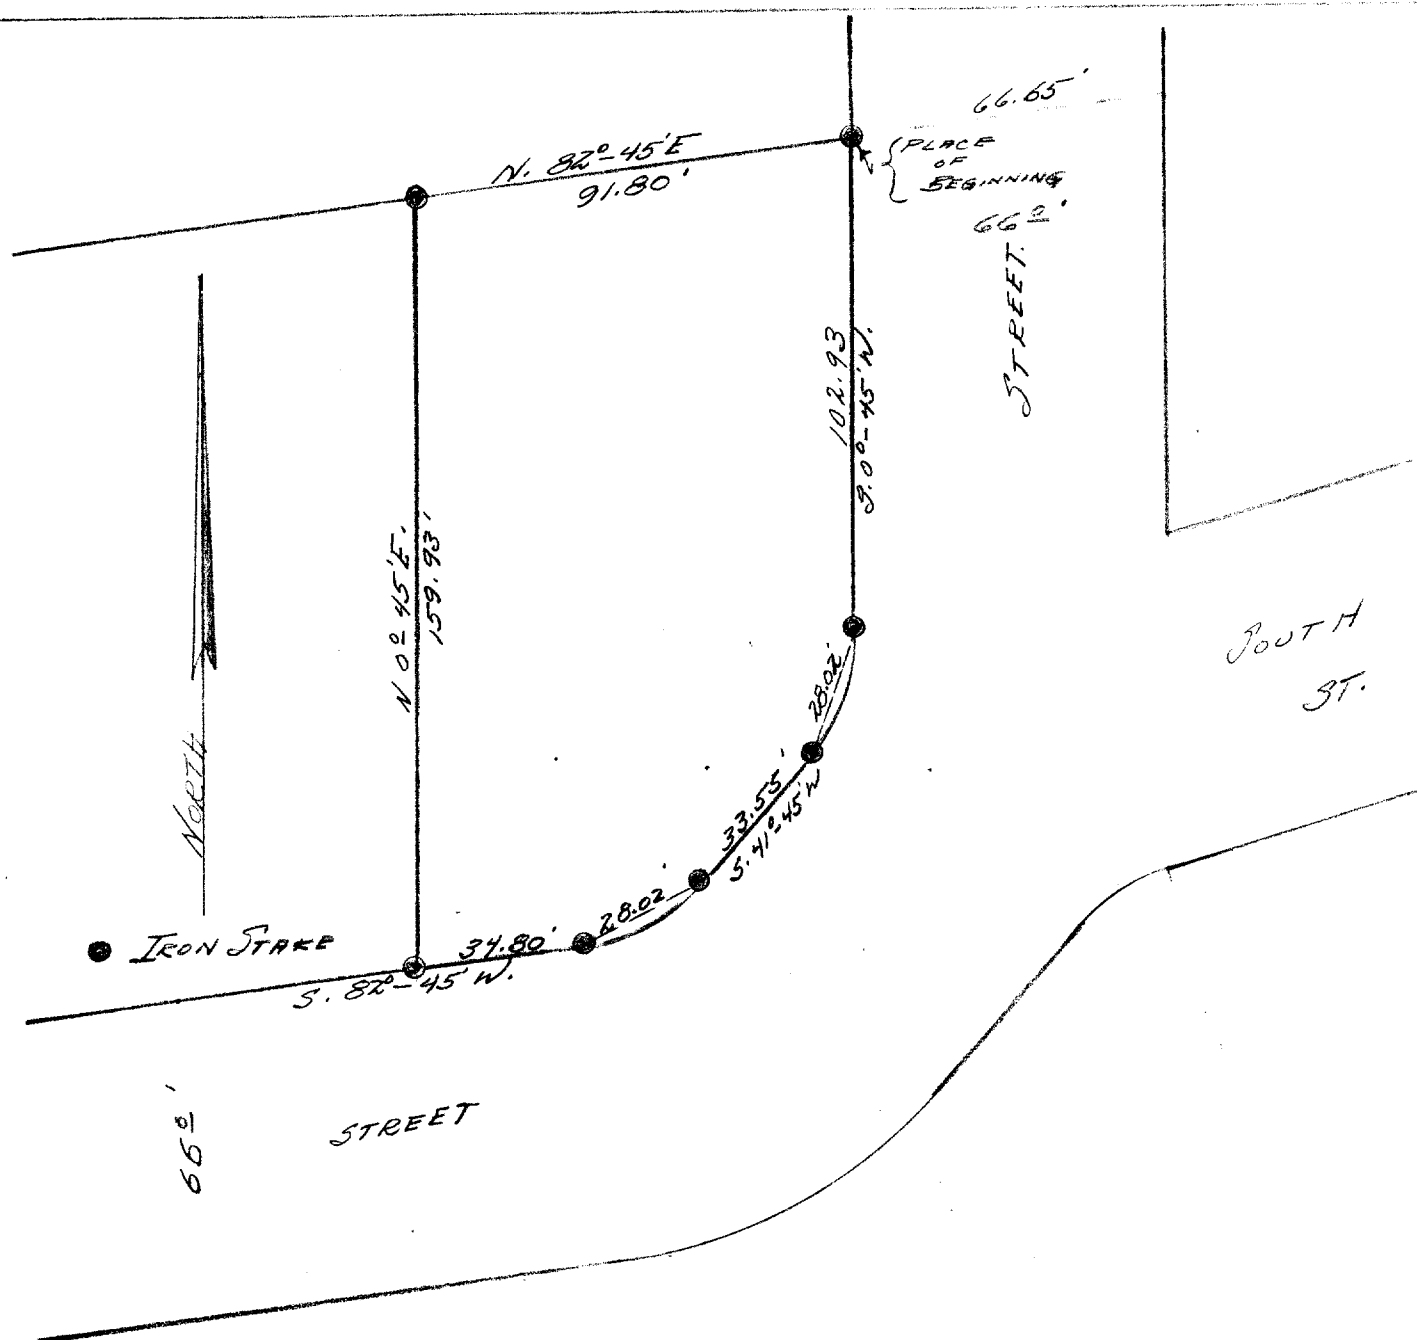

DESCRIPTION:

Commencing at a point that is 582.79 feet South of and 66.65 feet S. 82° 45' W., of the northeast corner of the Northwest quarter of Section 30, Town 4 north, Range 18 east, Walworth County, Wisconsin; thence S. 0° 45' W., 102.93 feet to an iron stake, thence southwesterly along the arc of a curve, (40.00 feet Radius and chord length 28.02 feet) to an iron stake, thence S. 41° 45' W., 33.55 feet to an iron stake, thence southwesterly along the arc of a curve (40.00 feet Radius and chord length 28.02 feet) to an iron stake, thence S. 82° 45' W., 34.80 feet to an iron stake, thence N. 0° 45' E., 159.93 feet to an iron stake, thence N. 82° 45' E., 91.80 feet to the place of beginning.

Description By:

Joseph M. Biagi.
Engineers-Associated
Elkhorn, Wisconsin.