

PLAT OF SURVEY


LOT 21 OF LYNNDALE SUBDIVISION, A SUBDIVISION OF PART OF THE SOUTH 1/2 OF THE NW 1/4 OF SECTION 20, T.43., R.18E., TOWN OF EAST TROY, COUNTY OF WALWORTH, STATE OF WISCONSIN.

SURVEYOR'S CERTIFICATE

I HEREBY CERTIFY THAT THE LANDS DEPICTED HEREON HAVE BEEN SURVEYED UNDER MY DIRECTION AND THAT THE PLAT HEREON DRAWN IS A CORRECT REPRESENTATION OF SAID SURVEY.

— LEGEND —

- FOUND 3/4" DIA IRON PIPE
 - SET 1" DIA. IRON PIPE
 - FOUND 1/4" DIA IRON PIPE
- JOB NO. 77019
SCALE: 1" = 20'
APRIL 1, 1977

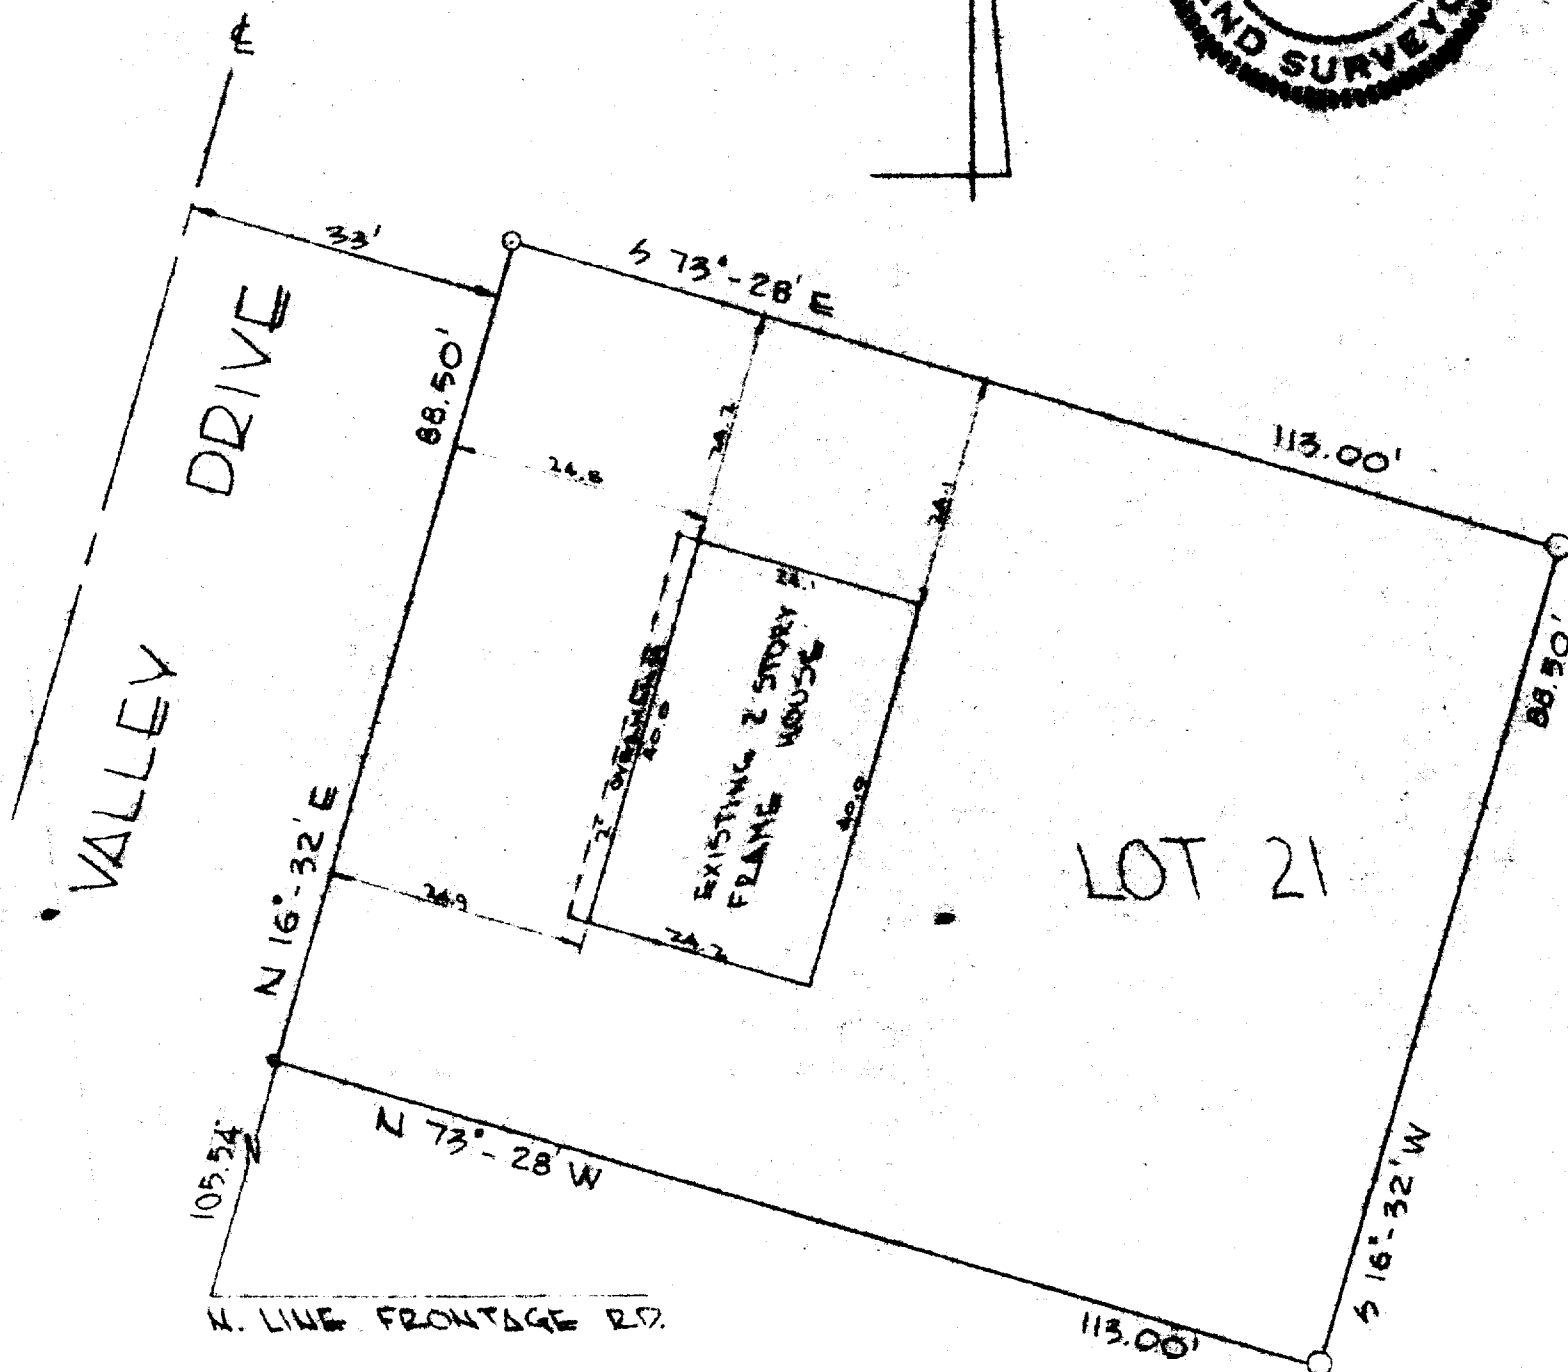

FOR:

GERALD MACKLIN
C-MAC BUILDING
CHURCH & MAIN
EAST TROY, WIS