

# FLAT OF SURVEY

ALL THAT PART OF LOT 6, BLOCK 1, ORIGINAL FLAT OF THE VILLAGE OF EAST TROY, WALWORTH COUNTY, WISCONSIN DESCRIBED AS FOLLOWS: COMMENCE AT THE SW CORNER OF BLOCK 1, RUN THENCE EAST ALONG THE SOUTH LINE OF SAID BLOCK 100.50 FEET TO THE POINT OF BEGINNING OF THE FOLLOWING DESCRIBED PARCEL, THENCE CONTINUE EAST ALONG SAID SOUTH LINE 123.00 FEET TO AN IRON PIPE, THENCE N. 0°-16' W. 136.00 FEET TO A POINT, THENCE WEST PARALLEL TO SAID SOUTH LINE 123.00 FEET TO AN IRON PIPE, THENCE S. 00°-16' E. 136.00 FEET TO THE POINT OF BEGINNING.

SAID PARCEL CONTAINS 16728 SQUARE FEET OF LAND MORE OR LESS.

## SURVEYOR'S CERTIFICATE


I HEREBY CERTIFY THAT THE LANDS DEPICTED HEREON HAVE BEEN SURVEYED UNDER MY DIRECTION AND THAT THE FLAT HEREON DRAWN IS A CORRECT REPRESENTATION OF SAID SURVEY.



## — LEGEND —

- FOUND 3/4" DIA. IRON ROD
  - SET 1" DIA. IRON PIPE
- SCALE: 1" = 30'
- JOB NO. 77018
- DATE: APRIL 4, 1977
- REVISED APRIL 28, 1977

OWNER  
KENNETH PLESS  
2816 SCHOOL ST.  
EAST TROY, WIS  
53120

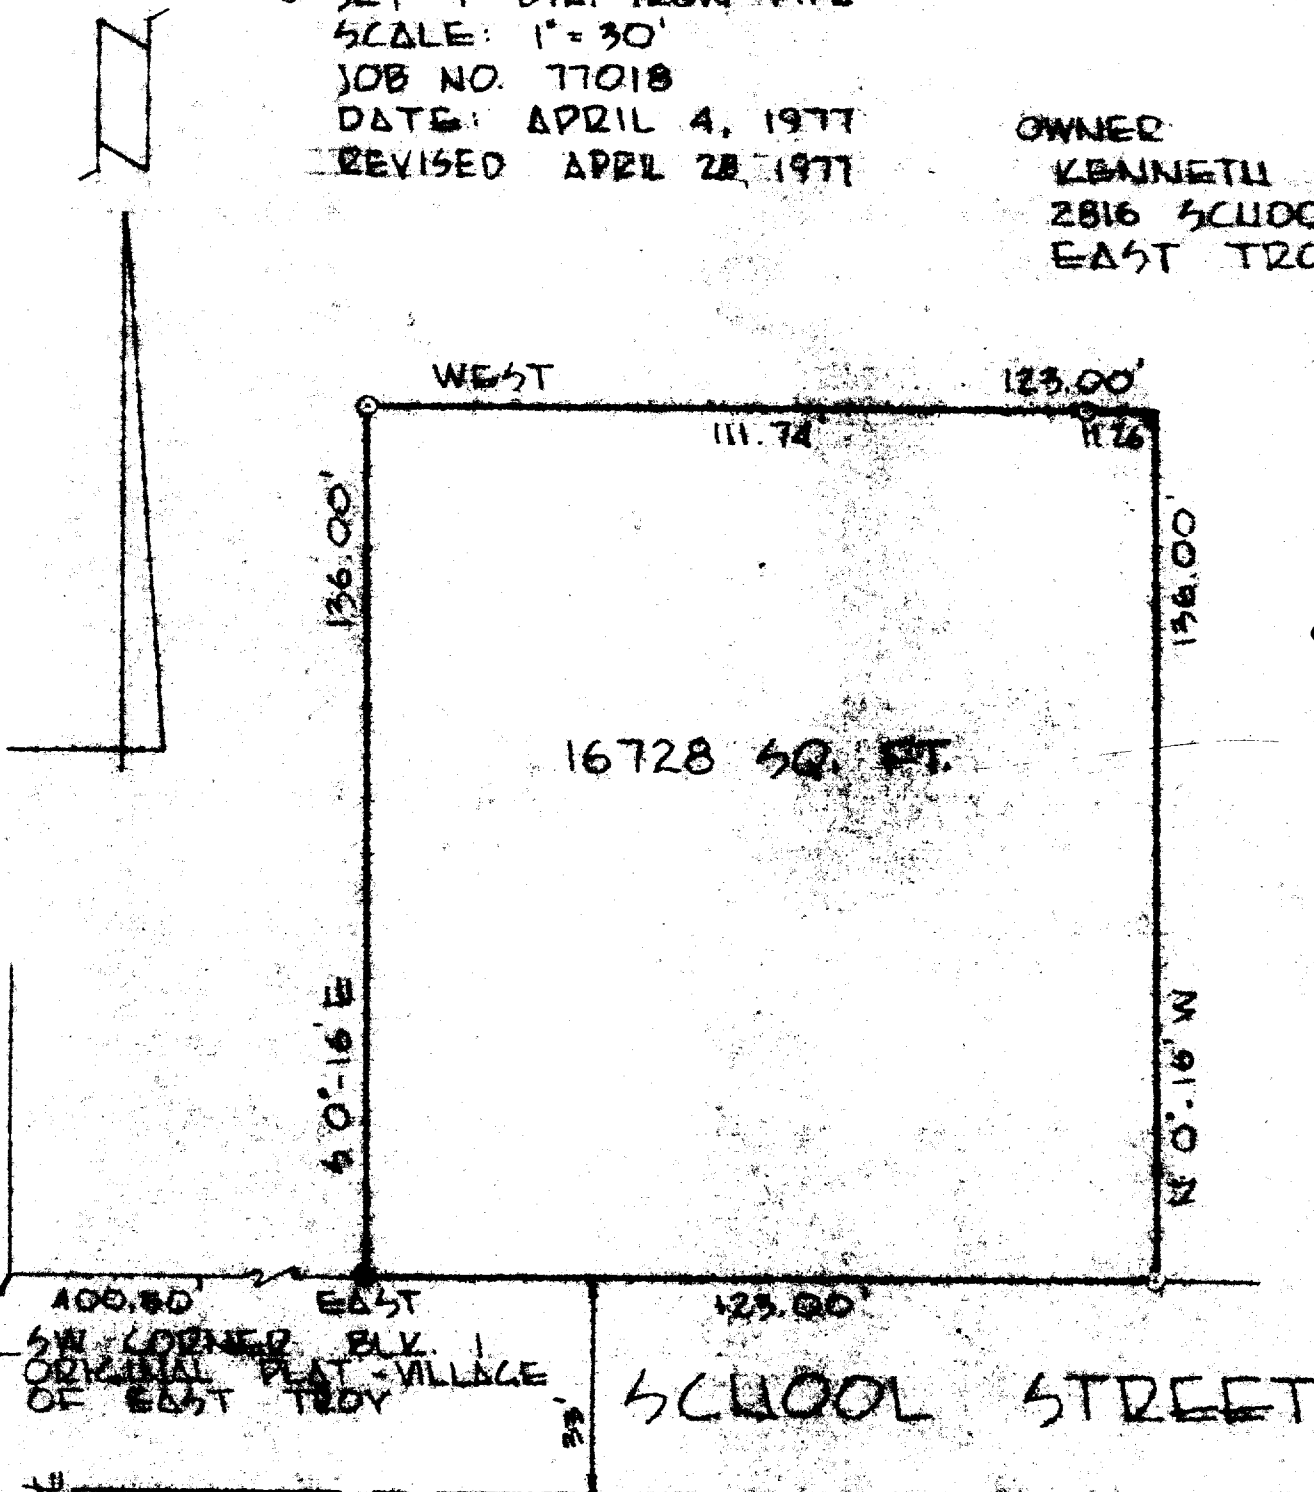

PARCEL WAS SURVEYED FROM LEGAL DESCRIPTION TAKEN FROM SURVEY BY THOMAS P. A. JENSEN, LAND SURVEYOR S-1084, ALBION, WIS., DATED DECEMBER 11, 1975, FURNISHED BY OWNER.

OP-2A  
OP-2 (part of)

3-154