


PLAT OF SURVEY

OF

LAND LOCATED IN THE SE¹/₄ OF SECTION 19, T4N R18E
VILLAGE OF EAST TROY, WAL. CO. WIS.

BEULAH AVE.
66' WIDE

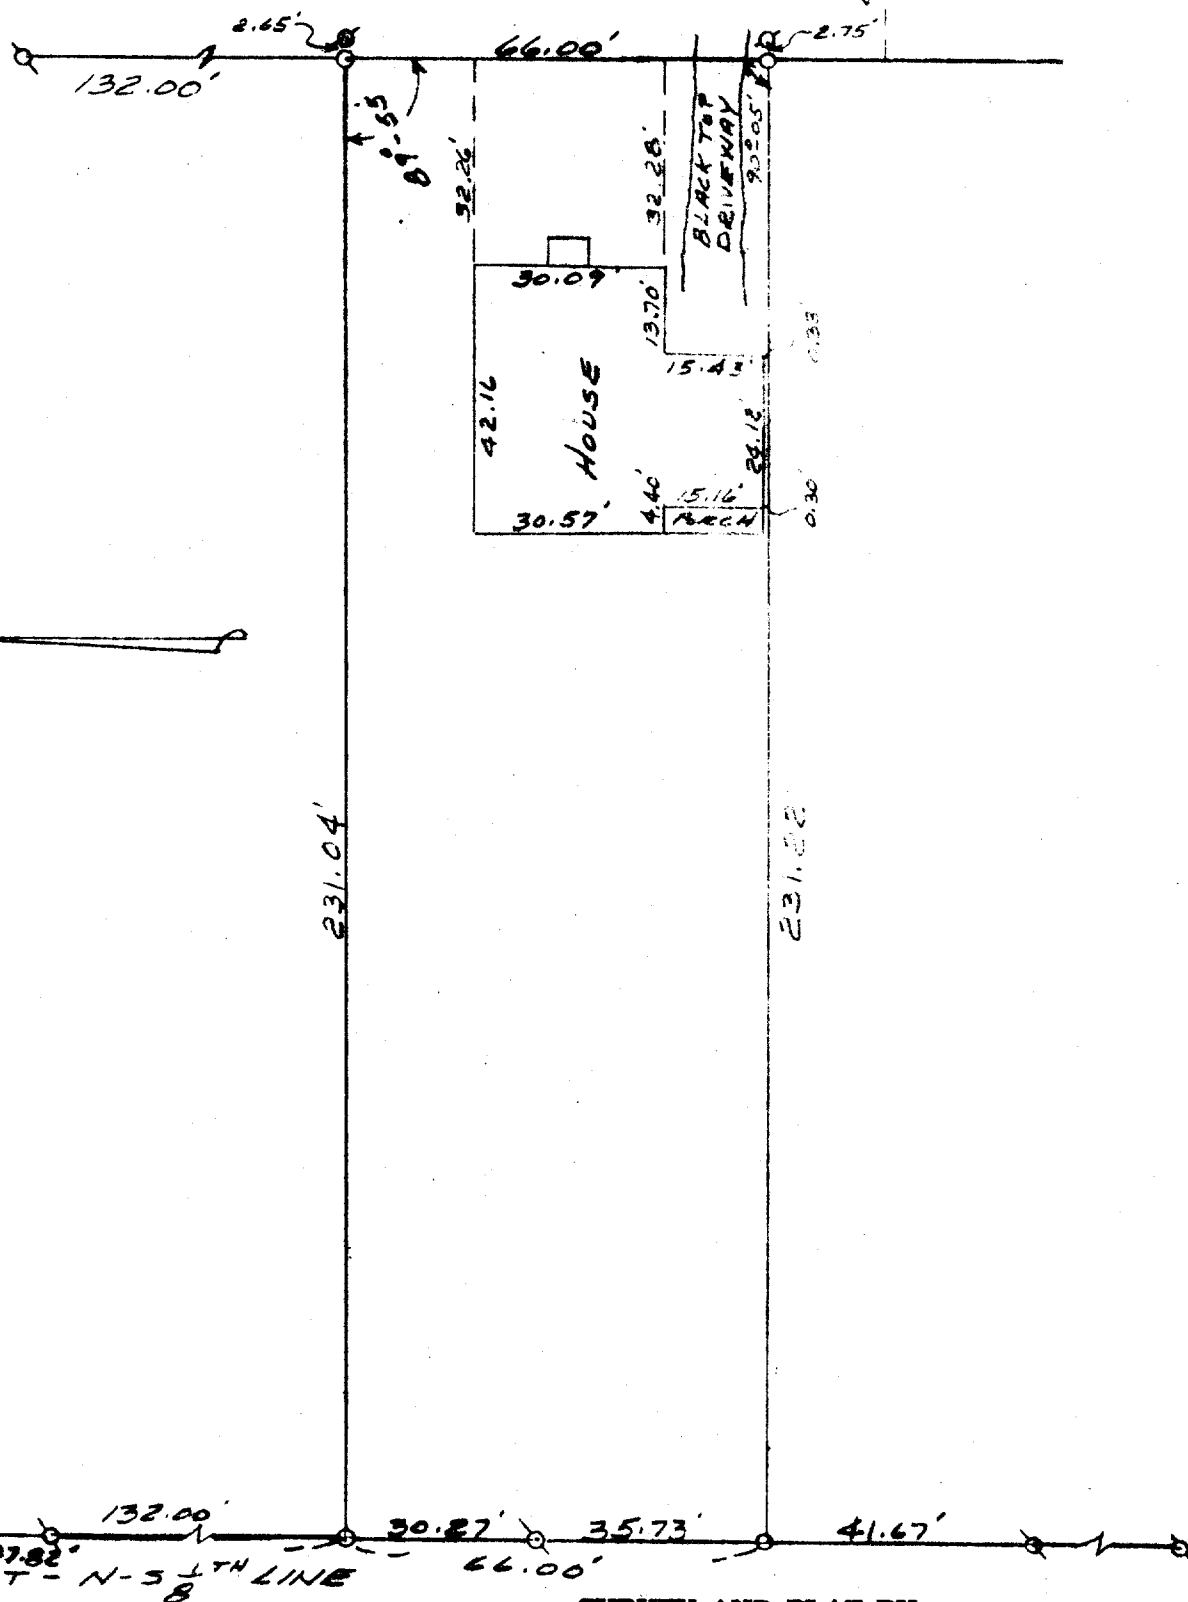

SURVEY AND PLAT BY

JENSEN & JOHNSON, INC.

CIVIL ENGINEERS AND SURVEYORS

Elkhorn, Wisconsin

LEGEND

- — Iron Pipe SET
- — Concrete Monument
- Scale 1" = 30'
- — IRON PIPE FOUND

WE CERTIFY: That we have surveyed the above described property and that the plat shown hereon is an accurate survey and a true representation thereof and correctly shows the exterior boundary lines and all divisions of said property, AND THE LOCATION OF ALL BUILDINGS.

Date SEPT. 1968

Lloyd L. Jensen
LOYD L. JENSEN,

Wisconsin Registered Land Surveyor, No. S-211