


PLAT OF SURVEY

LOT 34, EXCEPTING THE WEST 61.00 FEET, MOORE'S VILLAGE GRAPES, A S. DIVISION OF PART OF THE NW 1/4 OF THE NW 1/4 AND THE SW 1/4 OF THE NW 1/4, SECTION 34; ALL PARTS OF THE NE 1/4 OF THE NW 1/4 AND THE SE 1/4 OF THE NW 1/4, SECTION 30; ALL IN T.T.M., S.12E., OF THE 4TH P.M., VILLAGE OF EAST TROY, ALFORTH COUNTY, WISCONSIN.

SURVEYOR'S CERTIFICATE


I HEREBY CERTIFY THAT THE LANDS DEPICTED HEREON HAVE BEEN SURVEYED UNDER MY DIRECTION AND THAT THE PLAT HEREON DRAWN IS A CORRECT REPRESENTATION OF SAID SURVEY.

GREGORY A. RUSMAN
LAND SURVEYOR S-1019
KANSASVILLE, WIS.

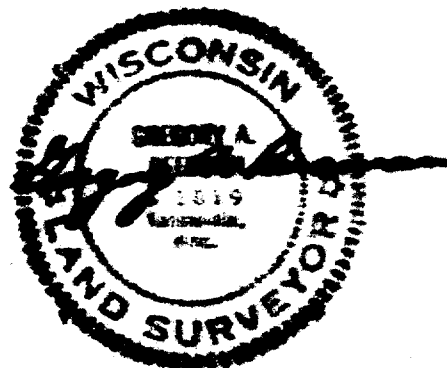

— LEGEND —

- FOUND 2" DIA. IRON PIPE
 - FOUND 1" DIA. IRON PIPE
 - SET 1" DIA. IRON PIPE
- SCALE: 1" = 30'
JOB NO. 77035
DATE: MAY 3, 1977

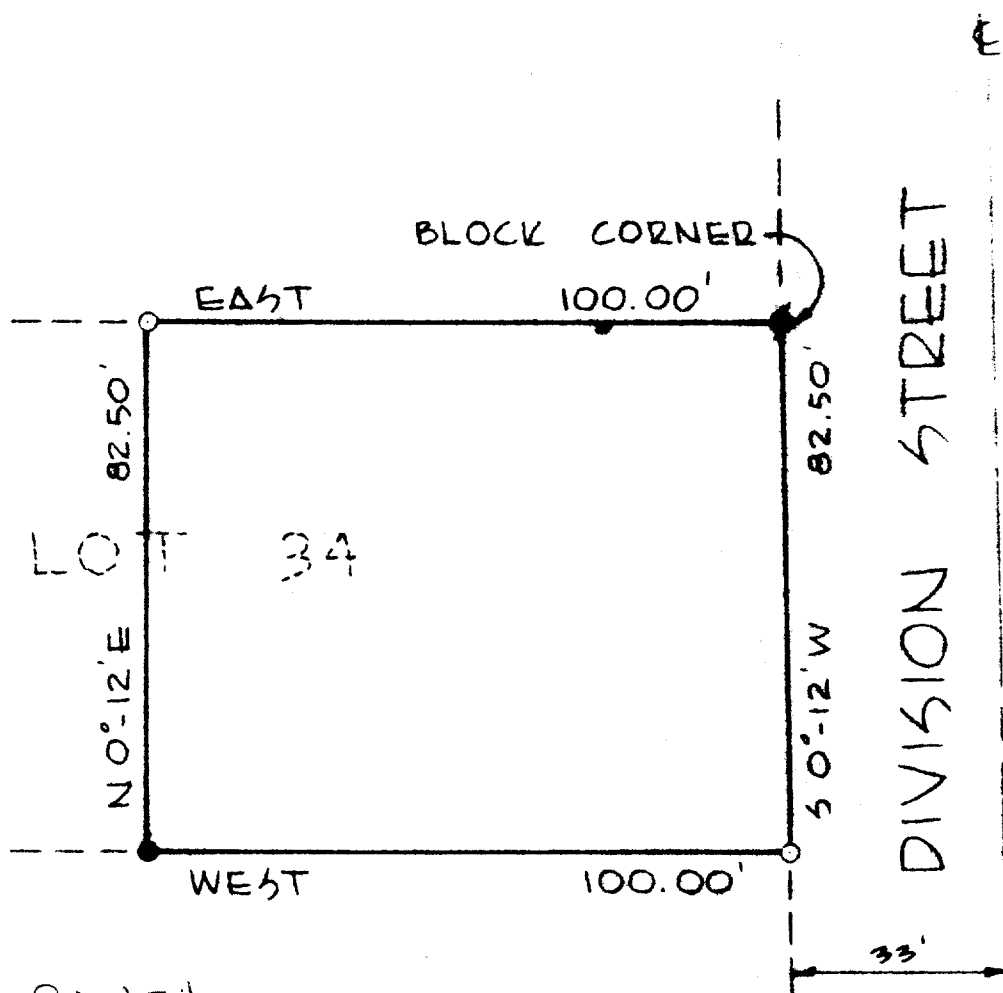

FOR:
C-MAC BUILDING, INC.
CLUZCE & MAIN
EAST TROY, WIS.

RMV-34

3-157