


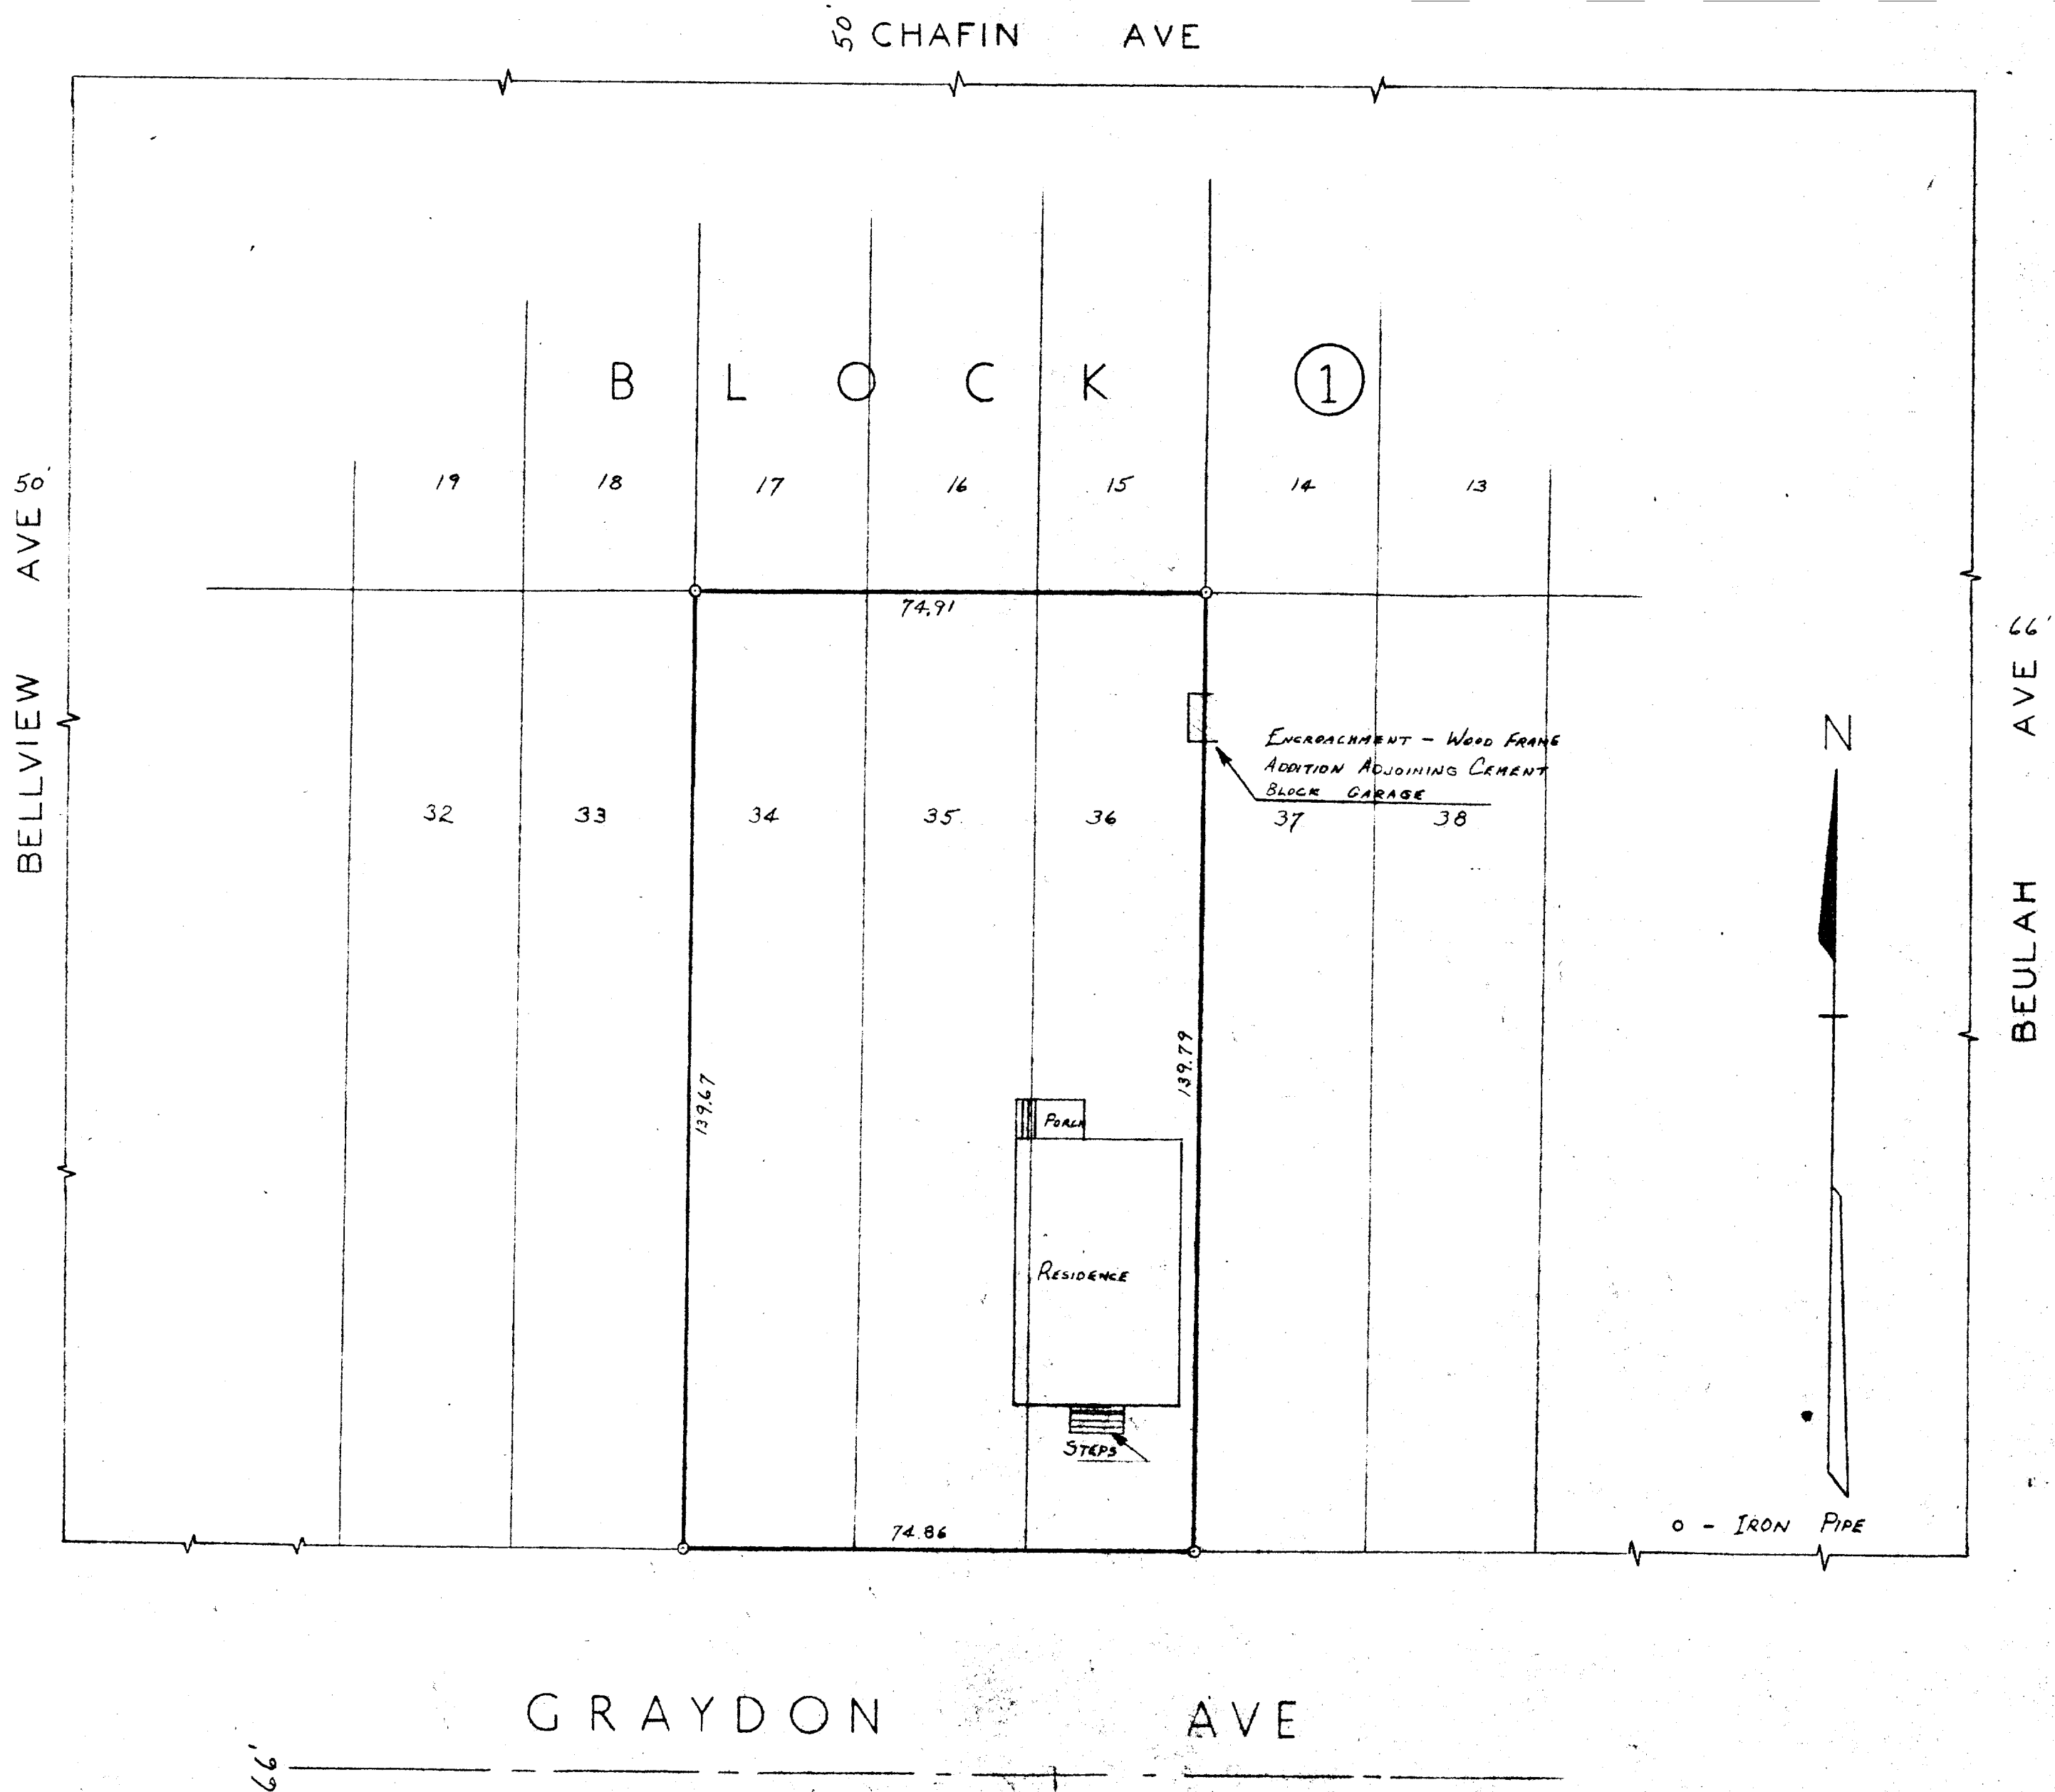

PLAT OF SURVEY OF

LOTS 34, 35, & 36

BLOCK 1 OF
CLARKS ADDITION TO THE
VILLAGE OF EAST TROY,
WALWORTH COUNTY, WISC.

[Signature]

SCALE 1" = 20'

DATE AUGUST 1923

RCA-12

3-167