

FARRIS, HANSEN & COOPER, INC.

WARREN E. HANSEN
PROFESSIONAL ENGINEER

ENGINEERING, SURVEYING AND LAND PLANNING
718 W. WALWORTH ST. - P.O. BOX 487 - ELKHORN, WI 53121
OFFICE: 414/723-2098


DANIEL D. COOPER
ROBERT A. FARRIS
LAND SURVEYOR

ENGINEERING
MUNICIPAL - STRUCTURAL
HIGHWAYS - PUBLIC WORKS

SURVEYING & PLANNING
SUBDIVISIONS - LOT SURVEYS
CONSTRUCTION STAKING - MAPPING

MORTGAGE INSPECTION SURVEY

The North 15 Feet of Lot 2 & The South 51 Feet of Lot 3, Block 4, S.B. Edwards Addition, Village of East Troy, Walworth County, Wisconsin.

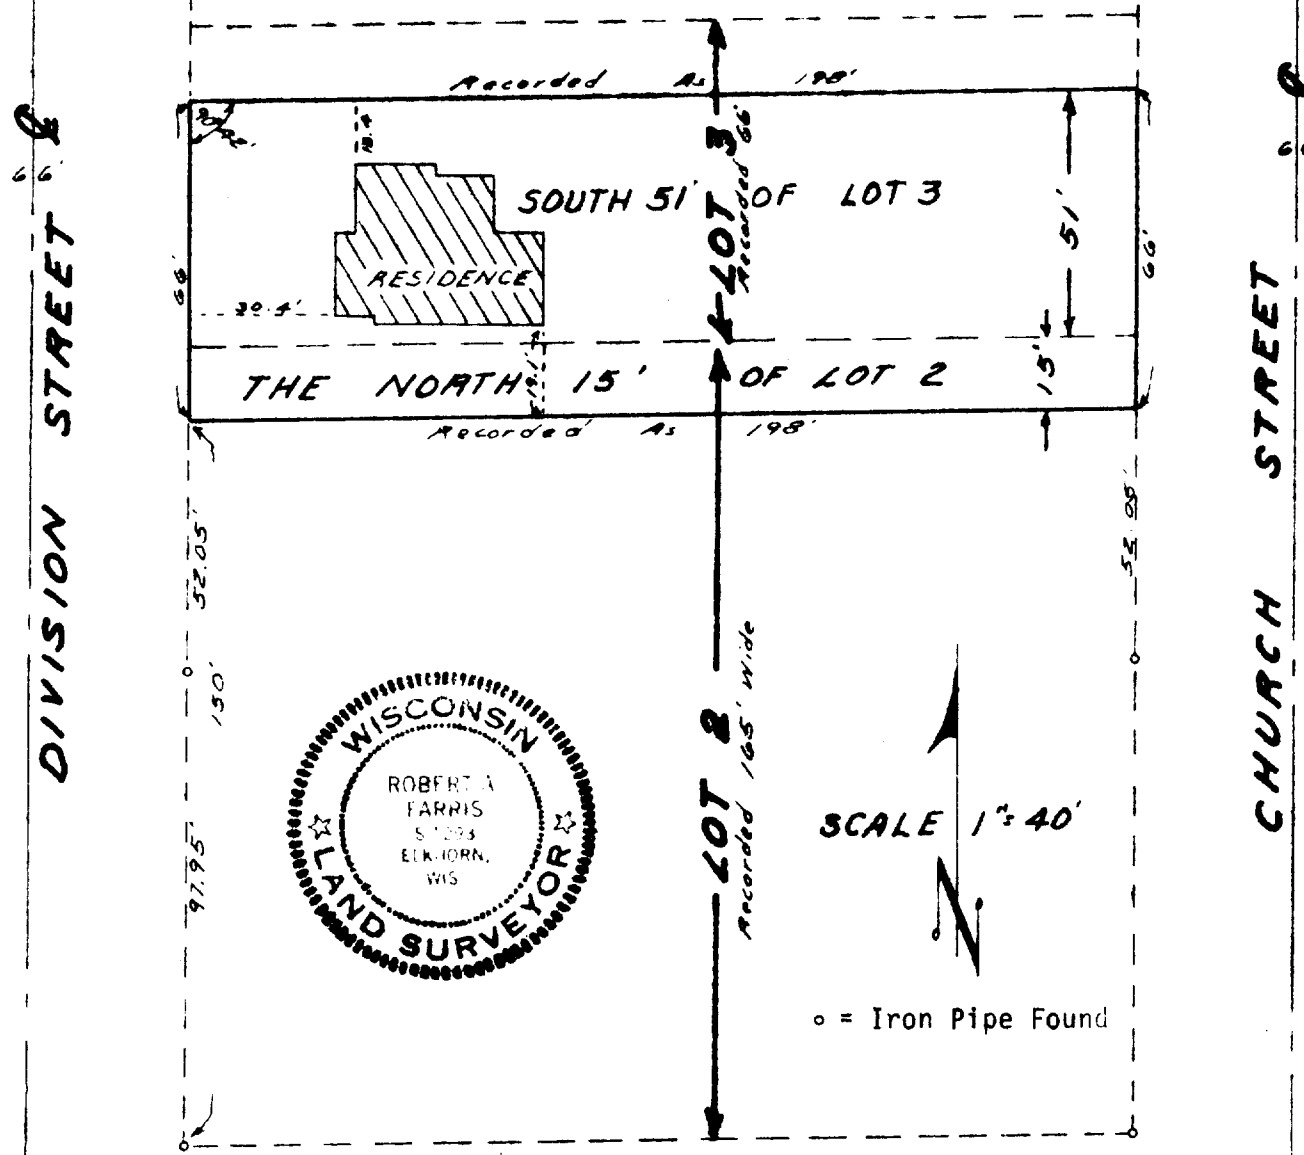

NOTE: THIS IS NOT A "PROPERTY SURVEY" AS DEFINED IN SEC. AE-5.01 OF THE WISCONSIN ADMINISTRATIVE CODE.

Buyer: Daniel S. & Anita A. Opgenorth
Sellers: George H. & Mary Jane Blucher

Address: 1986 North Division Street
East Troy, WI 53120

Ordered By: Sandra J. Butler
for Waukesha Savings & Loan.

I HEREBY CERTIFY that this map is a true representation of the Lot Lines and the building located thereon to the best of my knowledge and belief.

Dated This 8th Day of August, 1978.

Robert A. Farris
Robert A. Farris, RLS

3-192

EA-38

DRWG. NO. 1376