


BUILDING LOCATION SURVEY



LEGEND

● FOUND IRON PIPE

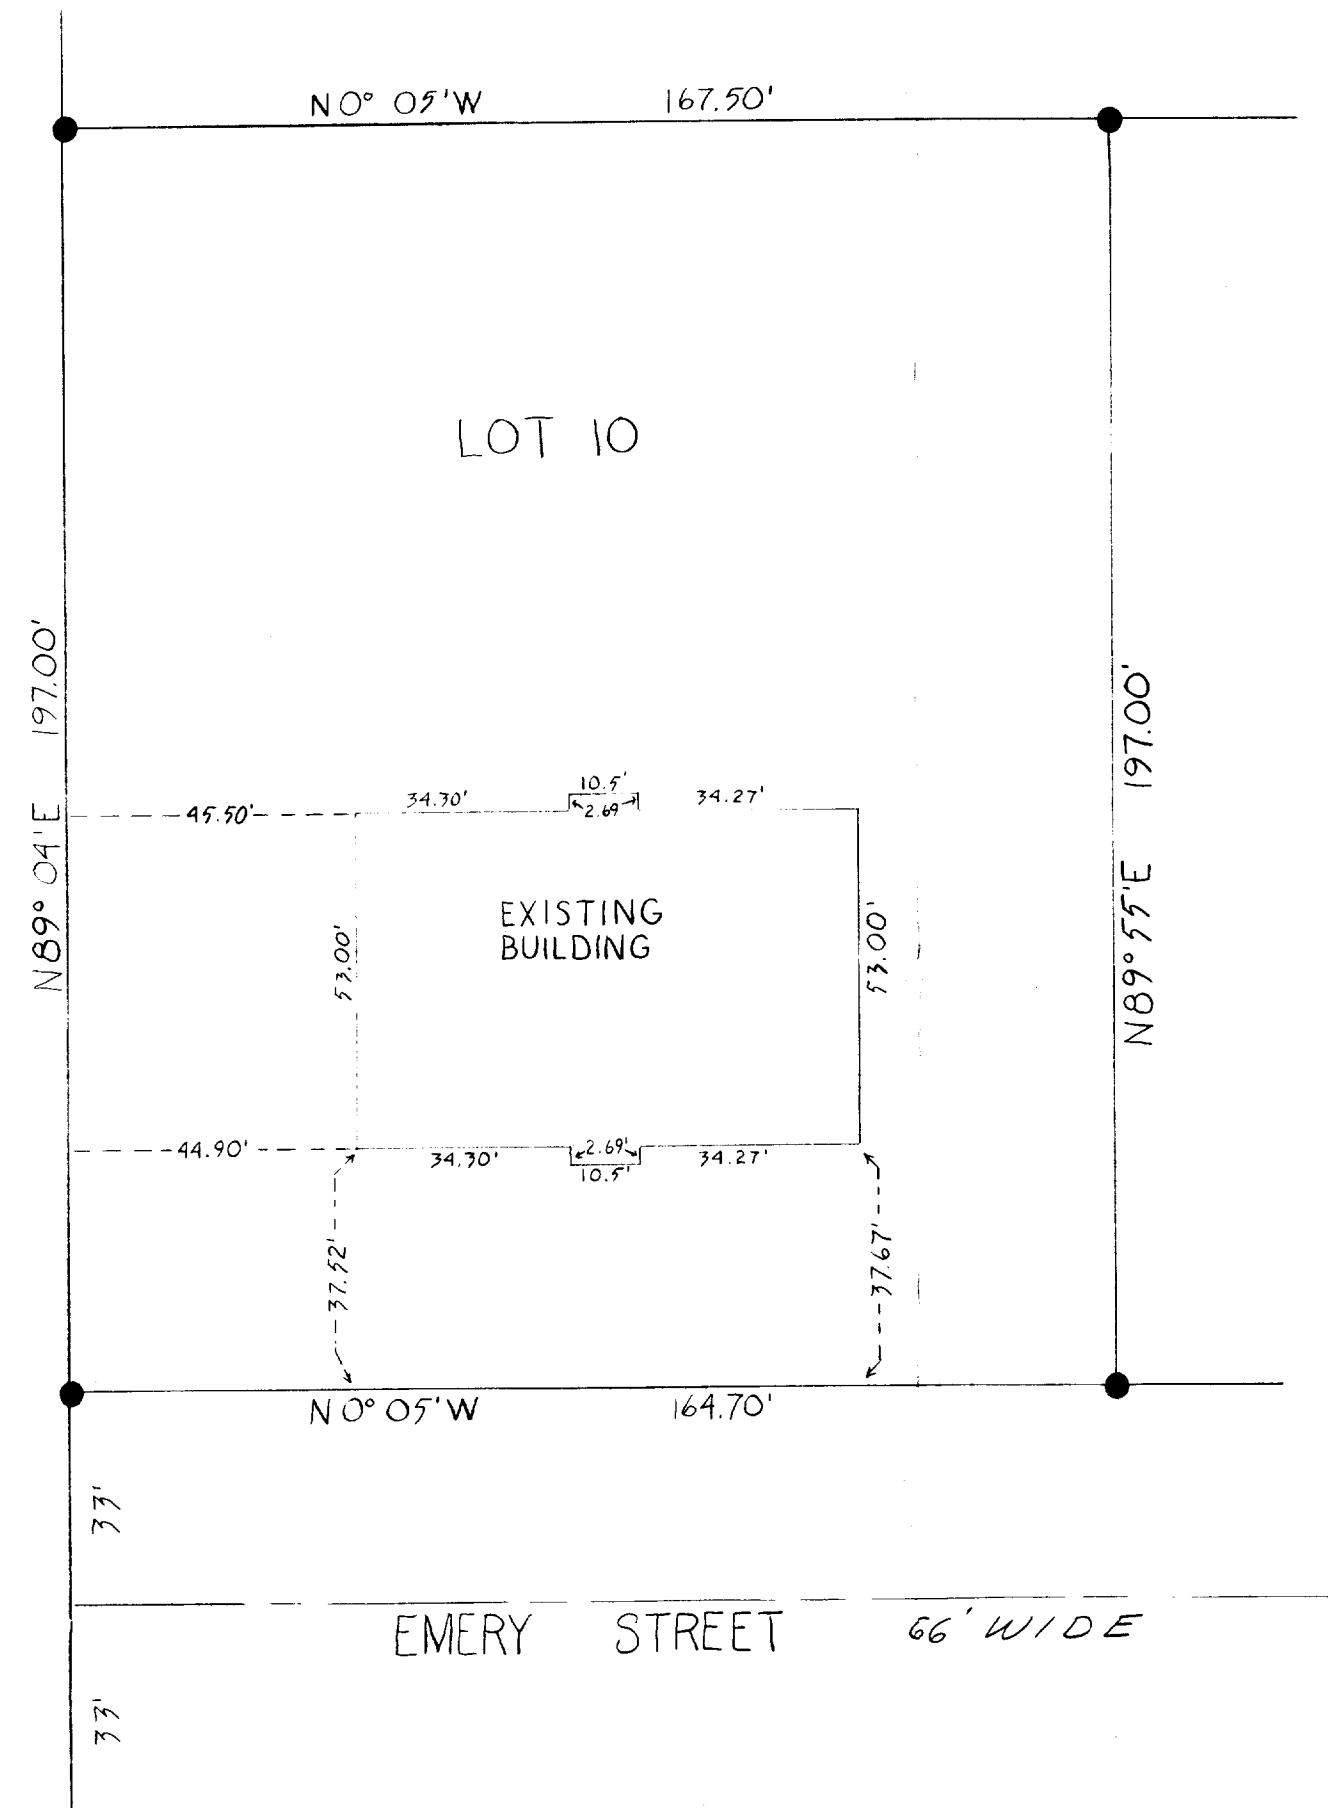


LOCATED IN LOT 10 OF TROYJENS
APARTMENTS, VILLAGE OF EAST TROY,
WALWORTH COUNTY, WISCONSIN

Surveyors Certificate

I, WILLIAM A. SHEARMAN, REGISTERED LAND SURVEYOR, DO HEREBY CERTIFY THAT THE EXISTING BUILDING LOCATION SHOWN HEREON IS A CORRECT REPRESENTATION AND HAS BEEN SURVEYED UNDER MY DIRECTION AND TO THE BEST OF MY KNOWLEDGE AND BELIEF.

William A. Shearman DATED THIS 15 DAY OF JULY, 1978
WILLIAM A. SHEARMAN
REGISTERED LAND SURVEYOR S-1378

JENSEN & JOHNSON
ENGINEERS AND SURVEYORS
PO BOX 290, ELKHORN, WISCONSIN
414-723-3204
A Division of
Donohue & Associates, Inc.

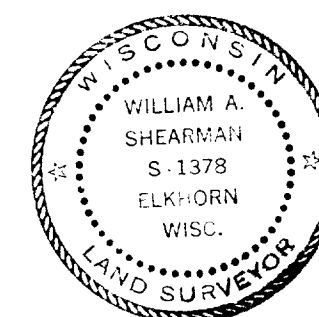

Date 6-13-78	Scale 1" = 30'
Drawn By D.J.H.	Surveyed For JOHNSON REALTY
Checked By W.A.S.	Project No. 1658.286