


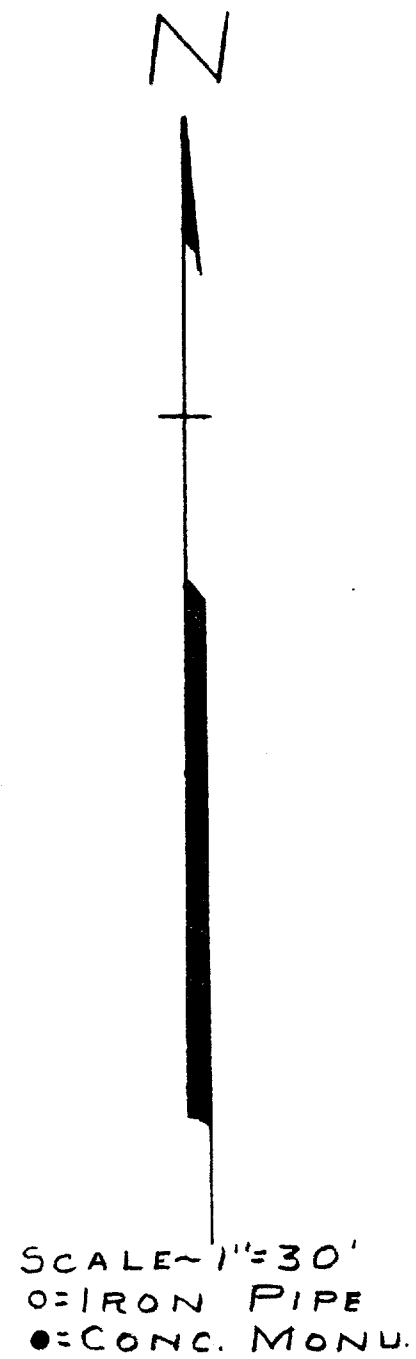


PLAT OF SURVEY OF A PARCEL OF LAND LOCATED IN THE
NORTHWEST 1/4 OF SECTION 29, T4N R18E, VILLAGE OF
EAST TROY, WALWORTH COUNTY, WISCONSIN
NOV. 1955

George T. Dunham
GEORGE T. DUNHAM, SURVEYOR
DELAVER, WISCONSIN.

NE. CORNER LOT 4, BLOCK
13 OF THE PLAT OF THE
ORIGINAL VILLAGE OF EAST TROY

NORTH LINE OF SECTION 29,
T 4 N R 18 E

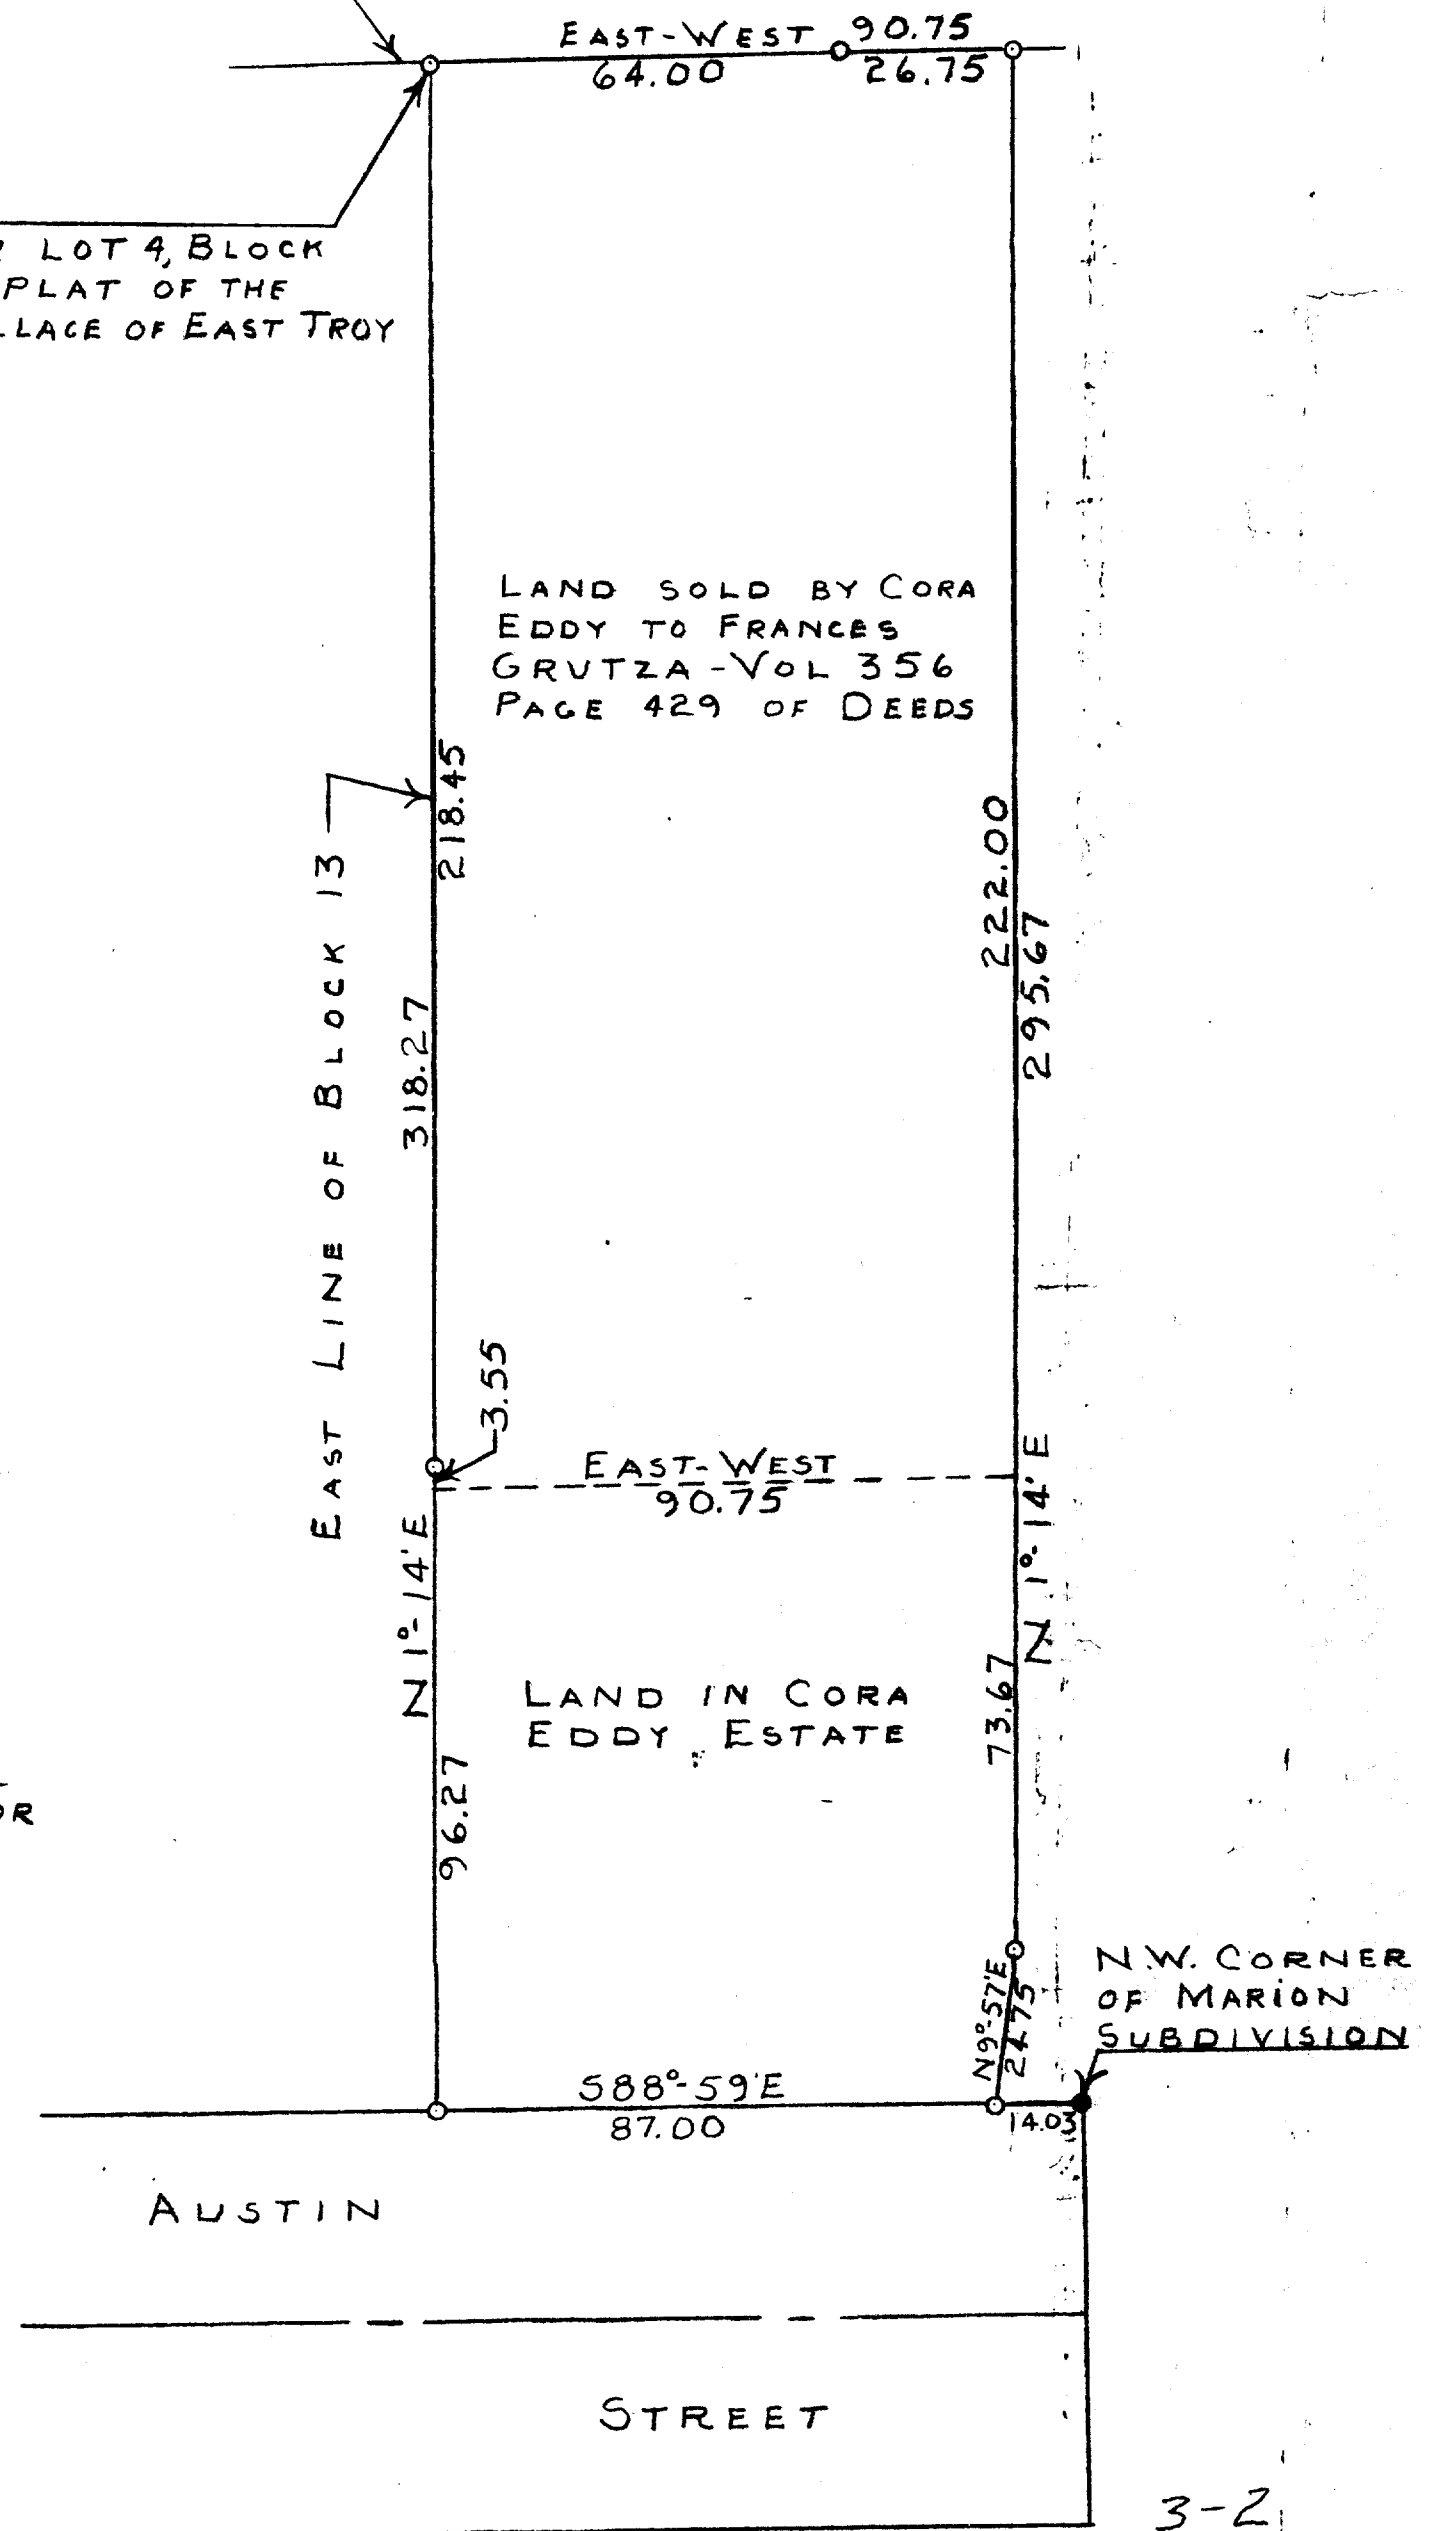

REPL. 1-2-1-3
UP-163