

PLAT OF SURVEY
-of-

- A) A parcel of land located in the N. W. $\frac{1}{4}$ of section 29 Town 4 North, Range 18 East of Walworth County, Wisconsin, and described as follows, to-wit: Commencing at the N. E. corner of Block 14 of the Original Plat of the Village of East Troy; thence E. 20 feet to the place of beginning thence continue E. 82.5 feet to a concrete monument; thence S. parallel to the E. line of said Block 14, 107 feet to an iron pipe; thence W. 82.5 feet to an iron pipe; thence N. 107 feet to an iron pipe at the place of beginning,


Also known as the North 107 feet of Lot 1 of the Marion Subdivision as recorded in Vol. 10 of Plats on page 50 #383983 on Jan. 24, 1946.

- B) The South 25 feet of Lot 1 of Marion Subdivision according to the recorded plat in Vol. 10 of Plats on page 50. Subject to 10 foot walkway reserved for sidewalk as shown on Plat.

Survey for: Great American Funding Corp.

NOTE: Subject to easements of record.

Buyer: Mrs. Rogers

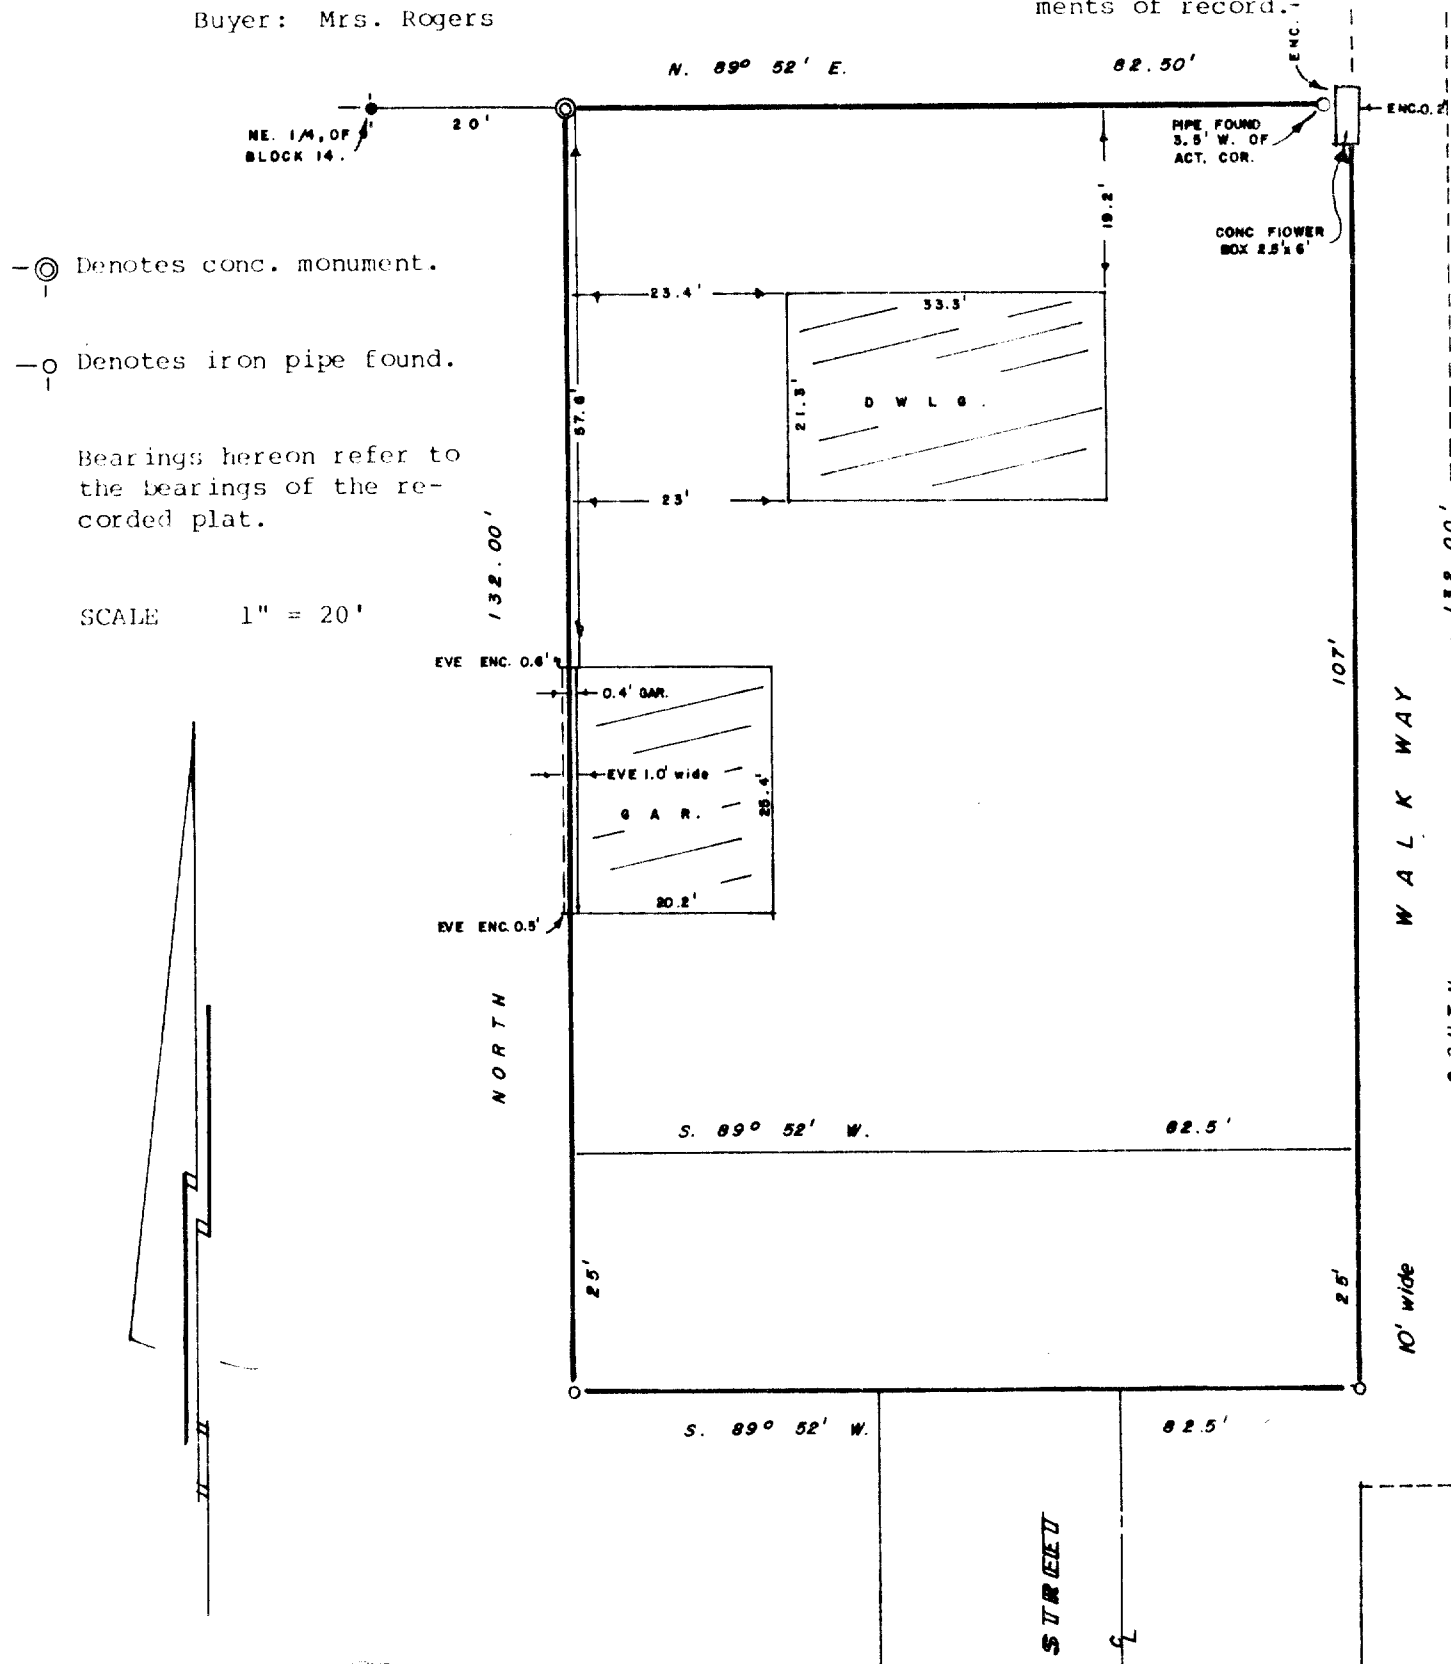

I Certify that I have surveyed the described property and the above map is a true representation thereof and shows the size and location of the property, its exterior boundaries, the location and dimensions of all visible structures thereon, fences, apparent easements and roadways and visible encroachments, if any.

This survey is made for the exclusive use of present owners of property, and also those who purchase, mortgage or guaranty the title thereto within one (1) year from date hereof.

Robert L. Sternberg
Registered Land Surveyor

9-12-79
Date

79293
Job No.



3-217