


PLAT OF SURVEY OF THE EAST 66 FEET OF LOT 11, BLK B, EXCEPT THE
NORTH 37' AND THE SOUTH 204.76' OF LENCK'S PARK ADDITION
TO THE VILLAGE OF EAST TROY, WALWORTH COUNTY, WISCONSIN

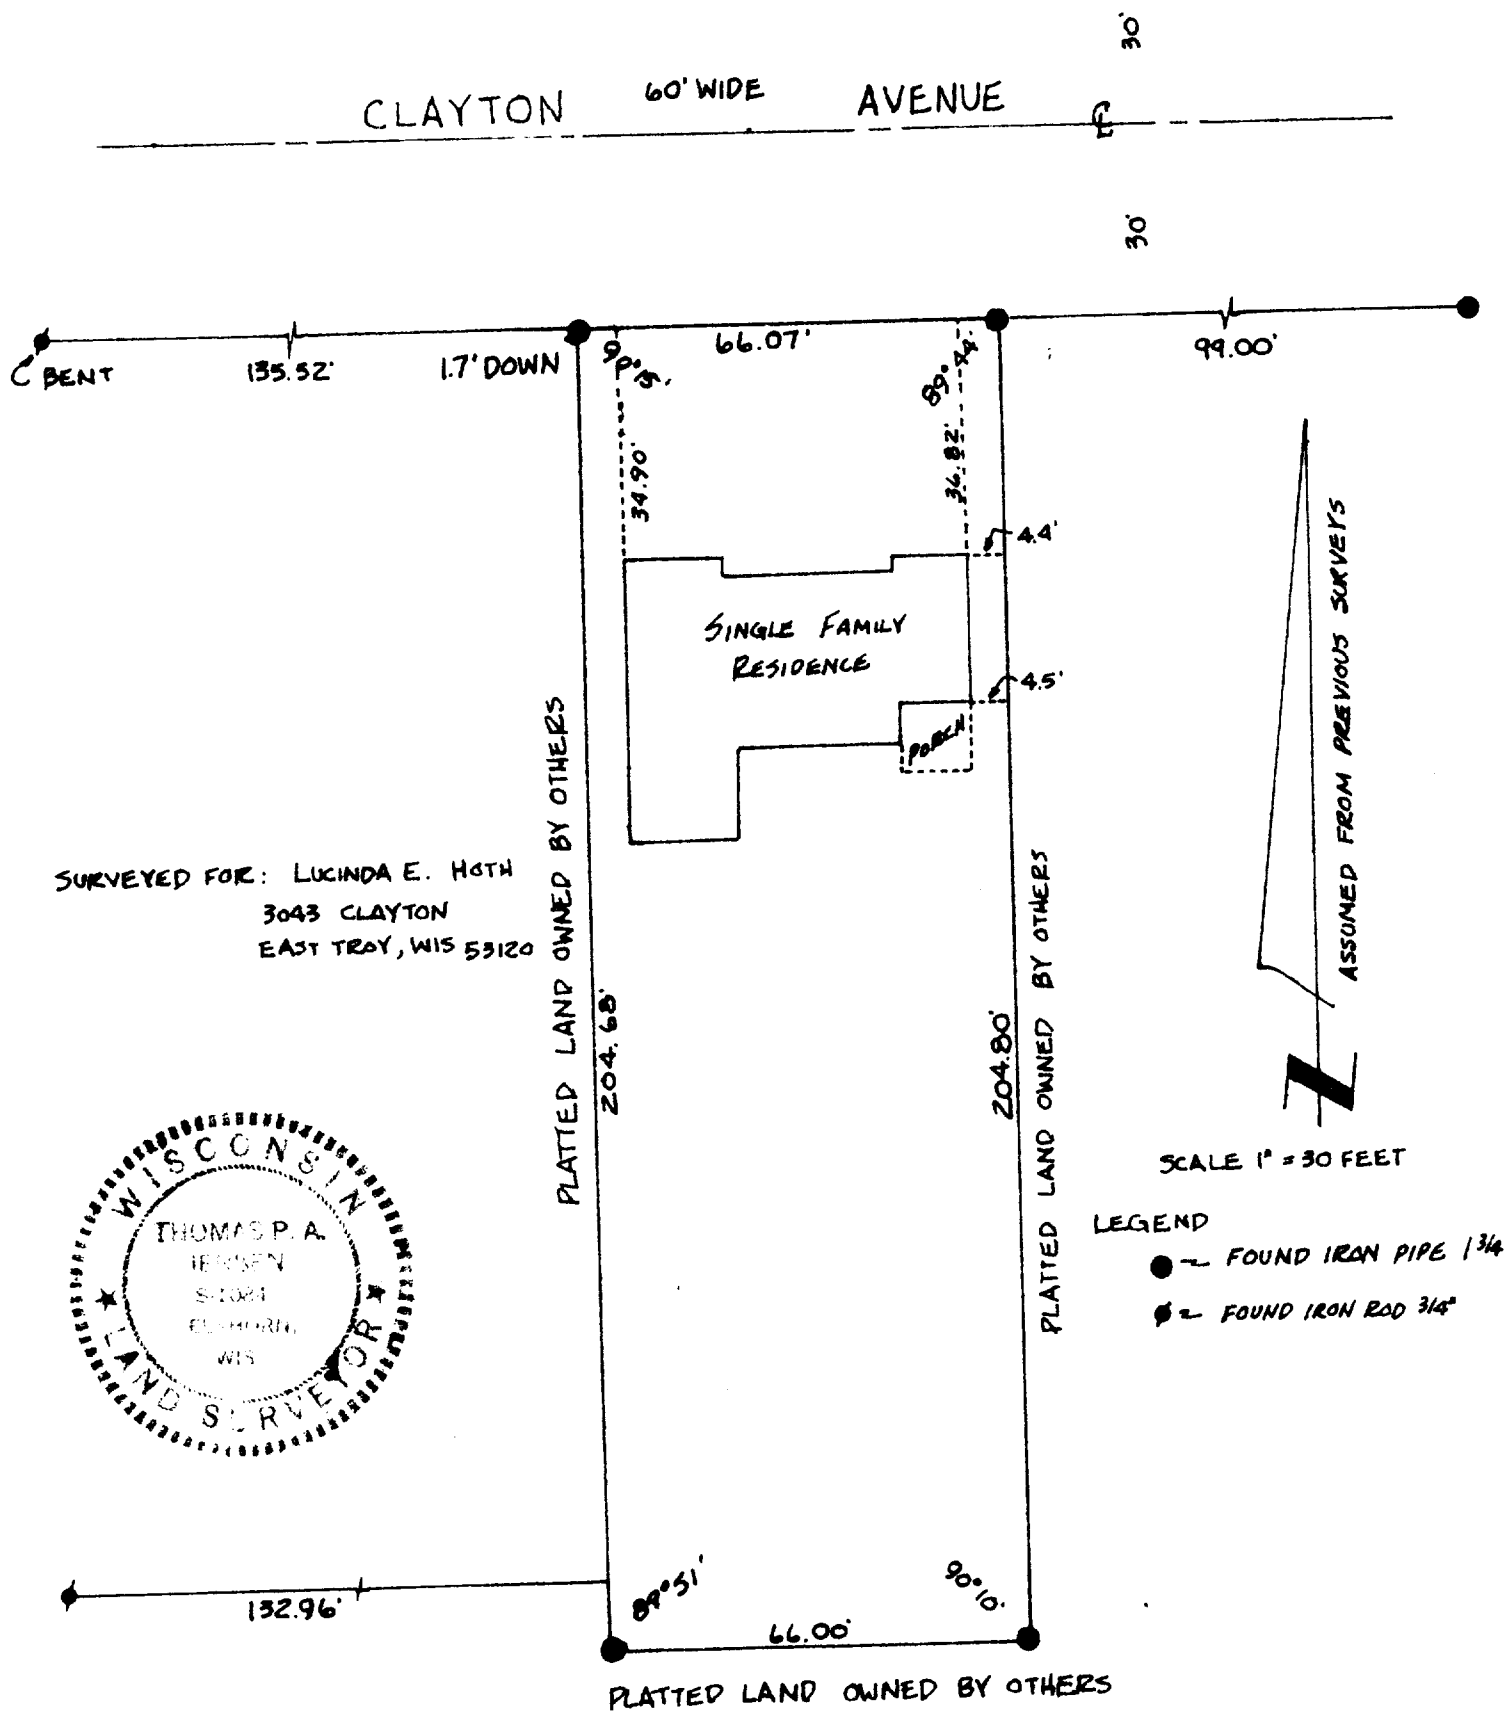

I HEREBY CERTIFY THAT THE ABOVE DESCRIBED PROPERTY HAS BEEN SURVEYED UNDER
MY DIRECTION AND THAT THE PLAT HEREON DRAWN IS A CORRECT REPRESENTATION OF SAID
SURVEY AND CORRECTLY SHOWS THE EXTERIOR BOUNDARIES AND DIVISIONS AND IMPROVEMENTS
OF SAID PROPERTY

DATED THIS 7TH DAY OF AUGUST 1979

Thomas P. A. Jensen

THOMAS P. A. JENSEN S-1084
REGISTERED WISCONSIN LAND SURVEYOR
JENSEN SURVEYING & MAPPING, ELKHORN, WIS. 53121
#723-3434