
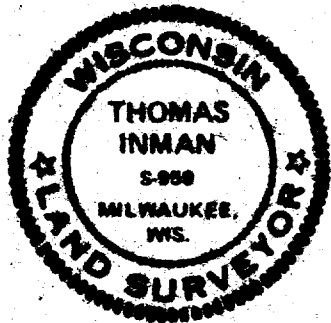


SURVEY FOR: Knutson Mortgage
LOCATION: 2951 South Street

Plat of Survey

James Knilians

DESCRIPTION: All that part of the Northeast 1/4 of Section 30, in Township 4 North, Range 18 East, in the Village of East Troy, bounded and described as follows: Commencing at the Northwest corner of Lot 5 of H.F. EBERT'S Subdivision being a subdivision of said Northeast 1/4 of Section 30, thence South 16 1/2 feet to the point of beginning; thence continue South along the West line of said Lot 5 to the Southwest corner of said Lot 5; thence West 66 feet; thence North 148.5 feet; thence East 66 feet to the place of beginning. All situated in the County of Walworth, State of Wisconsin.

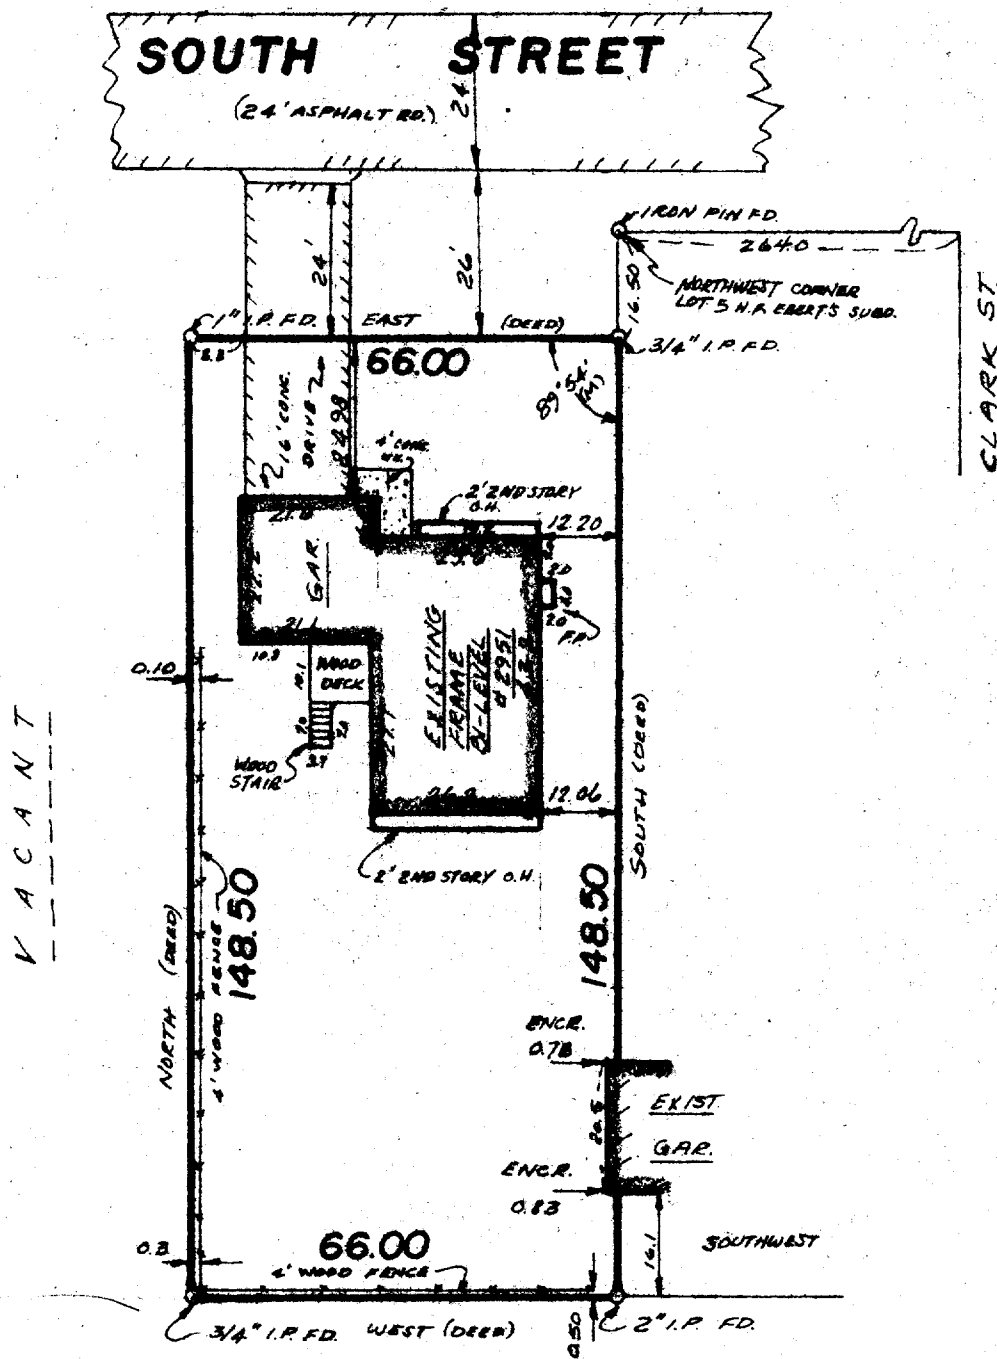

INMAN SURVEY

Scale: 1" = 30'

WEST OFFICE:
P.O. BOX 286
EAST TROY, WI 53120
(414) 642-3113

EAST OFFICE:
11221 W. FOREST HOME AVE.
MILWAUKEE, WI 53130
(414) 428-2080

SURVEY CERTIFICATE

State of Wisconsin)
Milwaukee County ss I certify that I have surveyed the above described (property) and the above map is a true representation thereof and shows the size and location of the Property, its exterior boundaries, the location and dimensions of all visible structures thereon, fences, apparent easements and roadways and visible encroachments, if any.

This survey is made for the exclusive use of the present owners of the Property, and also those who purchase, mortgage, or guarantee the title thereto within one (1) year from date hereof;

THOMAS INMAN, Registered Land Surveyor

DATE: 3/12/80
JOB NO.: 8224

XUP-191A

3-219