


PLAT OF SURVEY

OF

LAND LOCATED IN THE EAST $\frac{1}{2}$ - NORTHEAST $\frac{1}{4}$
SECTION 30, T4N-R10E, WALWORTH COUNTY, WIS.

AUSTIN ST.

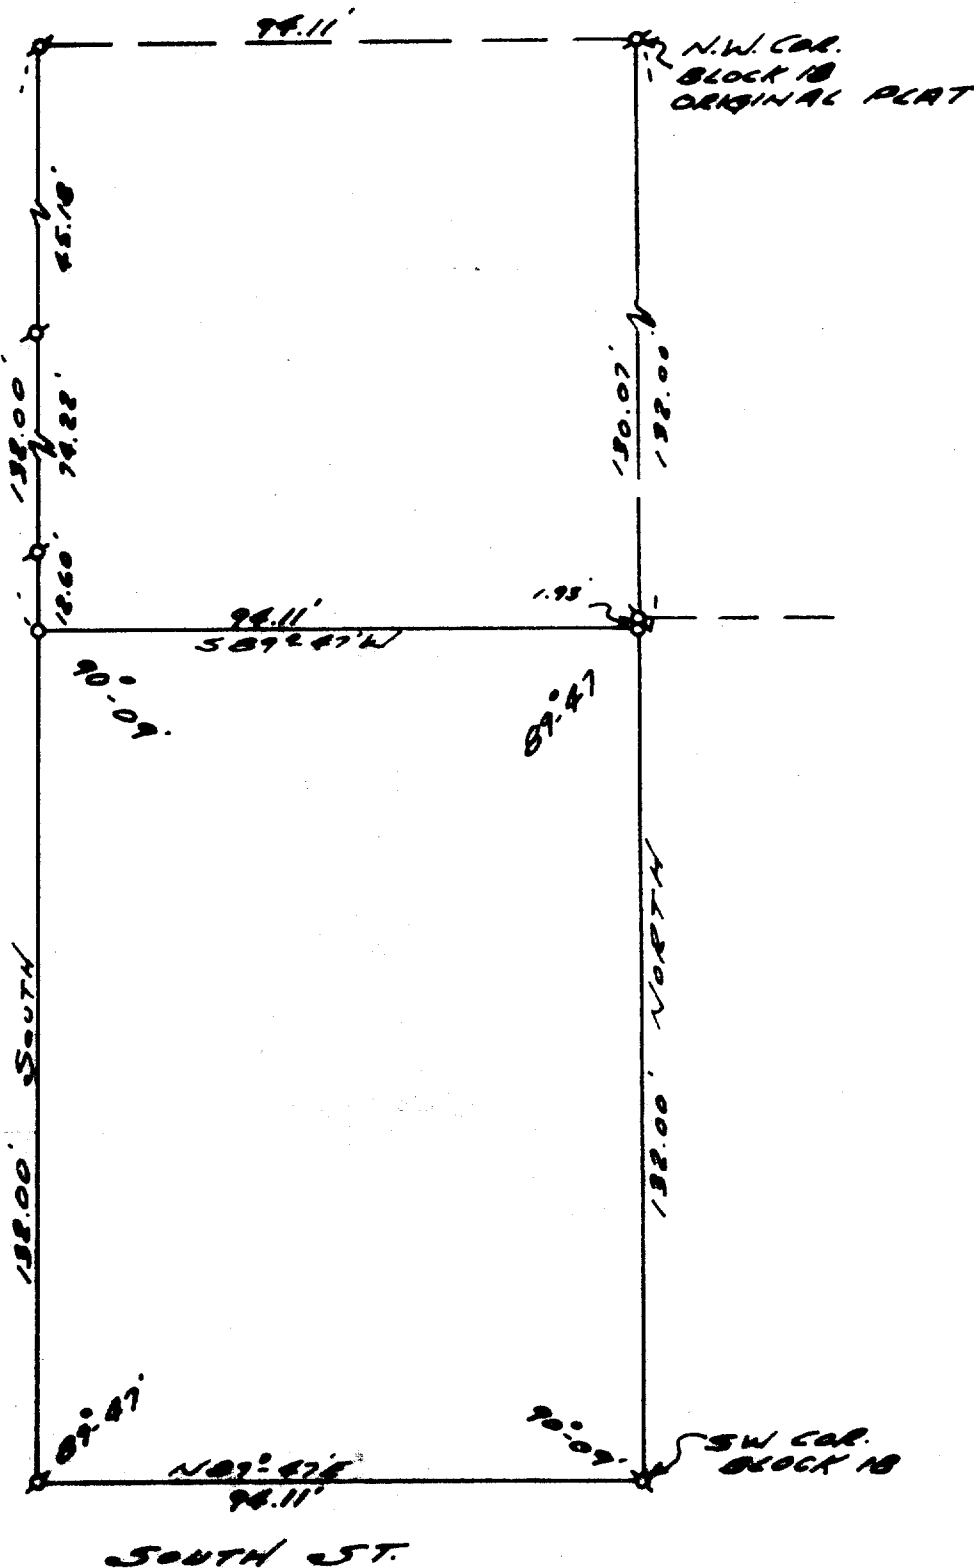

SOUTH ST.

SURVEY AND PLAT BY

JENSEN & JOHNSON, INC.

CIVIL ENGINEERS AND SURVEYORS

Elkhorn, Wisconsin

LEGEND

- — Iron Pipe SET
- — Concrete Monument
- Scale 1" = 30'
- δ — 100' AND ABOVE

WE CERTIFY: That we have surveyed the above described property and that the plat shown herein is an accurate survey and a true representation thereof and correctly shows the exterior boundary lines and all divisions of said property.

Date 10/28/1922

Lloyd L. Jensen
LLOYD L. JENSEN,

Wisconsin Registered Land Surveyor, No. 8-211

3-223✓