

W 238 S 3712 816 BEND ROAD  
WAUKESHA, WIS 53186


RONALD H. ZIMMERMAN  
REGISTERED LAND SURVEYOR

TELEPHONE  
542-5616

# PLAT OF SURVEY

FOR

**WAUKESHA SAVINGS & LOAN**

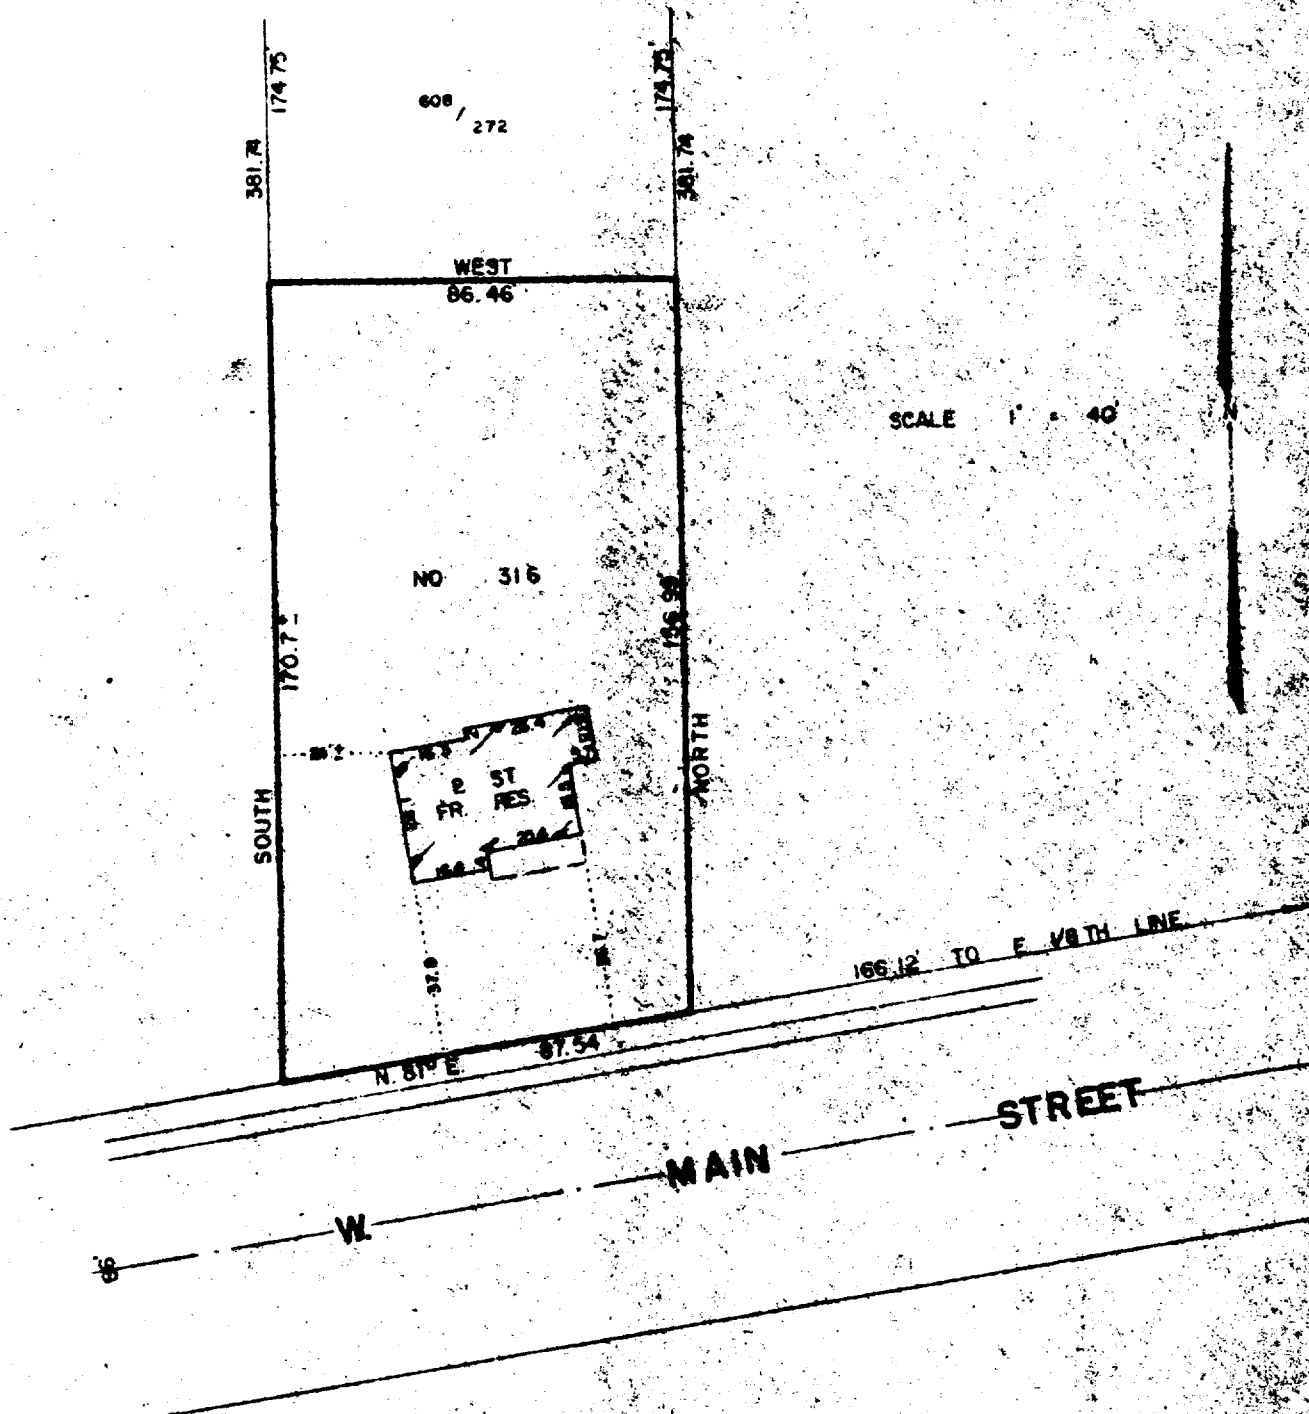

## DESCRIPTION (Furnished)

All that part of the NW 1/4 NE 1/4 of Section 10 and the SW 1/4 SE 1/4 of Section 19, all in Town 4 North, Range 18 East, described as follows, to-wit: Commencing at a point on the highway leading from the Village of East Troy to the Village of Troy 166.12 feet West of lands owned by John Matteson, thence running North 381.74 feet along the West line of lands owned by the estate of George W. Menbery, thence West 86.46 feet, thence South 381.74 feet and thence East along said highway to the place of beginning, excepting therefrom land described in deed recorded in Vol. 604 of Deeds on page 559, Document No. 162172, further excepting land described in Deed recorded in Vol. 608 of Deeds on page 272, Document No. 162172.

## CERTIFICATION

STATE OF WISCONSIN  
COUNTY OF WAUKESHA

I, RONALD H. ZIMMERMAN, REGISTERED LAND SURVEYOR, DO HEREBY CERTIFY THAT I HAVE MADE A SURVEY OF THE PROPERTY DESCRIBED ABOVE AND THE EXISTING BUILDING AND IMPROVEMENTS LOCATED THEREON AND THAT THE PLAT HEREWITH DRAWN IS A CORRECT REPRESENTATION OF SAID SURVEY.

DATE OCT 4 1972



XUP-111

3-229