


Plat of Survey

Survey For: A & W ROOT BEER.
Location: Country Trunk Highway "ES"

Description: Commencing at the intersection of Centerline of Milwaukee-Beloit Road (now known as County Trunk Highway ES) and the North and South 1/4 Section Line of Section 30, T. 4 N., R. 18 E., in the Town of East Troy, Walworth County, Wisconsin; thence South $82^{\circ}45'$ West along the centerline of said highway 500 feet to a point on said centerline which is the place of beginning of this description; thence South parallel to said quarter line 220.00 feet to an iron stake; thence North $82^{\circ}45'$ East 200 feet to a point; thence North and parallel with said North and South quarter Section line 220.0 feet to the centerline of aforesaid highway; thence South $82^{\circ}45'$ West along the cetnerline of said highway 200 feet to the place of beginning.

N.E. COR.
OF 1/4 SEC.
(BRASS PLATE)

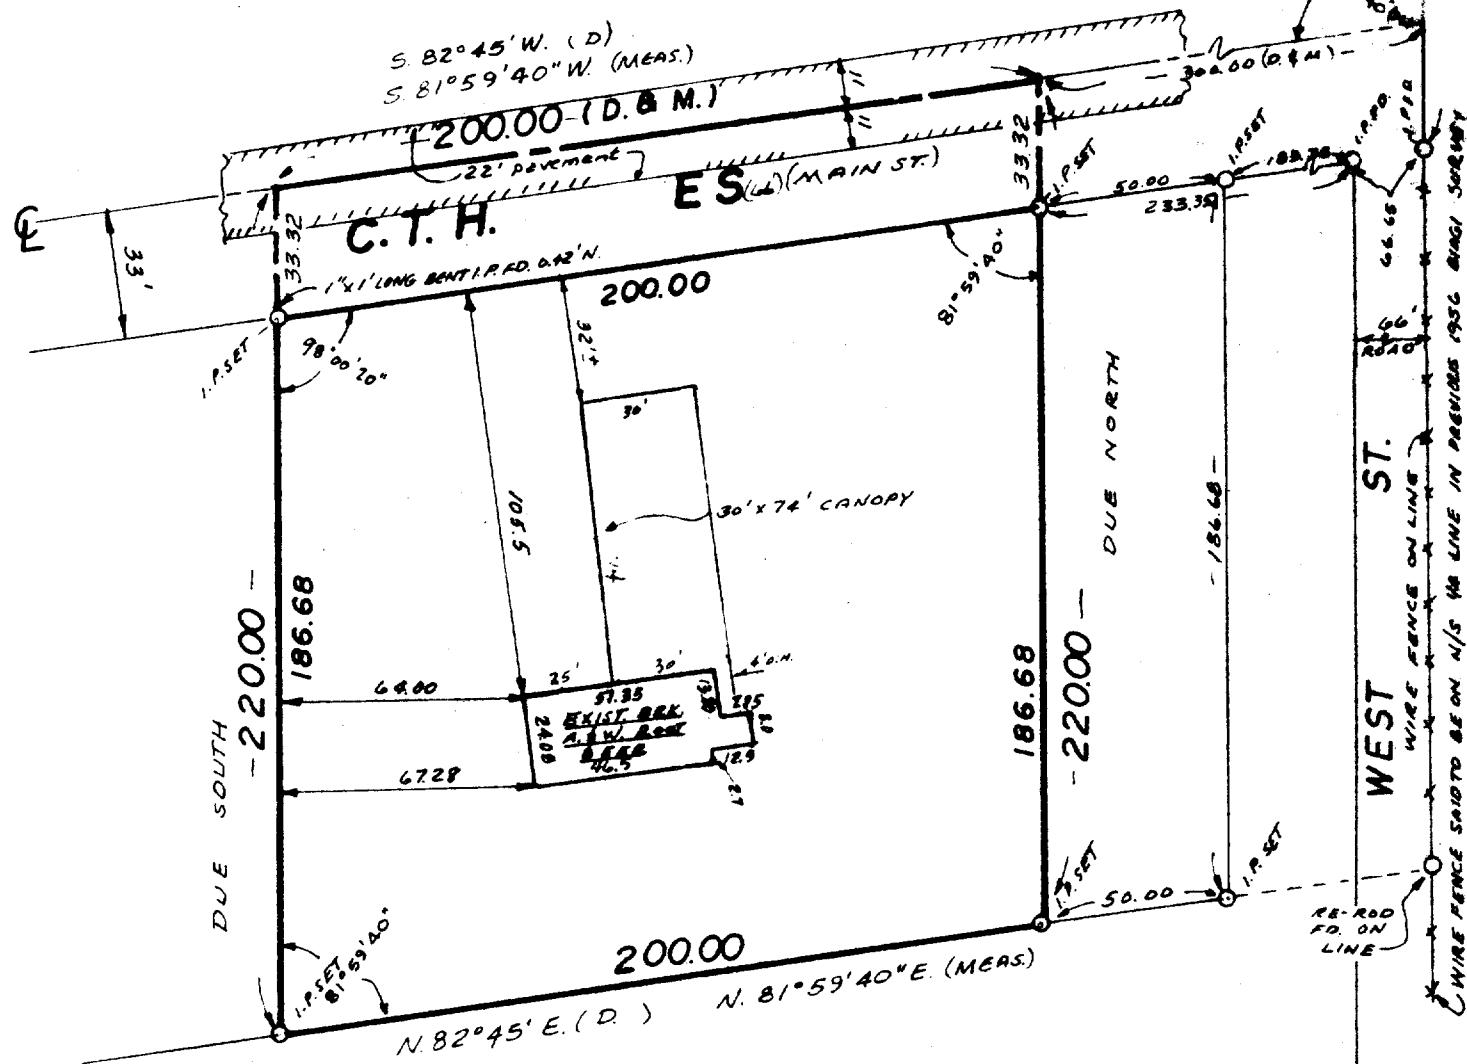

INMAN SURVEY

Scale: 1" = 50'

WEST OFFICE:
P.O. BOX 286
EAST TROY, WI 53120
(414) 642-3113

EAST OFFICE:
11221 W. FOREST HOME AVE.
MILWAUKEE, WI 53130
(414) 425-2060

SURVEY CERTIFICATE

State of Wisconsin, ss
Milwaukee County I certify that I have surveyed the above described (property) and the above map is a true representation thereof and shows the size and location of the Property, its exterior boundaries, the location and dimensions of all visible structures thereon, fences, apparent easements and roadways and visible encroachments, if any.

This survey is made for the exclusive use of the present owners of the Property, and also those who purchase, mortgage, or guarantee the title thereto within one (1) year from date hereof:

DATE: 6-15-81
JOB NO.: 9195

RXUP-199

THOMAS INMAN, Registered Land Surveyor

~~RXUP-199 Now Part of RXUP 200~~

3-234