


SITE PLAN

A parcel of land located in the Southeast 1/4 of Section 20, Township 4 North, Range 18 East, Village of East Troy, Walworth County, Wisconsin.

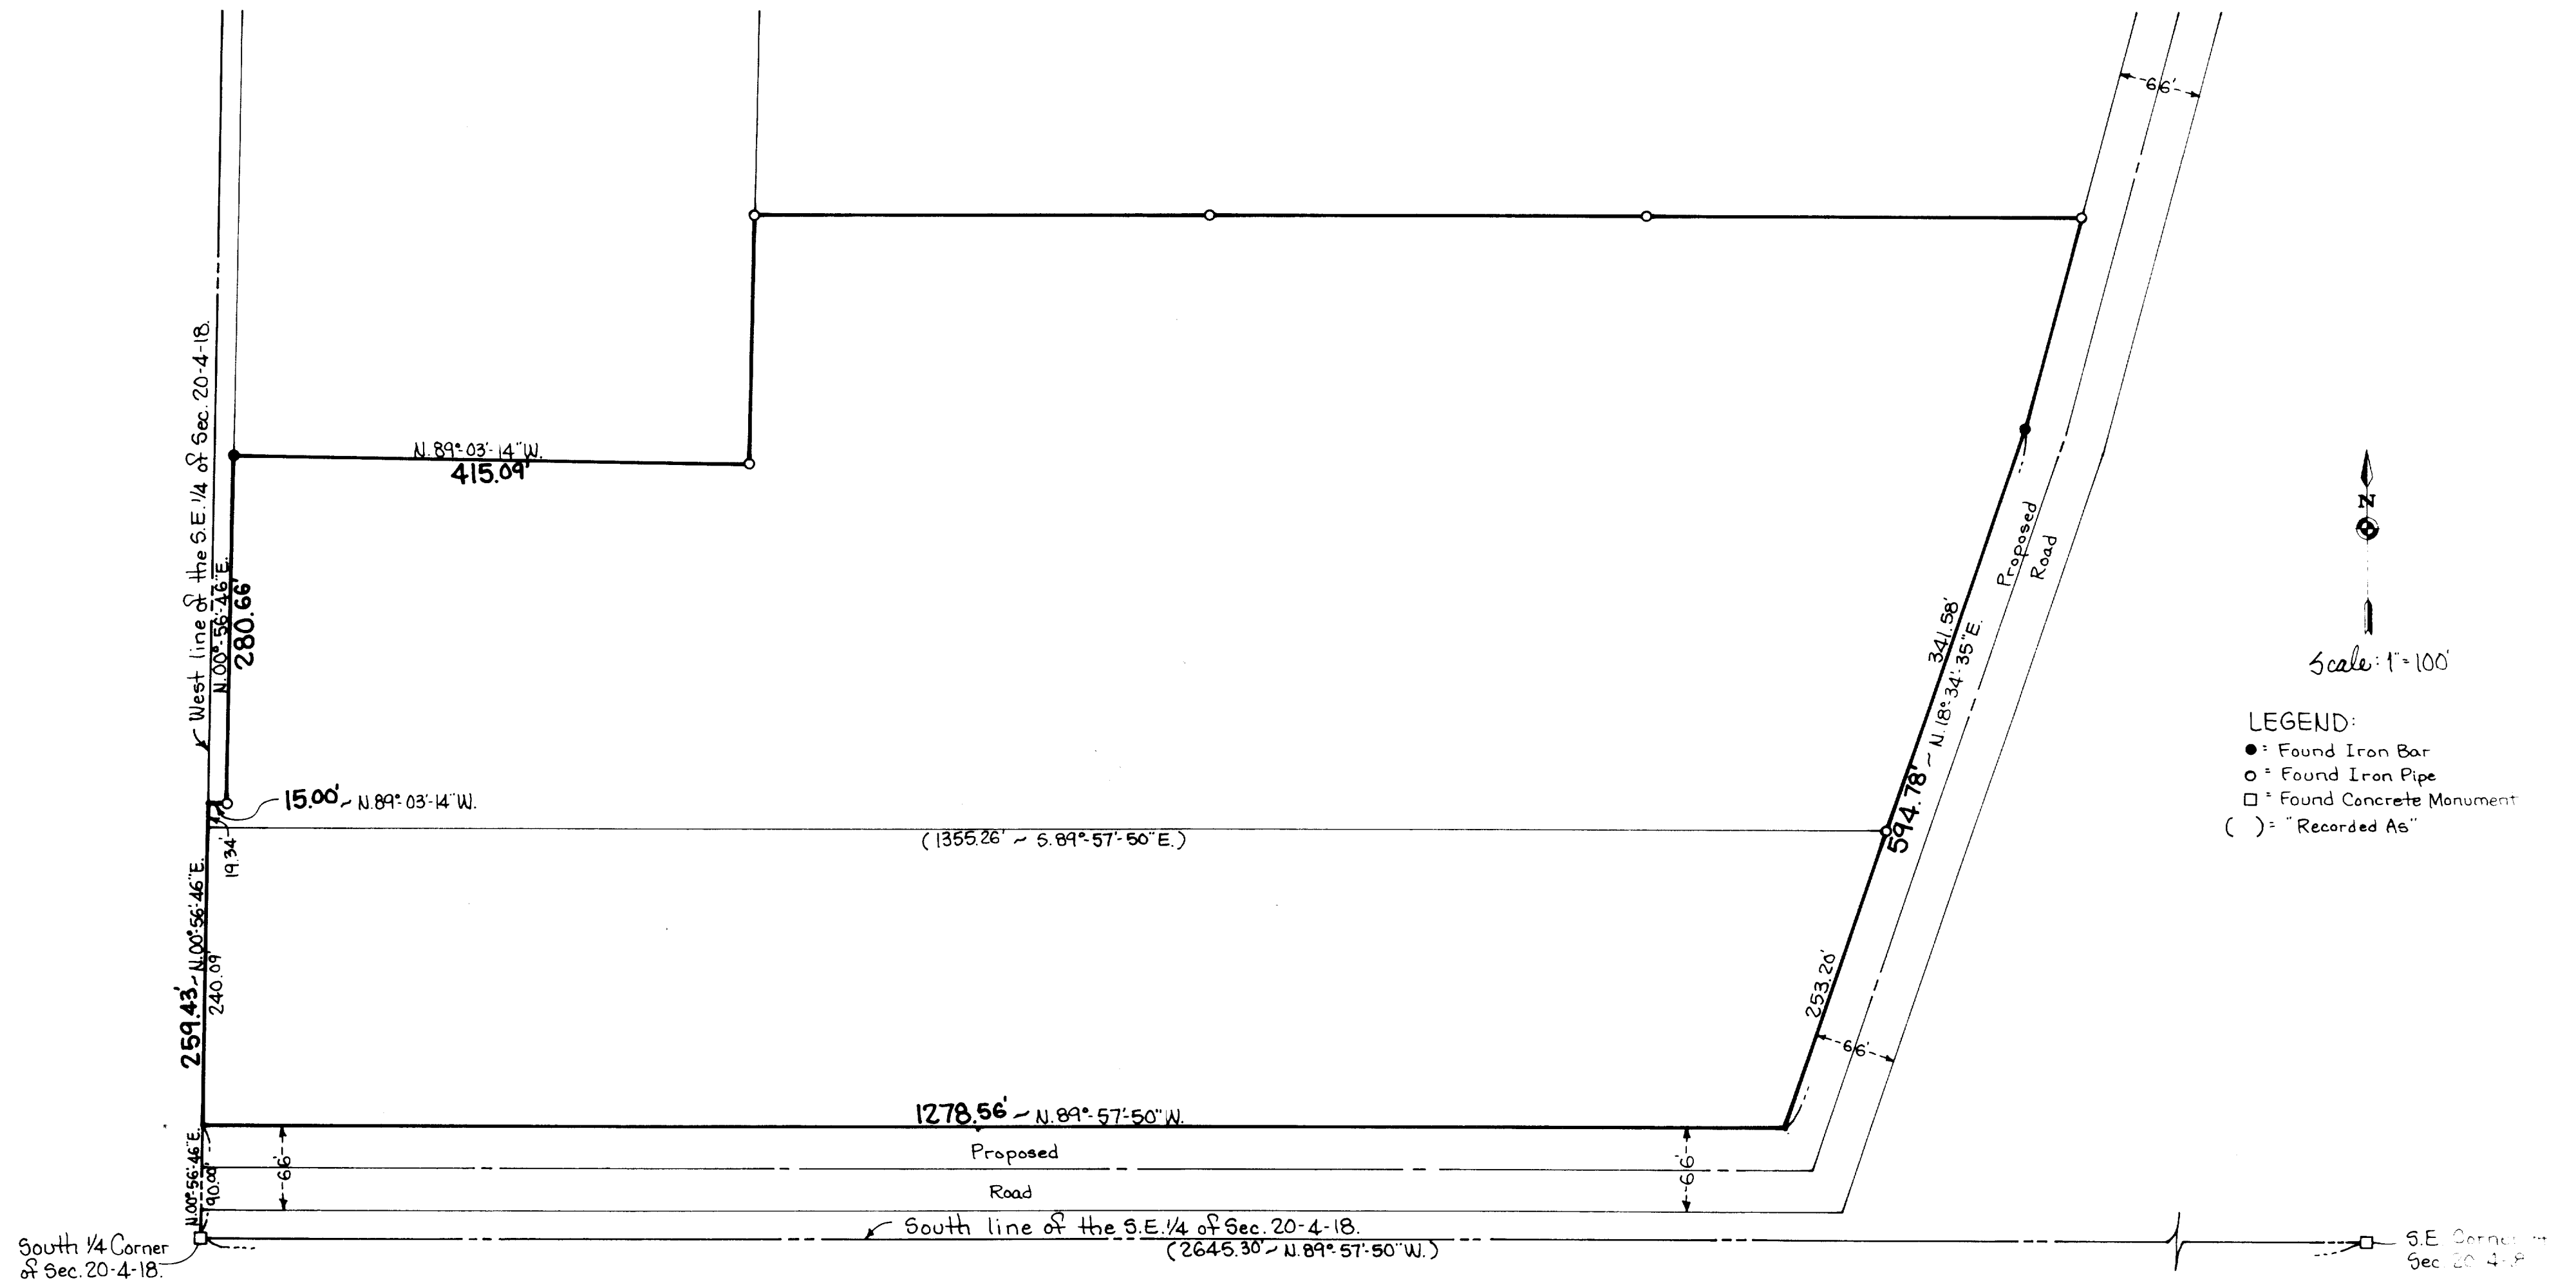

Surveyed for: TRENT TUBE

Surveyed by:
JENSEN SURVEYING & MAPPING, S.C.
 P.O. Box 322 45 S. Wisconsin Street
 Elkhorn, Wisconsin 53121
 Phone: (414) 723-3434

1983-1984
 1984-1985

1983-1984
 1984-1985