


Date June 15, 1983

PLAT OF SURVEY

Job No. Z-14-29110

LOT 12 - TROYJENS SUBDIVISION
located in the Southwest 1/4 of Section 19, Town 4 North, Range 18 East,
Village of East Troy, Walworth County, Wisconsin.

Located at 2043 Emery Street

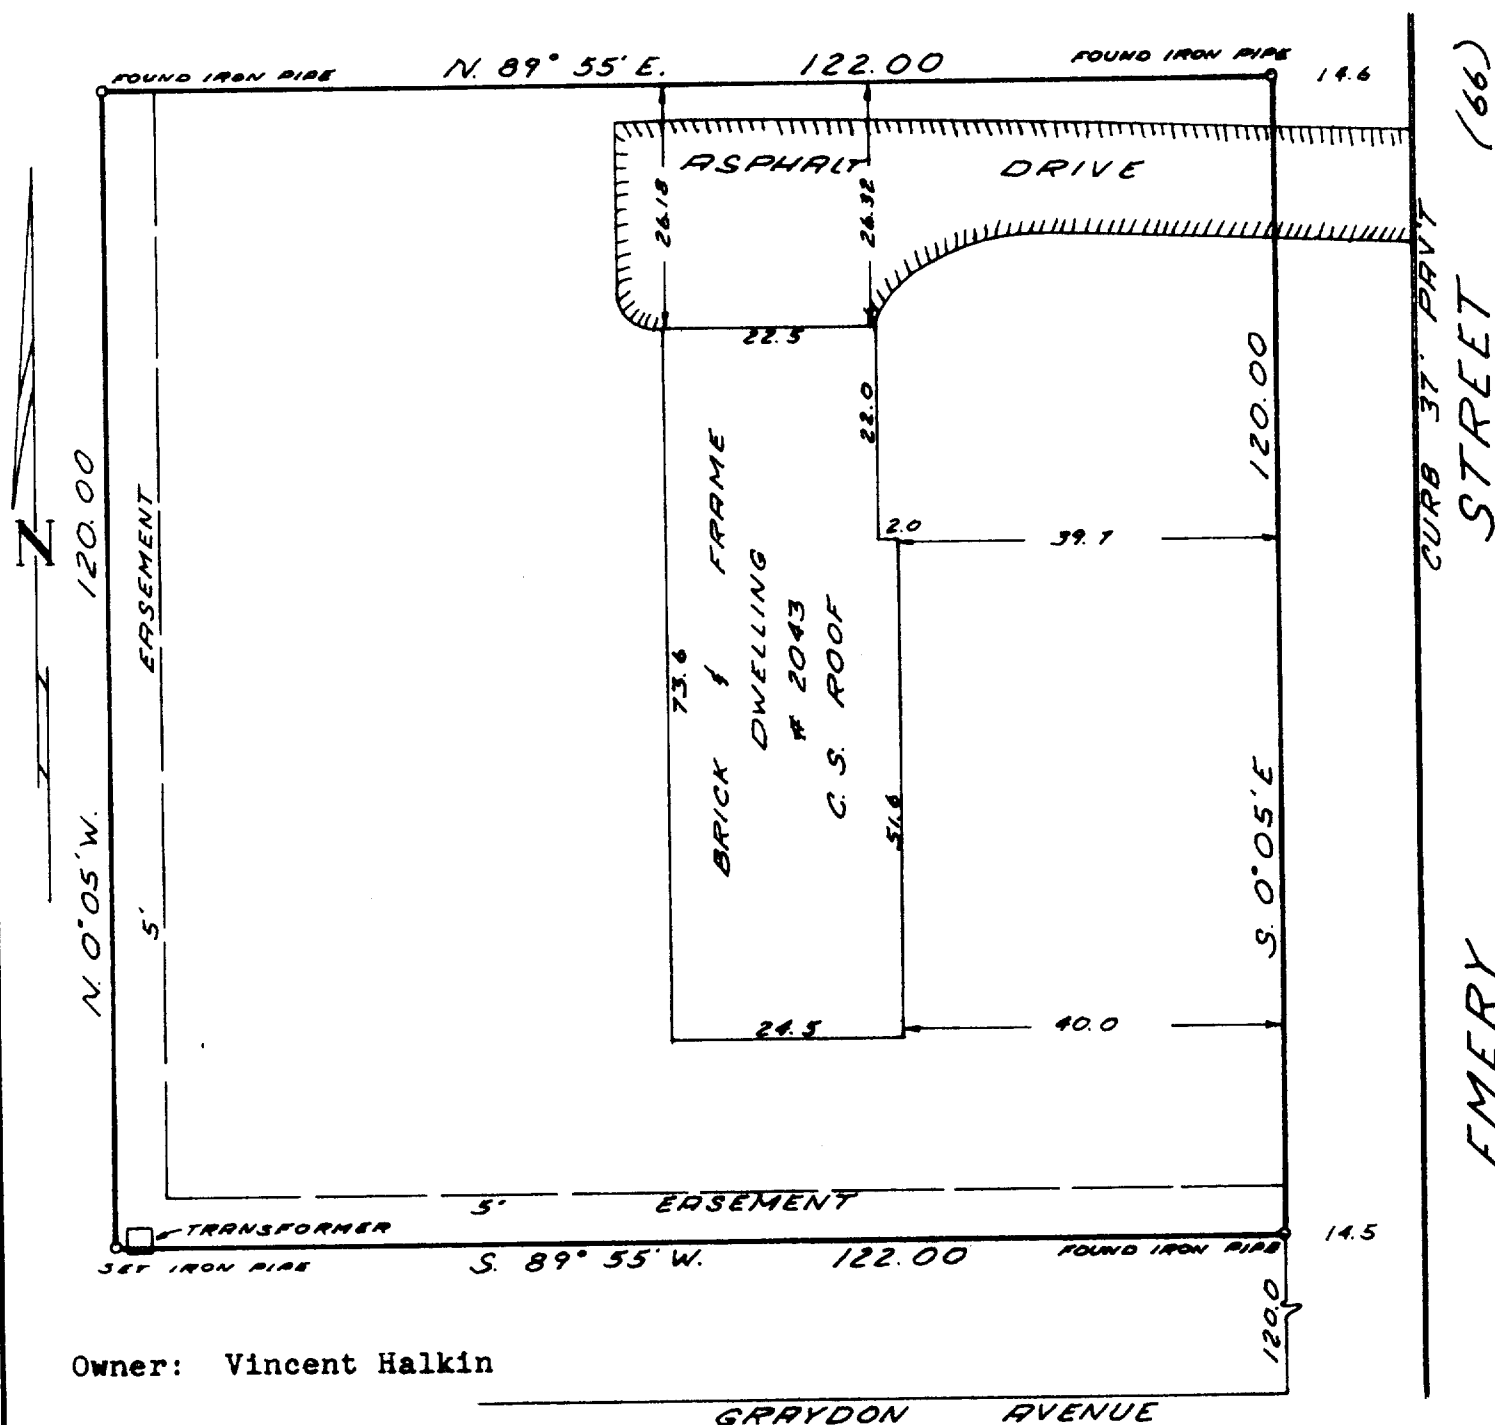

Owner: Vincent Halkin

8522 West Lisbon Avenue
Milwaukee, Wisconsin 53222

SURVEYED FOR

Norwest Mortgage Inc.
P. O. Box 26144
Milwaukee, WI 53226

Surveyed by
RICHARD J. LAMMI

PHONE
461-3730

SCALE 1"=20'

I have surveyed the above described property, and the above map is a true representation thereof and shows the size and location of the property, its exterior boundaries, the location and dimensions of all visible structures thereon, fences, apparent easements, roadways and visible encroachments.

This survey is made for the exclusive use of the present owners of the property; also those who purchase, mortgage or guarantee the title thereto, within one year from date hereof.

Richard J. Lammi
REGISTERED LAND SURVEYOR NO. S-777 - STATE OF WISCONSIN



3-236-L