

PLAT OF SURVEY OF

PART OF THE SOUTHEAST 1/4 OF SECTION 19, T. 4 N., R. 18 E. OF THE 4TH P.M., VILLAGE OF EAST TROY, COUNTY OF WALWORTH, STATE OF WISCONSIN AND MORE PARTICULARLY DESCRIBED AS FOLLOWS: BEGINNING AT A POINT 6 CHAINS AND 55 LINKS SOUTH OF THE NORTHEAST CORNER OF THE SOUTHEAST 1/4 OF SECTION 19, RUNNING THENCE WEST 4 CHAINS AND 50 LINKS; THENCE SOUTH 1 CHAIN AND 25 LINKS; THENCE EAST 4 CHAINS AND 50 LINKS; THENCE N. 1 CHAIN AND 25 LINKS TO THE PLACE OF BEGINNING.

FOR: GRAYDON WHITMORE

SCALE 1" = 20'

○ - IRON PIPE STAKE SET

⊙ - IRON PIPE STAKE FOUND


■ = CONCRETE MONUMENT FOUND

✕ = MASONRY NAIL SET.

I have surveyed the above described property and the map hereon is a true representation thereof and shows the size and location of the property, its exterior boundaries, the location and dimensions of all visible structures, fences, adjacent easements and roadway and visible encroachments, if any.

This survey is made for the exclusive use of the present owners of the property and also those who purchase hereafter, to guarantee the title thereto within one year from date hereof.

Dated at Burlington, Wis. 8th day of SEPT 1983
John F. Degen, Land Surveyor

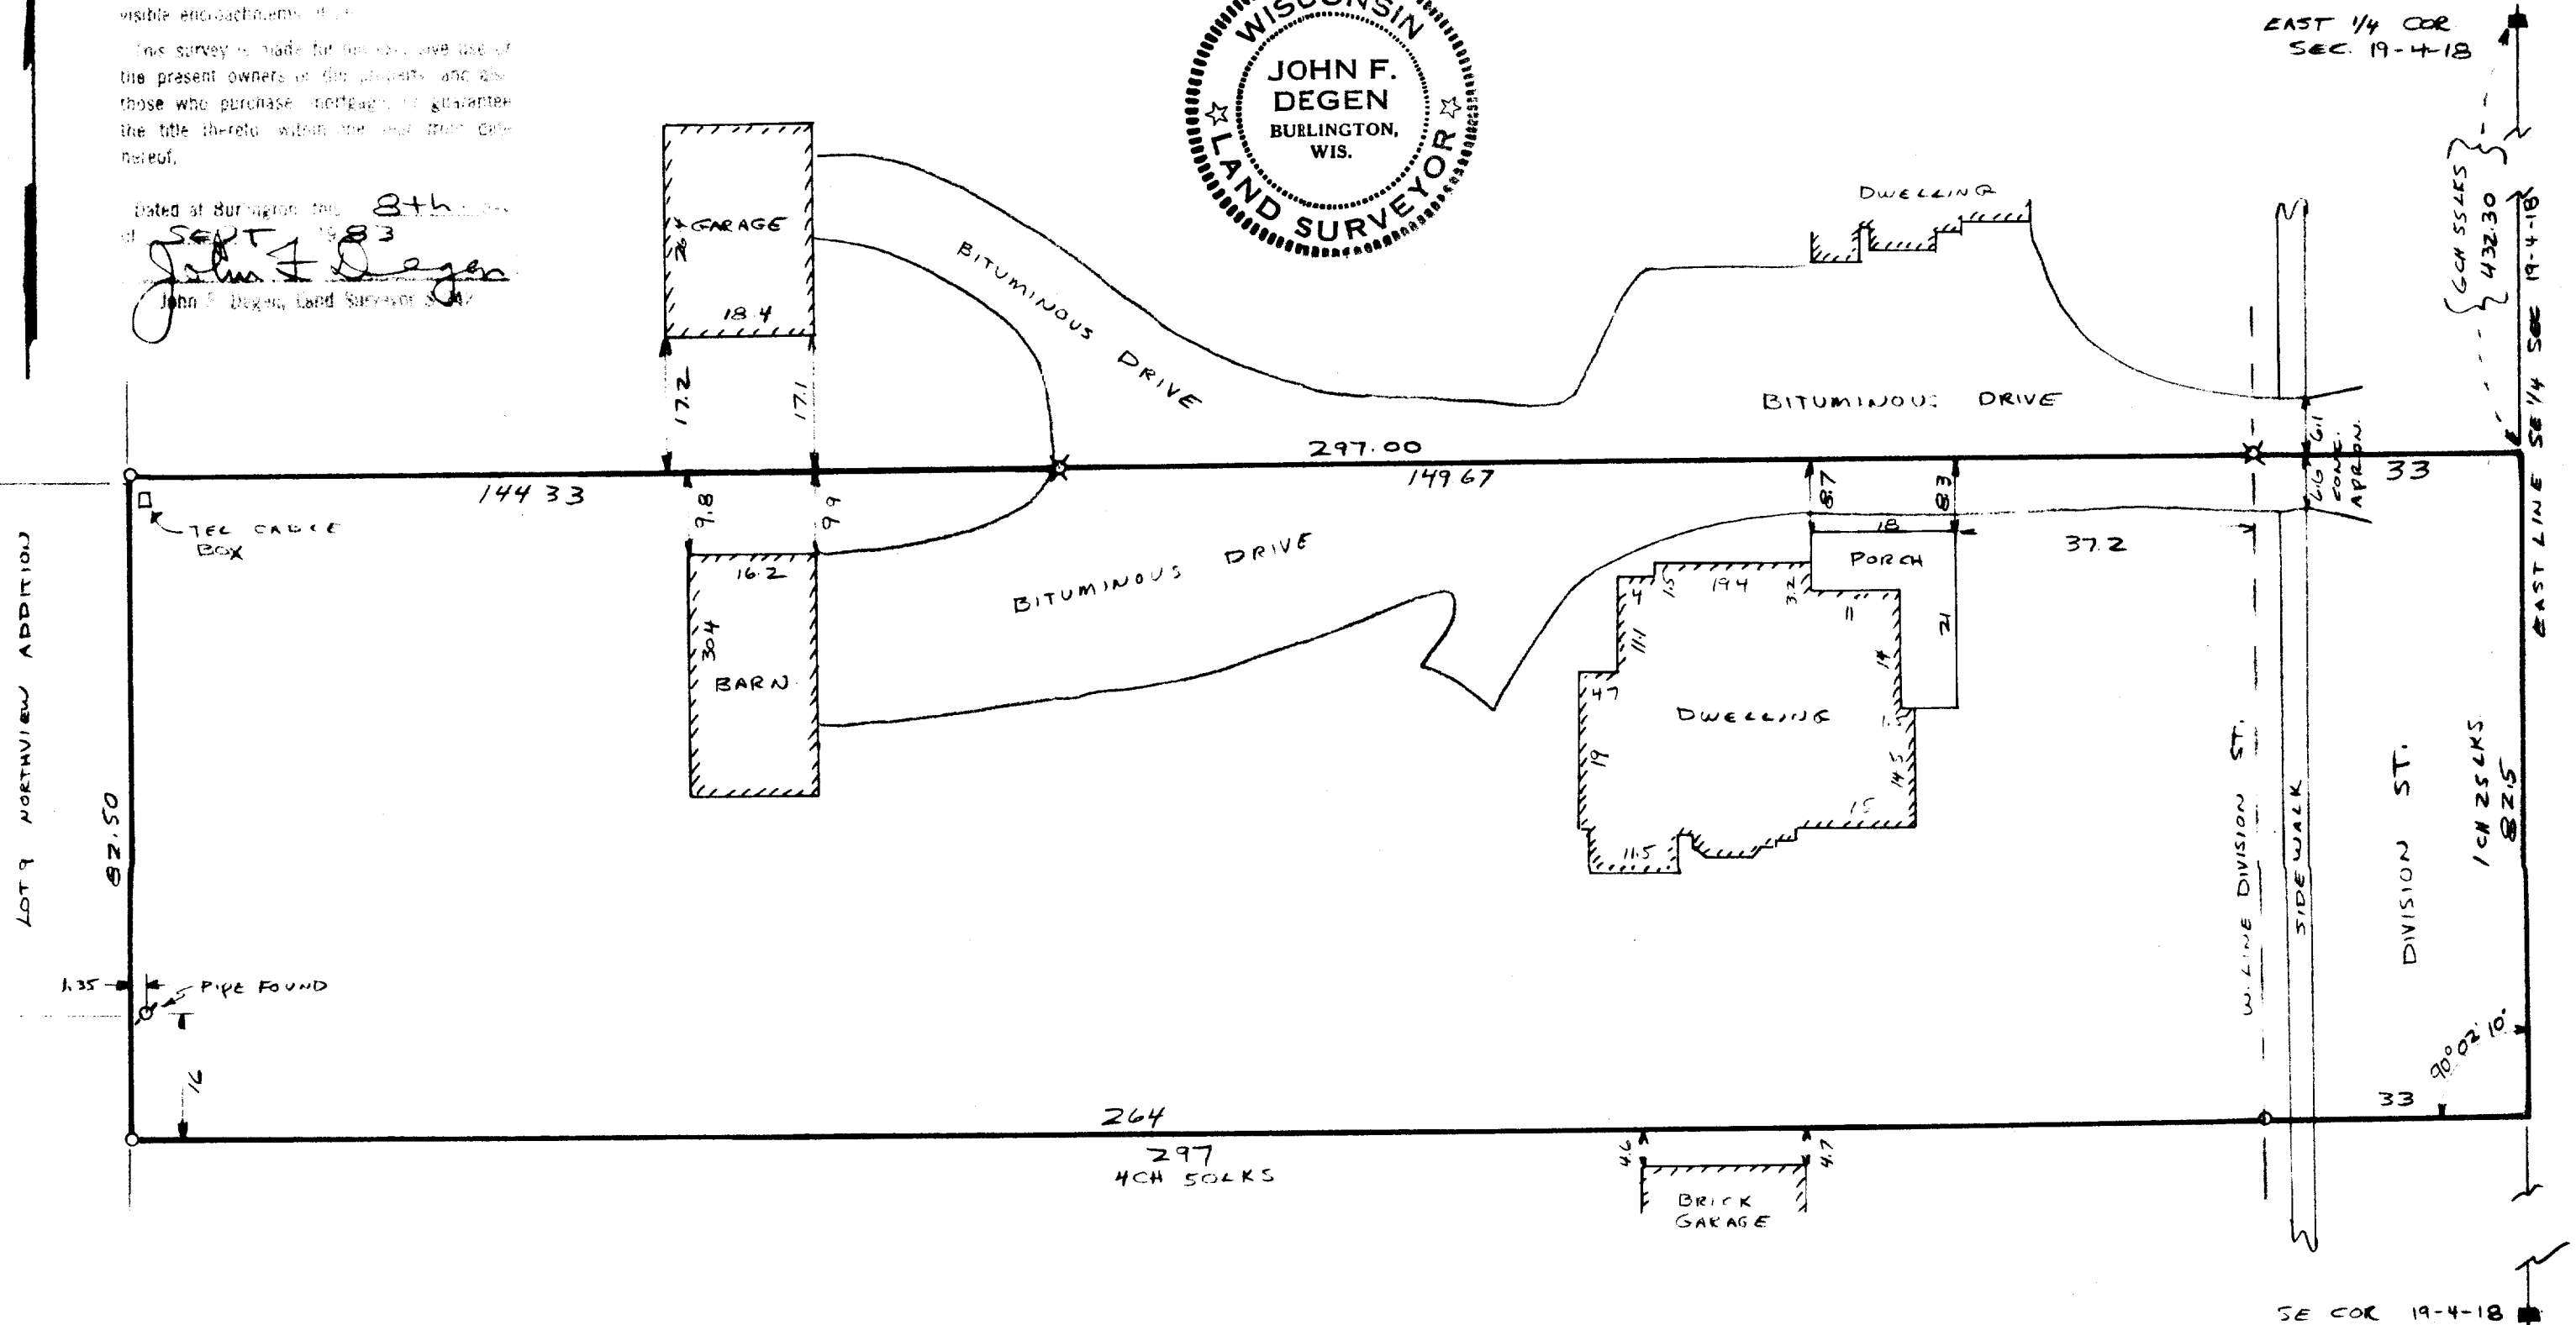

R.V.D. 87

12-C-2 #39