

FARRIS, HANSEN & ASSOCIATES, INC.

ENGINEERING, SURVEYING & LAND PLANNING

715 W. WALWORTH ST. - BOX 487 - ELKHORN, WI..


PHONE: 414-723-2098

PLAT OF SURVEY OF THE FOLLOWING
DESCRIBED LANDS LOCATED IN THE
VILLAGE OF EAST TROY, WALWORTH
COUNTY, WISCONSIN

Description of record
document # 19955


Commencing at a point on the West line of lot No. 2 P.O. Griste's Addition
to the Village of East Troy; 93 feet and 3 inches North of the South line
of said lot 2, running thence North along said West line of said lot 2,
61 feet and 9 inches to the South line of W. F. Henry lot, thence East along
the South line of said Henry lot to the East line of said lot 2, thence South
along the East line of said lot 2, 61 feet and 9 inches thence West
parallel with the South line of said lot to the place of beginning.

WORK ORDERED BY: GER-MEL REALTY

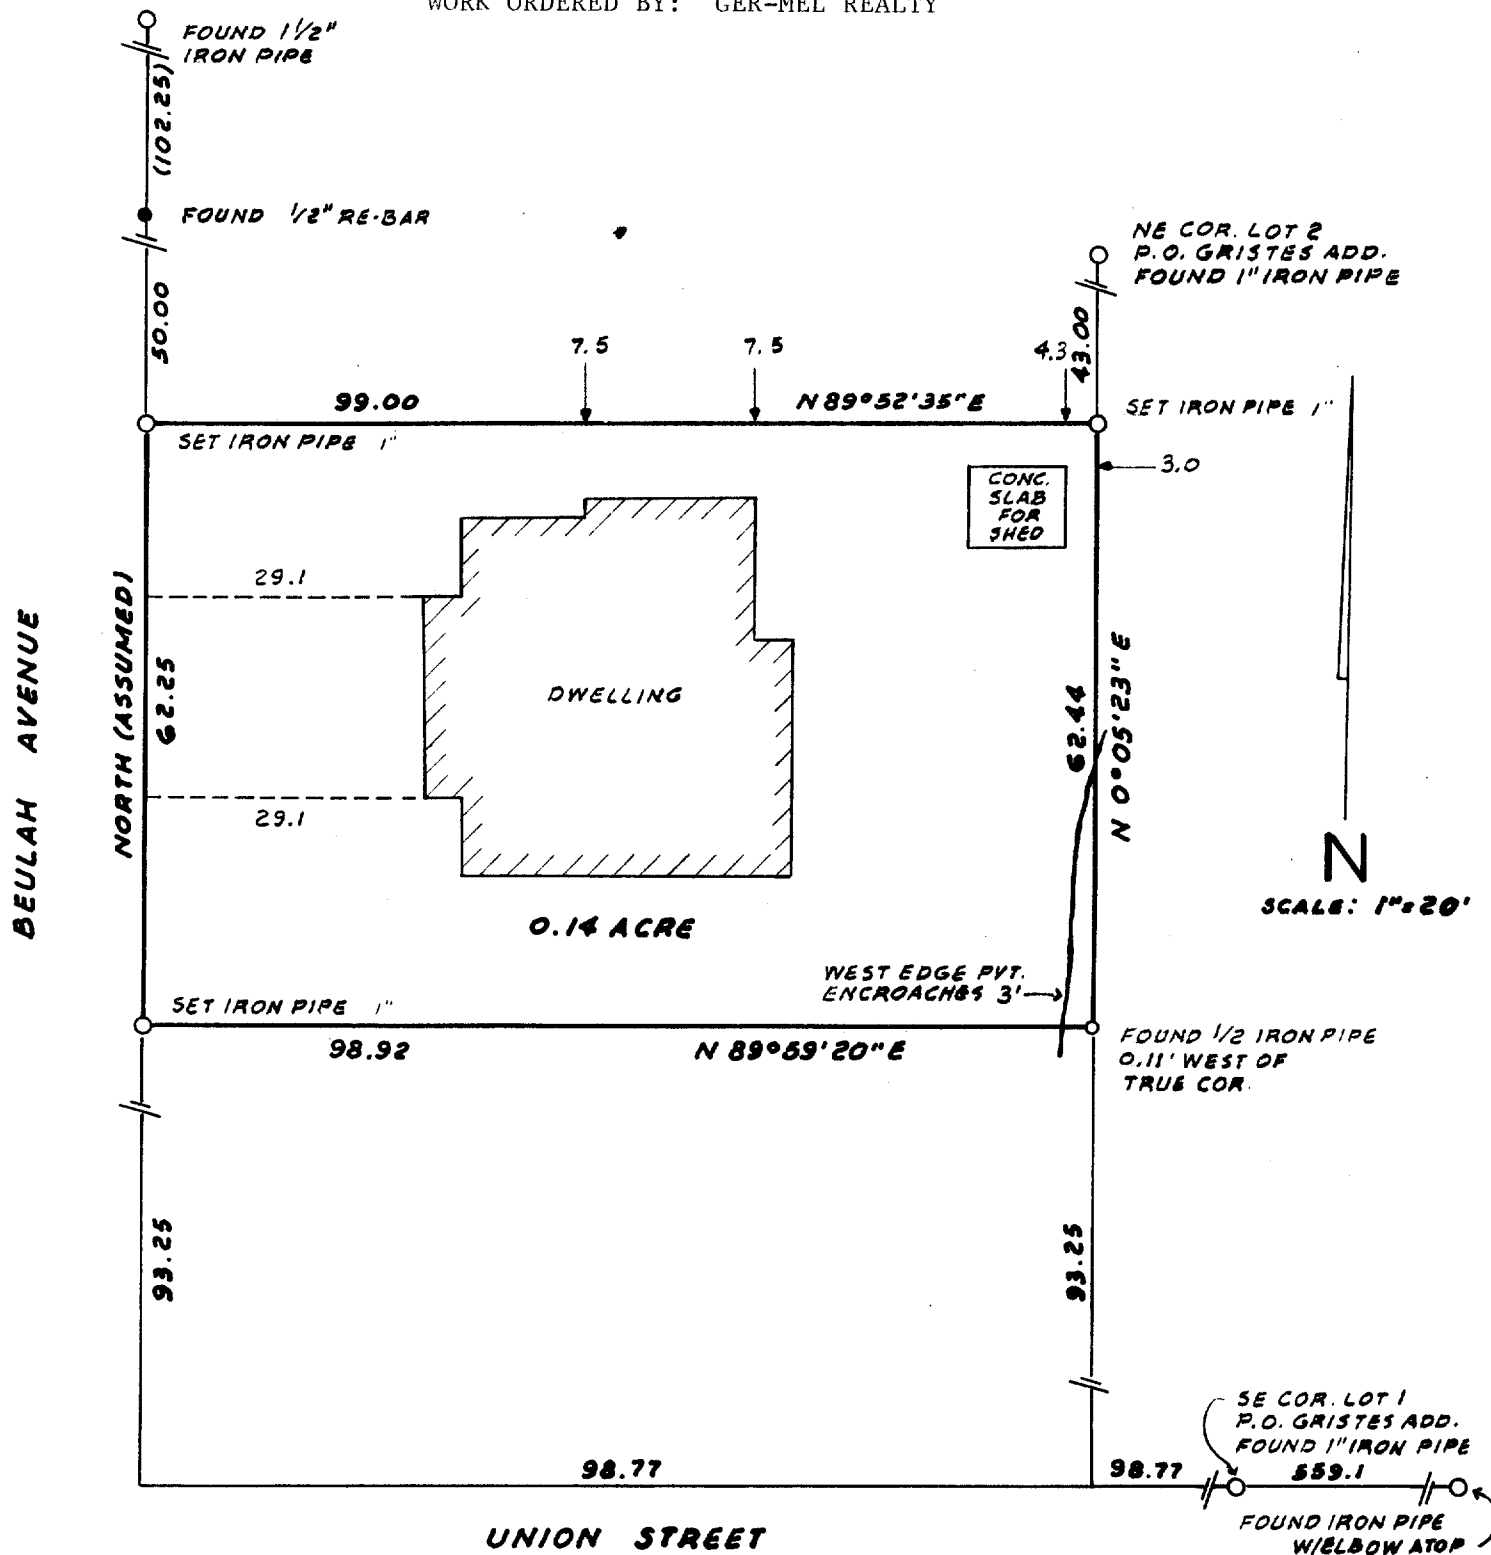

I hereby certify that I have surveyed the above described lands and that this plat
of survey is a true and accurate representation thereof
to the best of my professional knowledge and belief.

William R. Ohberg
William R. Ohberg
WI Registered Surveyor, S-1679

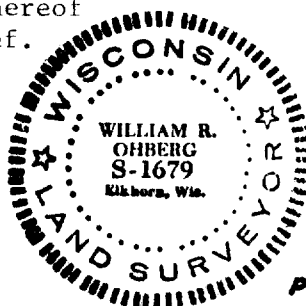

Dated This 15th Day of MARCH, 1984

PROJECT NO. 2211
3-244