



Commencing at the Southwest Corner of Block 19 of the original plat of the Village of East Troy; thence South 77°18'07" West 58.00 feet to a point on the Centerline of South Church Street 12°21'55" East 322.04 feet along said Centerline; thence South 17°23'53" East 134.54 feet to an angle point said Centerline; thence South 05°29'07" West 117.76 feet along said Centerline; thence South 83°55'48" East 33.70 feet to a point on the Westerly line of said South Church Street and the point of beginning of this description; thence continuing South 83°55'48" West 215.06 feet to a found 1-1/4" iron pipe; thence North 60°58'21" East 231.78 feet to a point on the Westerly right-of-way line of said South Church Street; thence South 67°09'04" East 90.42 feet along said Centerline to the point of beginning and the end of this description, and containing 0.223 acres of land, more or less.

7/18/84

Joseph S. Klarkowski
JOSEPH S. KLARKOWSKI, ALS 1595

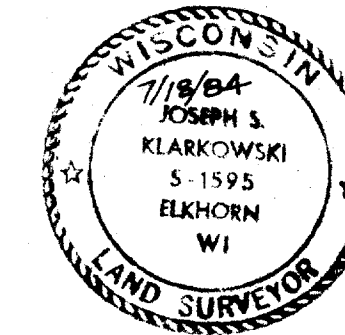

SURVEYED FOR : COLT INDUSTRIES
TRENT TUBE DIVISION
2188 S CHURCH ST.
EAST TROY, WI, 53120

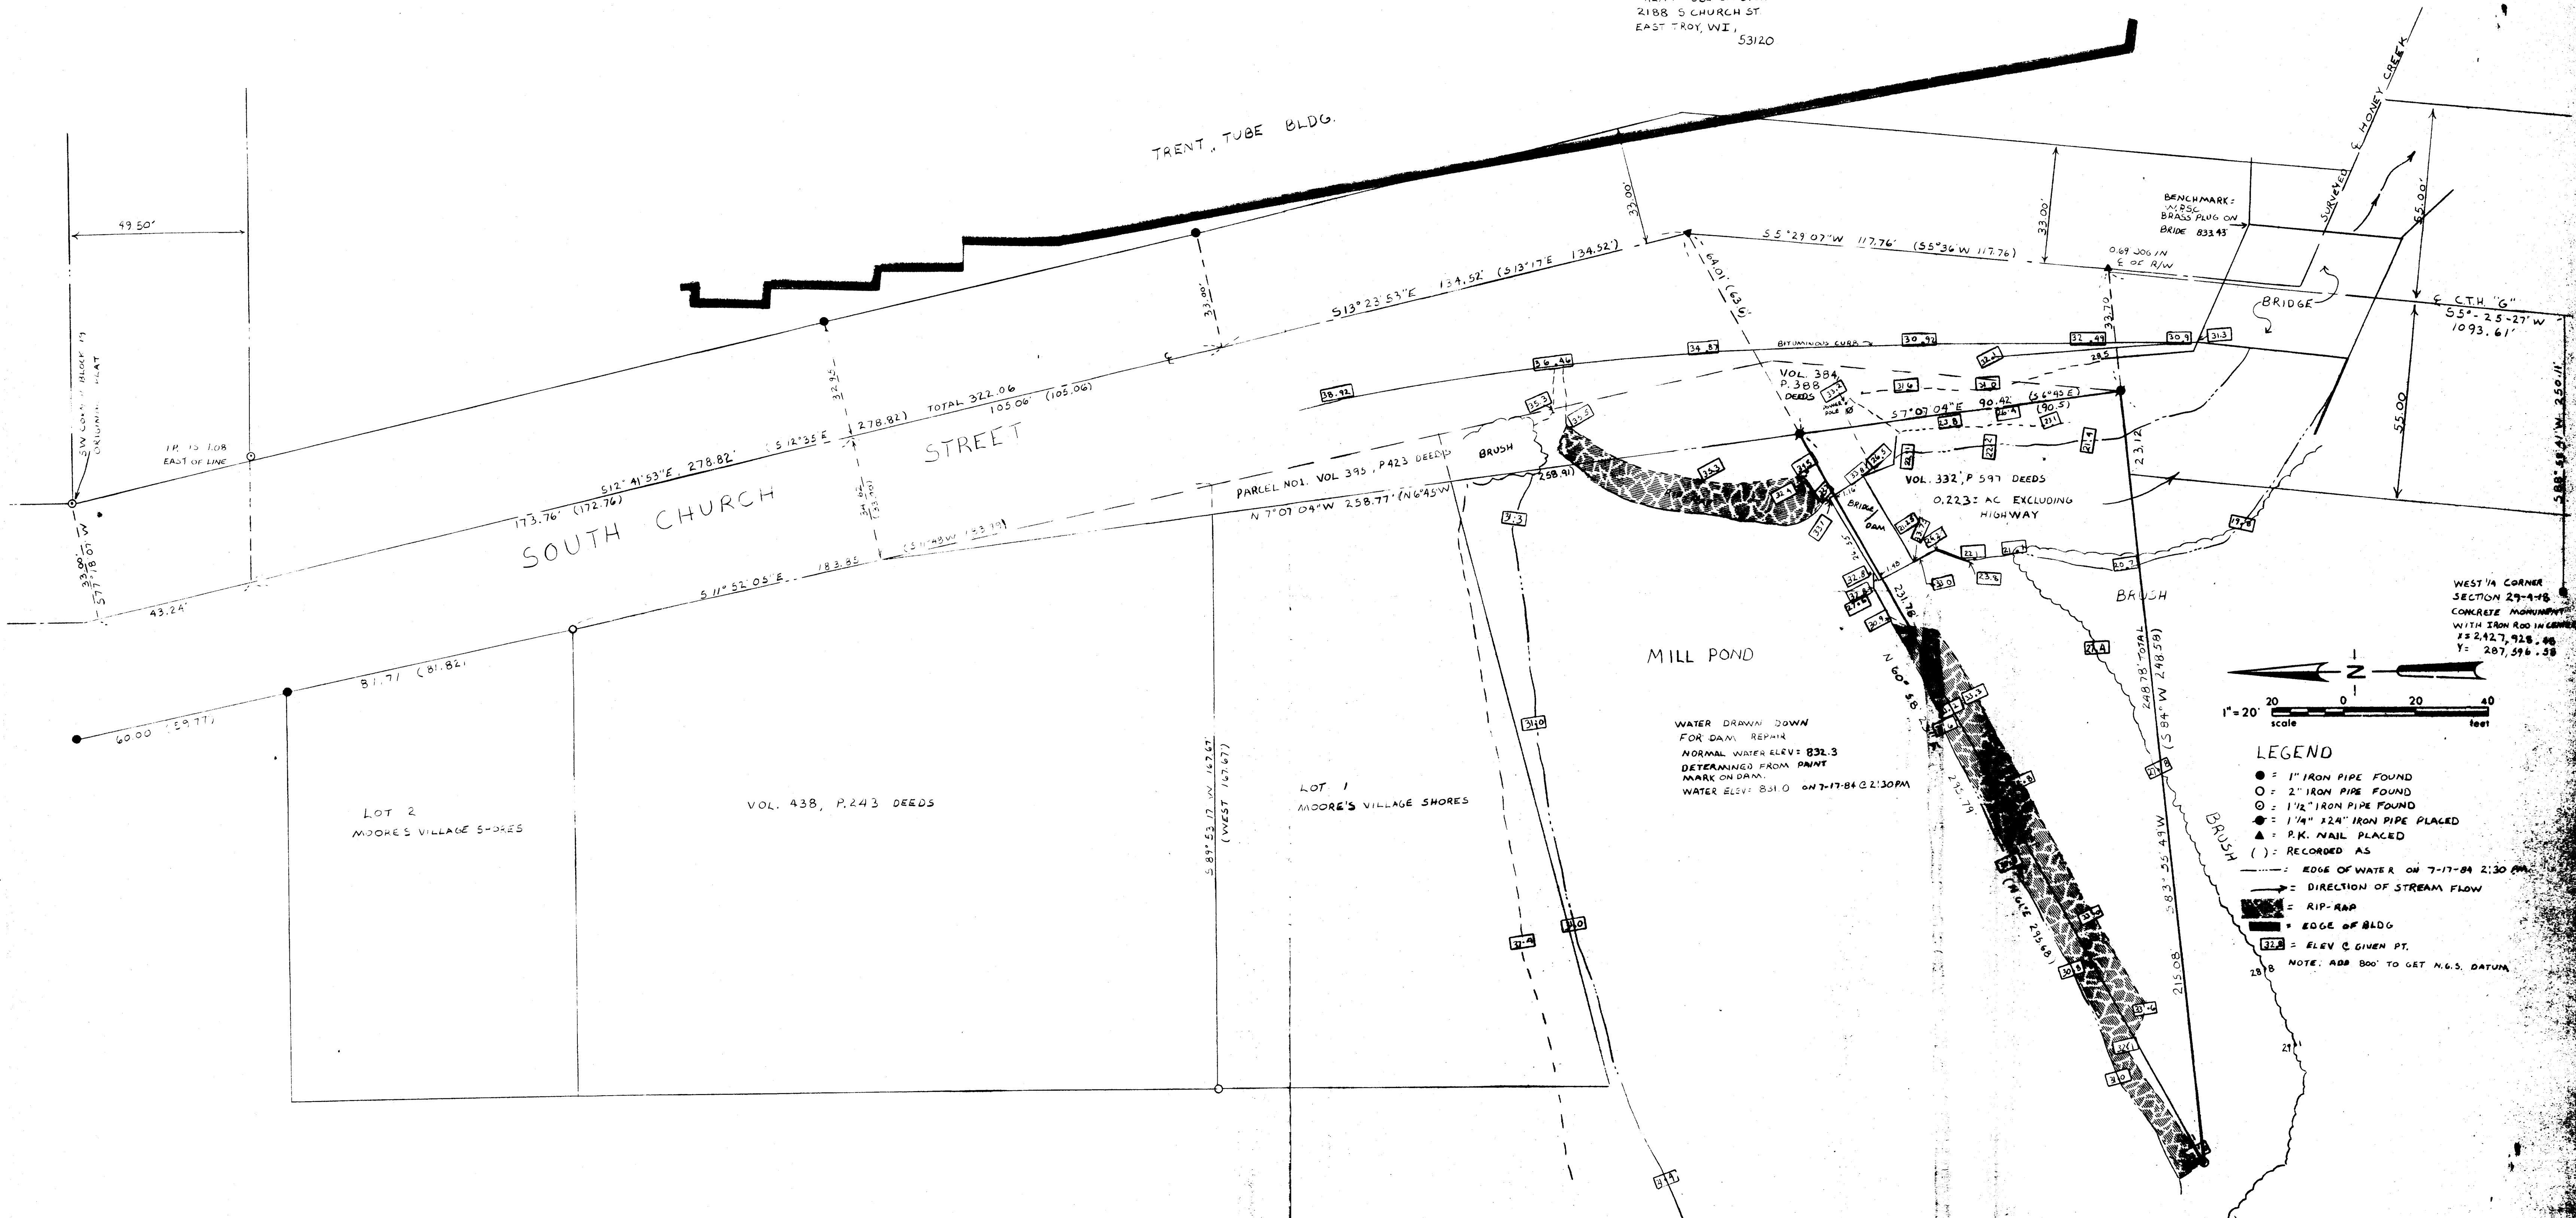

Donchue

Engineers & Architects

Scale									
Date	7-1-84								
Design									
Draft	JB-555								
Checker									
Approver		No.						By	Date

3-249