

LOCATION: 2167 Clark Street, East Troy, Wisconsin

LEGAL DESCRIPTION: Lot 21, in MOORE'S VILLAGE SHORES, of part of the Northwest 1/4 of the Northwest 1/4 and Southwest 1/4 of the Northwest 1/4 of Section 29 and parts of the Northeast 1/4 of the Northeast 1/4 and the Southeast 1/4 of the Northeast 1/4 of Section 30, all in Township 4 North, Range 18 East, in the Village of East Troy, Walworth County, Wisconsin.



April 5, 1984

Survey No. 61711

Easement Added 4/9/84



N.L. NORTH SHORE DR.

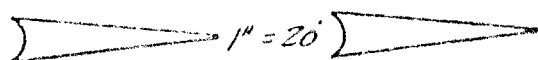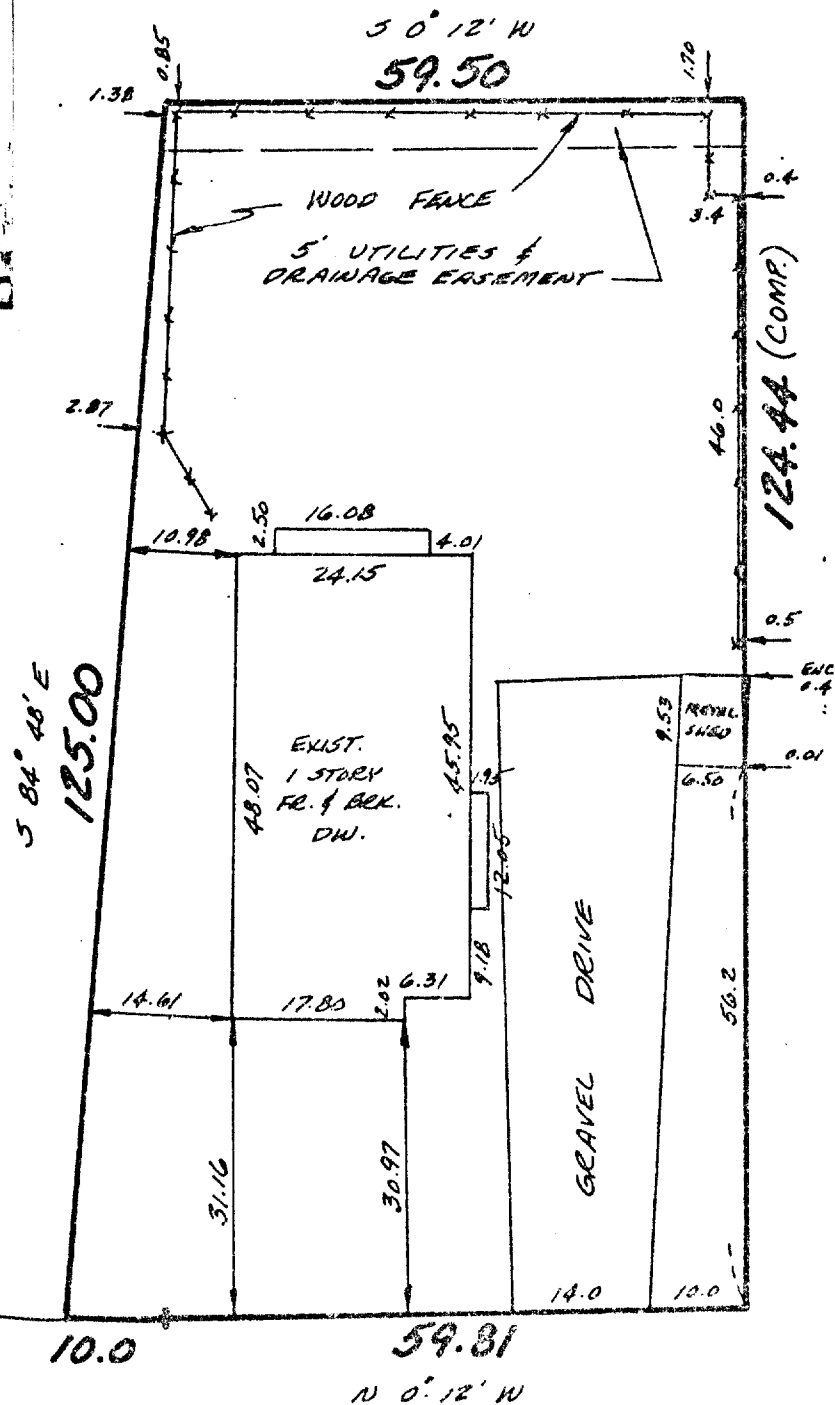

CLARK ST. 3-251'