




Farris, Hansen & Associates, Inc.
 Engineers, Architects and Surveyors
 P.O. BOX 487
 7 RIDGEWAY COURT
 ELKHORN, WISCONSIN 53121
 414-723-2098

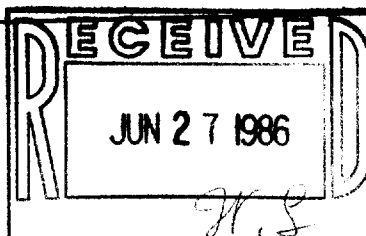

PLAT OF SURVEY OF LOT 36 OF TROYJENS
 SUBDIVISION IN SW 1/4 SW 1/4 SEC. 19, T. 4 N.,
 R. 18 E., VILLAGE OF EAST TROY, WALWORTH CO., WI.

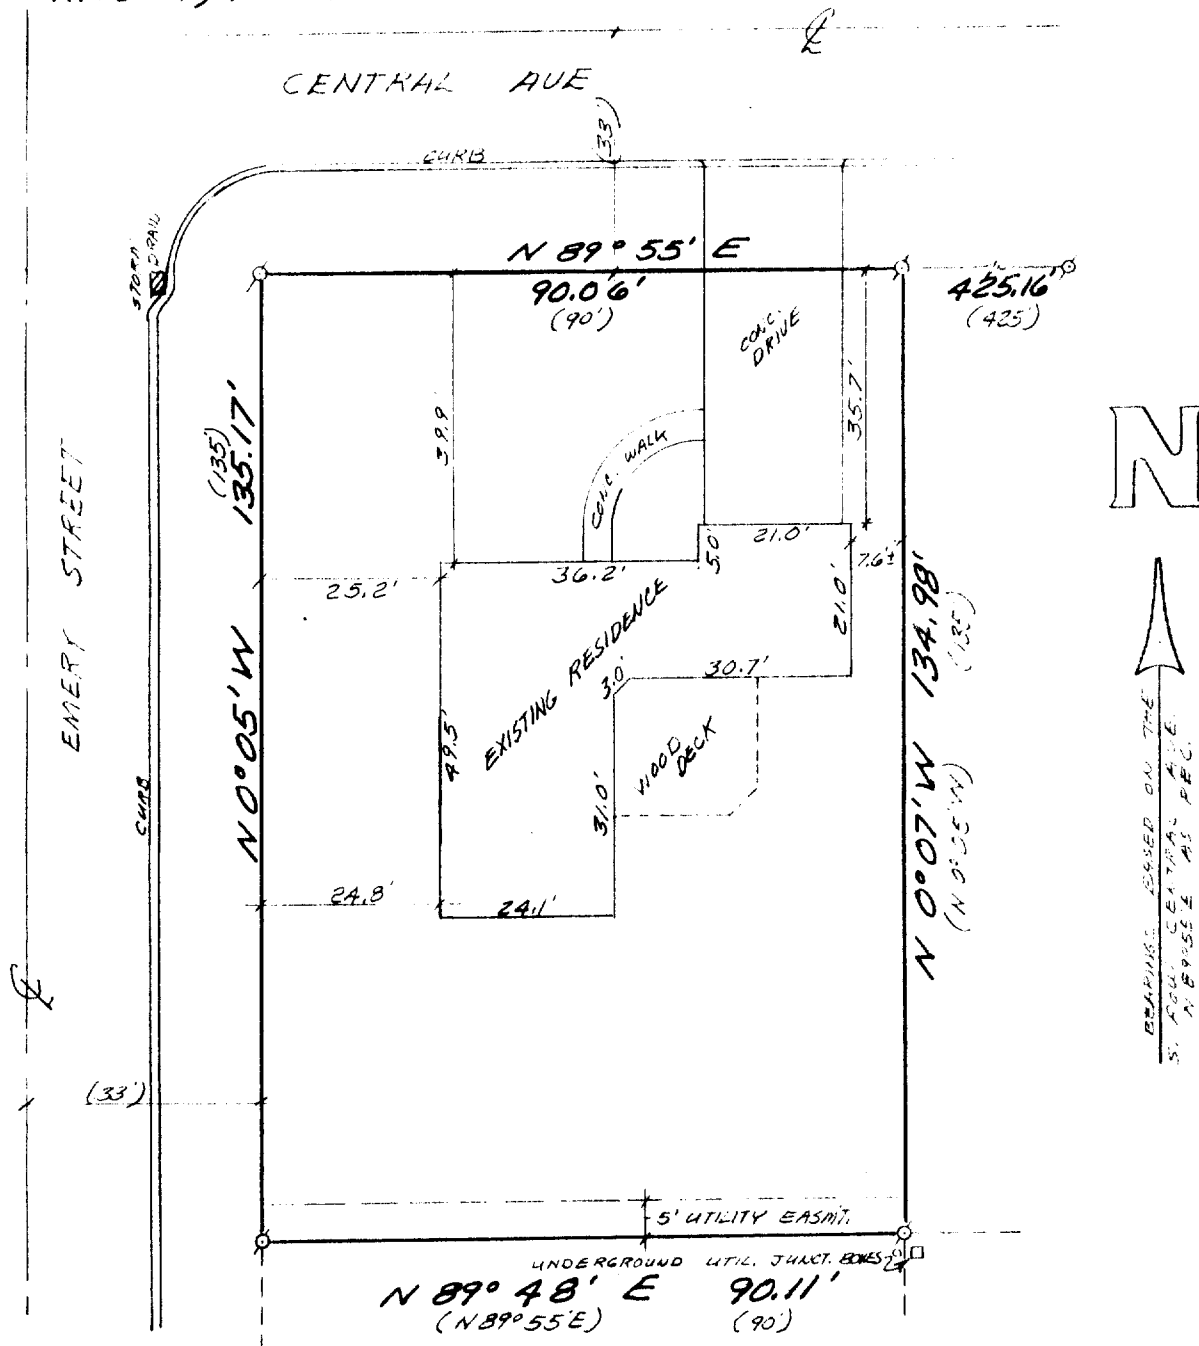

WORK ORDERED BY: ST. FRANCIS SAVINGS
 FOR
 BRADLEY & SUSAN SABRE

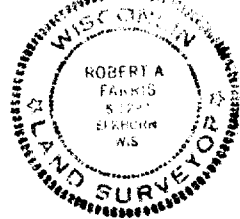

LEGEND

- ⊗ = Iron Pipe Survey Stake Found
- = Iron Pipe Survey Stake Set
- (XXX) = Record Dimension

MAP SCALE

CERTIFICATE

I hereby certify that the above described property has been surveyed under my direction and that the above map is a true representation thereof and shows the size and location of the property, its exterior boundaries, the location of all visible structures and dimensions of all principal buildings thereon, boundary fences, apparent easements, roadways and visible encroachments, if any. This survey is made for the use of the present owners of the property, and also for those who purchase, mortgage, or guarantee the title thereto within one (1) year from the date hereof.

Robert A. Farris
 Robert A. Farris, R.L.S.

Dated this 12 day of June, 1986

PROJECT NO. 2608

3-274