

This survey is made for the exclusive use of the present owners of the property, and also those who purchase, mortgage, or guarantee the title thereto, within one year from date hereof.



John F. Degan
John F. Degan, Lead Harvester # 242

PART OF LOT 2 OF BLOCK 7 OF THE ORIGINAL PLAT OF EAST TROY, MORE PARTICULARLY DESCRIBED AS FOLLOWS: COMMENCING AT THE INTERSECTION OF THE WEST LINE OF DIVISION STREET AND THE NORTH LINE OF MAIN ST. IN THE VILLAGE OF EAST TROY, WALWORTH COUNTY, WISCONSIN, THENCE S. 80°35' W., 121 FEET TO AN IRON STAKE AT THE SE CORNER OF THE HANSEN OIL COMPANY LAND, WHICH LAND IS MORE PARTICULARLY DESCRIBED IN DEED RECORDED IN VOL. 169 OF DEEDS ON PAGE 507, WALWORTH COUNTY RECORDS, THENCE N. 4° AND 25' W., ALONG THE EAST LINE OF THE AFORESAID HANSEN OIL COMPANY LAND, 43 FEET TO AN IRON STAKE; THENCE N. 89° E., 121.89 FEET TO A POINT IN THE WEST LINE OF DIVISION STREET; THENCE S. 1° AND 30' E., ALONG WEST LINE OF DIVISION STREET, 25.10 FEET TO PLACE OF BEGINNING.

ST. ADDRESS: 2097 DIVISION ST.

✦ = CROSS IN CONCRETE FOUND

BEARINGS RELATE TO EAST LINE OF SE 1/4
OF SECTION 19-4 -18 WHICH WAS ASSUMED AS NORTH.

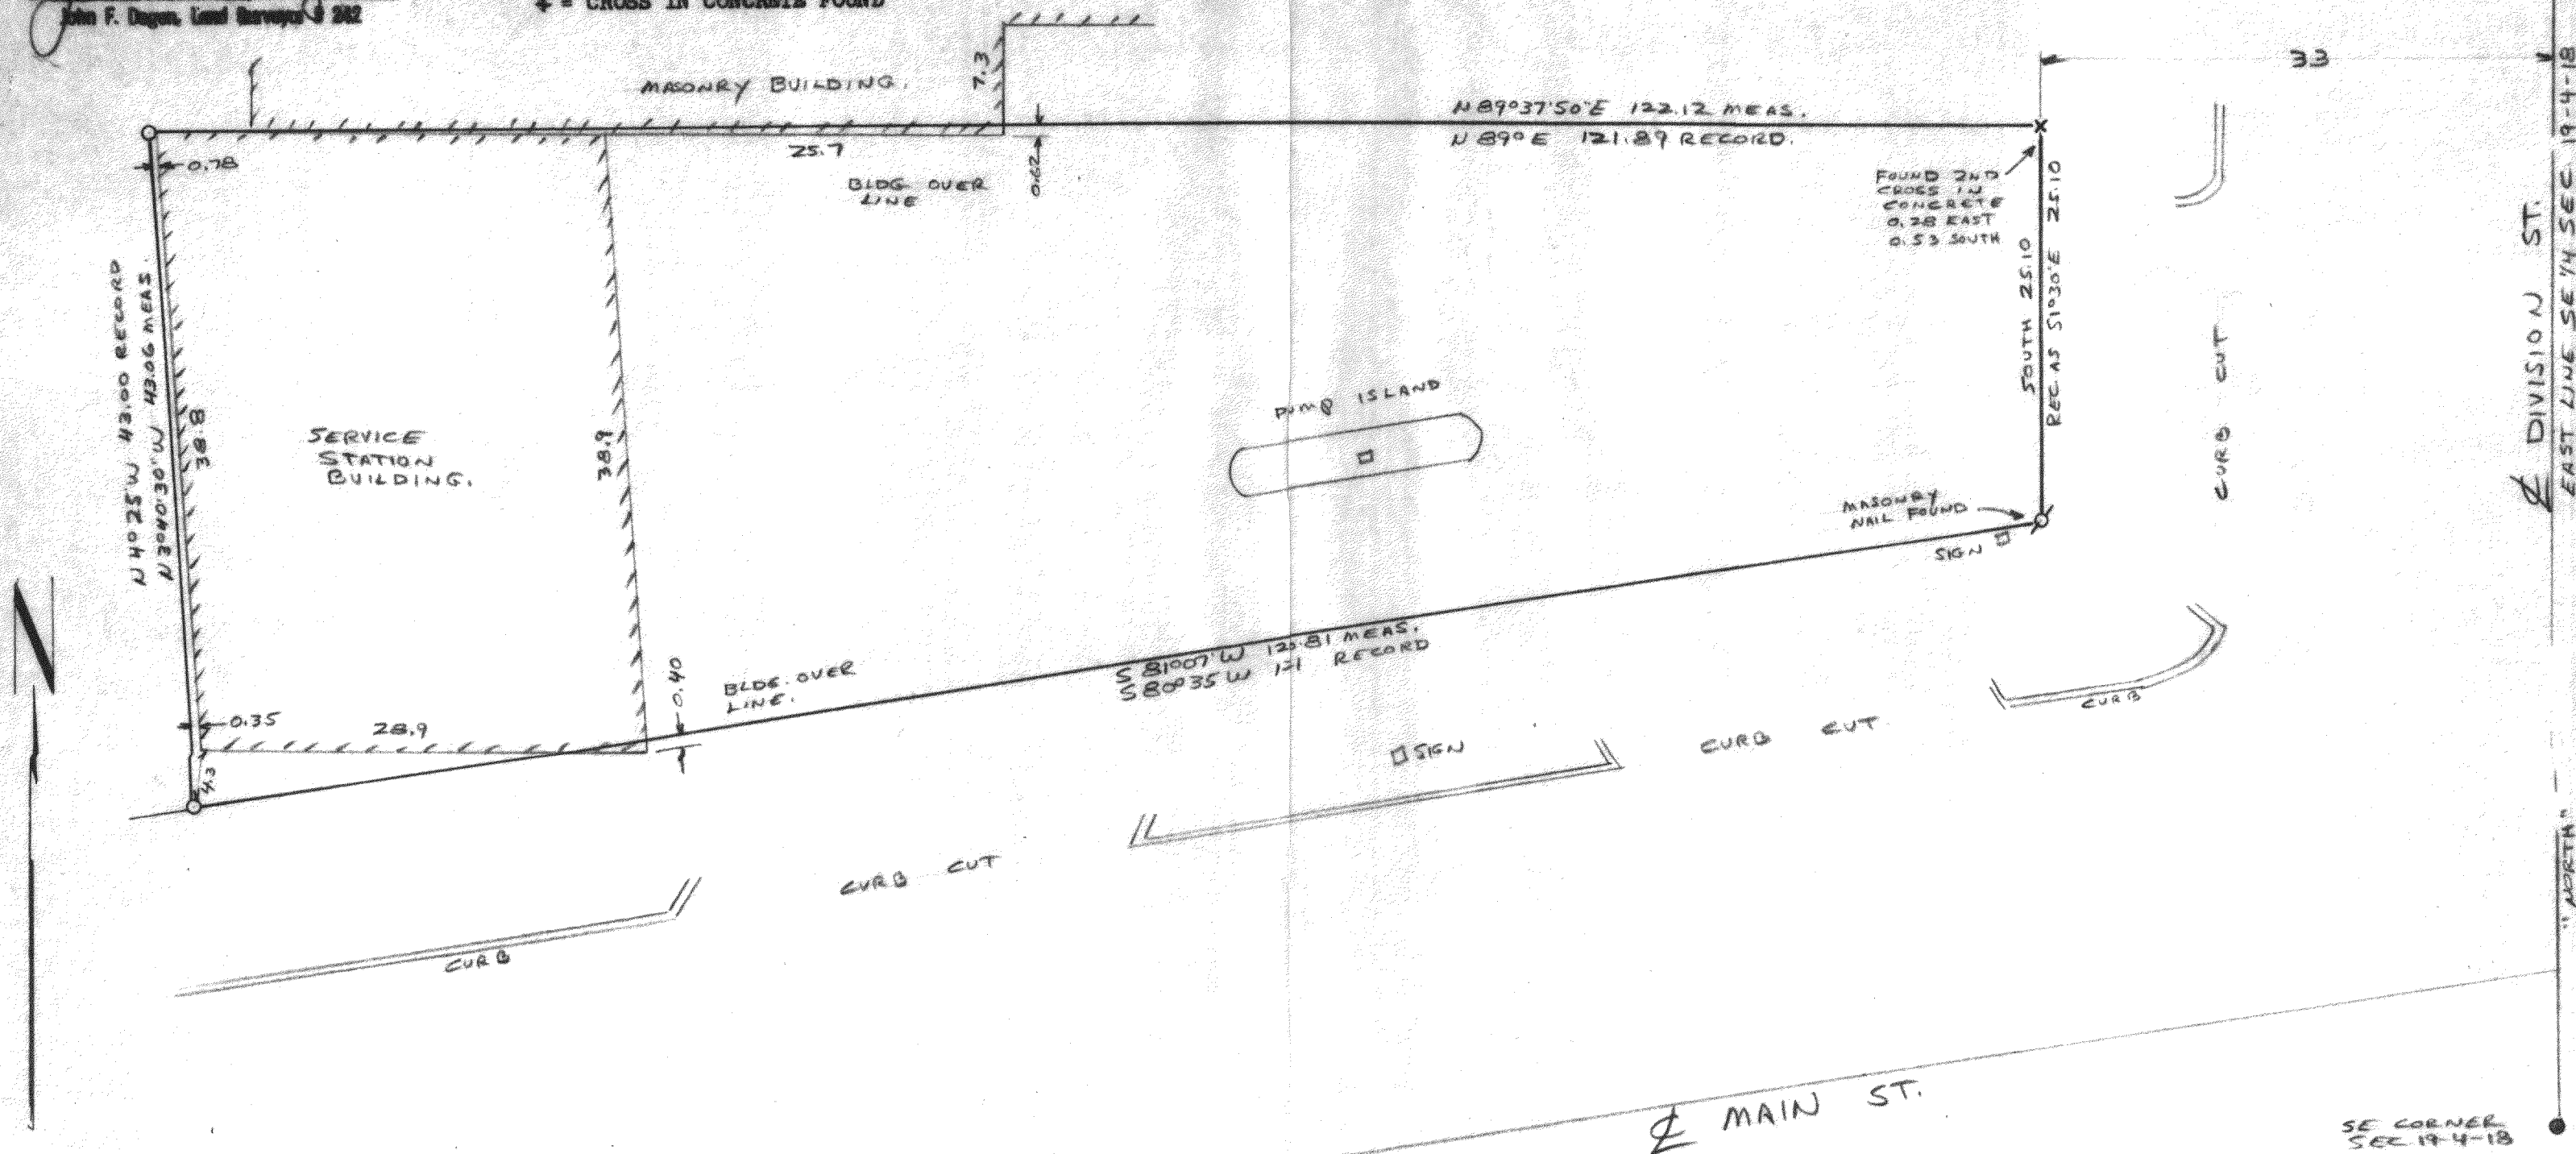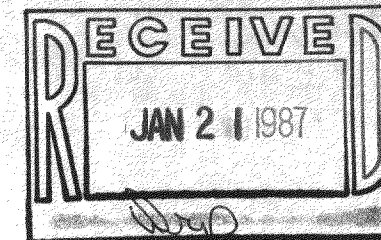

20P-72

SE CORNER
SEE 19-4-18

3296

11-D #13