


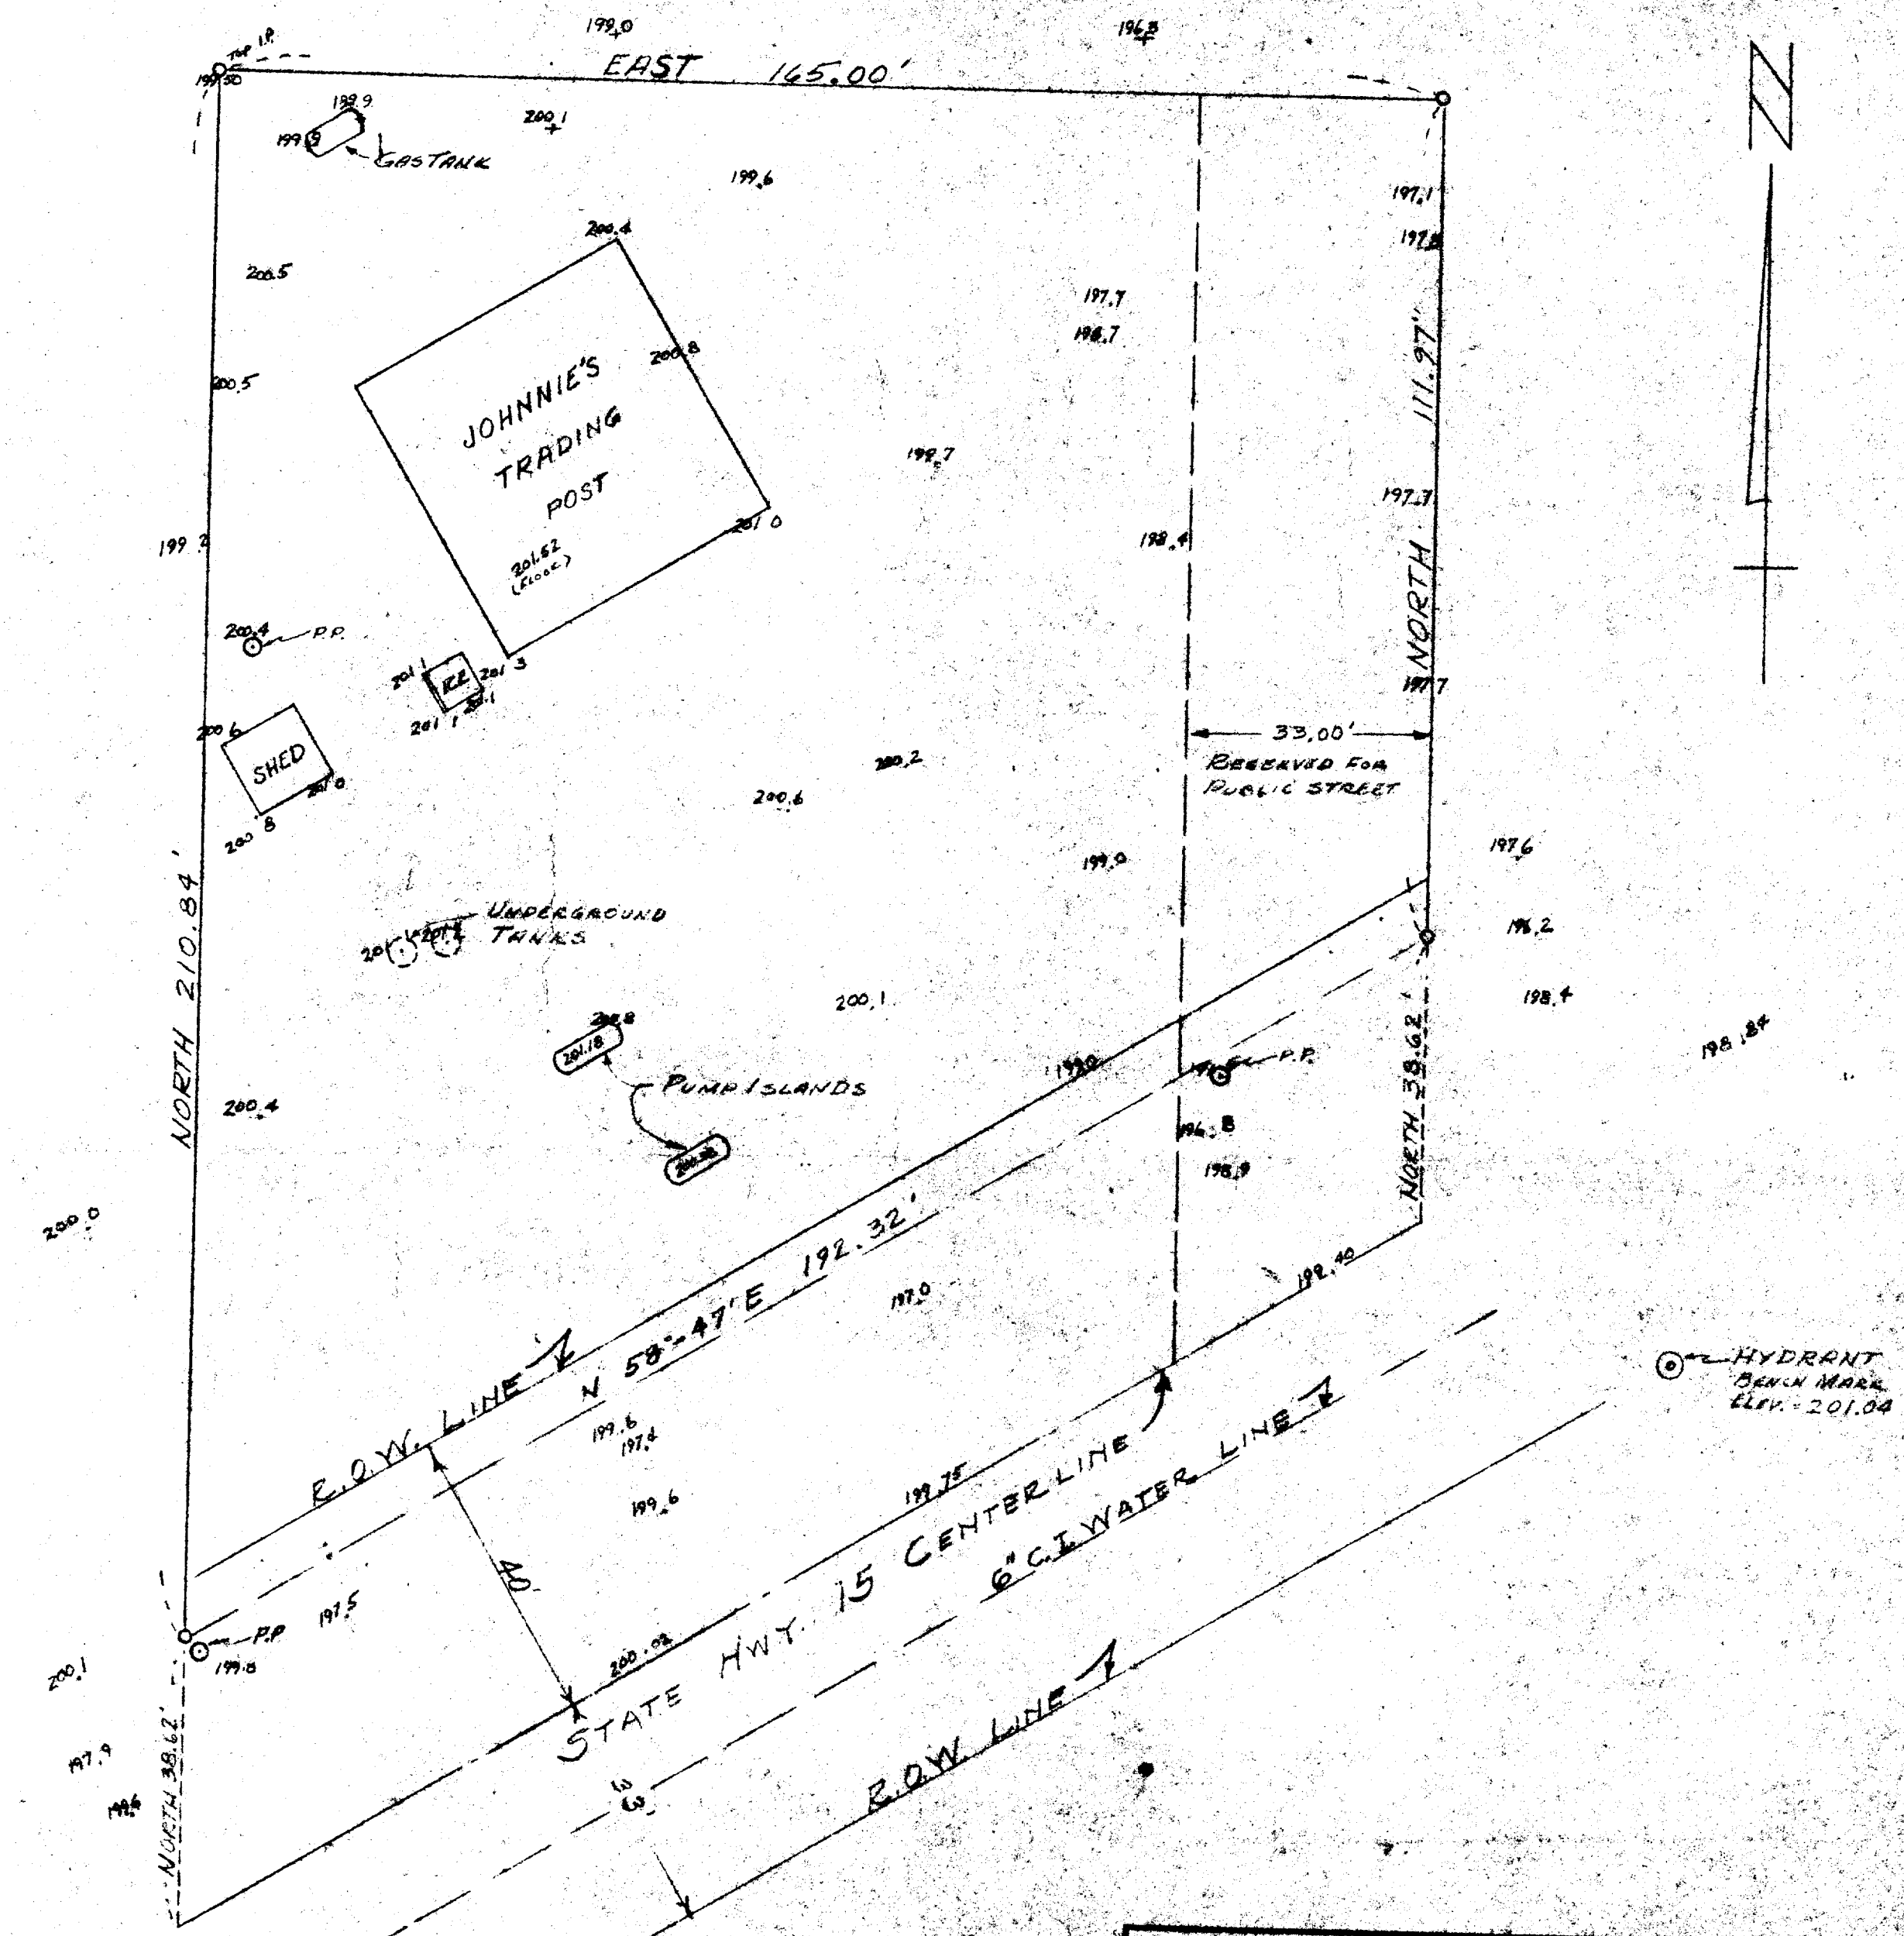

PLAT OF SURVEY
OF
JOHN R. BARNES PROPERTY
 LOCATED IN THE NE 1/4 SW 1/4 SECTION 20,
 T 4 N, R 18 E, VILLAGE OF EAST TROY,
 WISCONSIN

3-29-73

UP-136