


SURVEYING

MEMBER

ASSOCIATES, INC.

2554 N. 100th STREET
WAUWATOSA, WISCONSIN 53226

FREDERICK W. SHIBILSKI RLS
(414) 257-2212

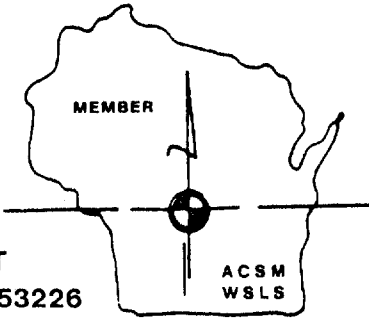


PLAT OF SURVEY
-of-

All of Block 4, of the Village of East Troy, Walworth County, Wisconsin, excepting therefrom the following premises: (1) a strip of land 4-1/2 rods wide North and South off the North side of Block 4 of the Village of East Troy, according to the plat of said Village recorded in the office of the Register of Deeds of the said County of Walworth. (2) Beginning at Southwest corner of Block 4 of the Original Plat of Village of East Troy, running thence North 112 feet to cement sidewalk, thence East parallel with South line of said Block 4 to East line of said Block thence South to Southeast corner of said Block thence West to place of beginning. (3) Beginning in the East line of Block 4 of the Original Plat of the Village of East Troy, at a point 74 feet and 3 inches South of the Northeast corner of said Block, being the Southeast corner of lands now owned by Winifred Wendt, thence West 78 feet, parallel with the North line of said Block, to the Southwest corner of lands now owned by the said Winifred Wendt, thence South parallel with the East line of said Block, 77.75 feet to the North line of lands formerly owned by William H. Johnson, thence East parallel with North line of said Block 78 feet to the East line of said Block, thence North along the East line of said Block 77.75 feet to the place of beginning. (4) Commencing in the East line of Block 4 of the Original Plat of the Village of East Troy, at a point 74 feet and 3 inches, South of the Northeast corner of said Block, being the Southeast corner of lands owned by Winifred Wendt, thence West 78 feet parallel with the North line of said Block, to the Southwest corner of lands owned by the said Winifred Wendt, for a place of beginning. Thence continue West 7 feet parallel with the North line of said Block, thence South parallel with the East line of said Block 77.75 feet to a point; thence East 7 feet parallel with the North line of said Block to a point; thence North parallel with the East line of said Block 77.75 feet to the place of beginning.

Survey location: 2062 Division Street Buyer: Steve Winter & Mary Kirchoff

DIVISION STREET

66' WIDE

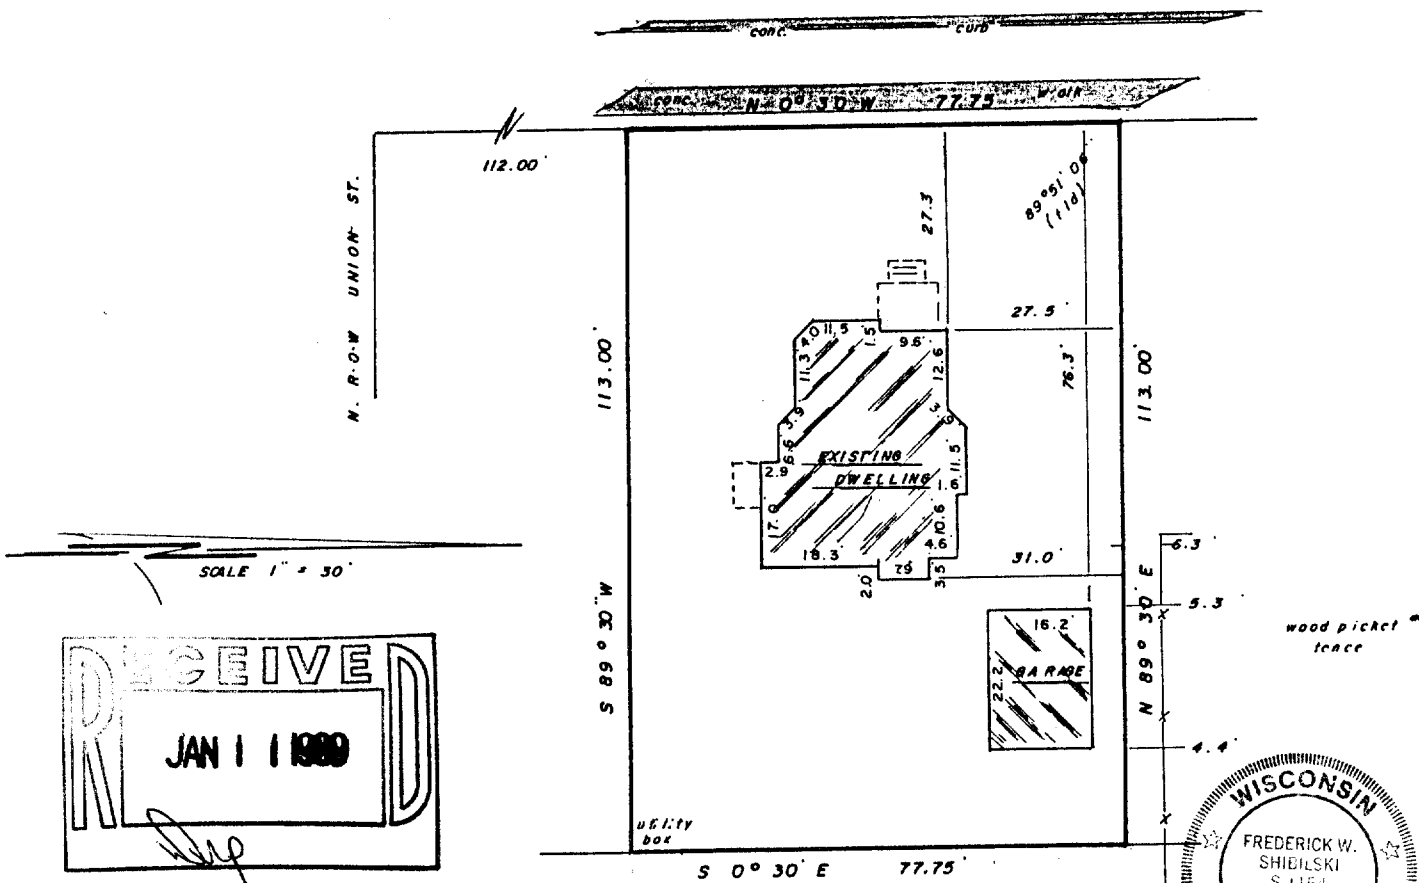

Surveyed for: WAUWATOSA MORTGAGE CORP.

"I hereby certify that I have surveyed the above described property and that the above map is a true representation thereof and shows the size and location of the property, its exterior boundaries, the location of all visible structures and dimensions of all principal buildings thereon, boundary fences, apparent easements, roadways and encroachments, if any.

"This survey is made for the use of the present owners of the property, and also those who purchase, mortgage, or guarantee the title thereto within one year from date hereof."

MONUMENTATION BY WRITTEN AGREEMENT WITH THE ABOVE NAMED CLIENT (HAS NOW) BEEN WAIVED IN ACCORDANCE WITH A-E 5.01 (1) (b) OF THE WISCONSIN ADMINISTRATIVE CODE



"THIS IS NOT AN ORIGINAL SURVEY UNLESS THIS SEAL IS RED."

3-307

Frederick W. Shibilski
WISCONSIN REGISTERED LAND SURVEYOR

OCT. 27, 1986
DATE

lep / dlt
FIELD WORK BY

mdn
DRAWN BY

14397
JOB NUMBER