

Farris, Hansen & Associates, Inc.

7 RIDGEWAY COURT, P.O. BOX 437, ELKHORN, WISCONSIN

TEL. 414-723-2098



LOCATION: LOT 69 OF TROYJENS SUBDIVISION ADDITION NO. ONE,
IN SECTION 19, T.4N., R.18E. VILLAGE OF EAST TROY,
WALWORTH COUNTY, WISCONSIN

WORK ORDERED BY: HACKBARTH BUILDERS

RESIDENCE FOR HOWARD & ANN KALLIO

MAP LEGEND

- = IRON PIPE STAKE FOUND
- = IRON PIPE STAKE SET
- = IRON ROD STAKE FOUND
- = IRON ROD STAKE SET
- = CONCRETE MONUMENT FOUND
- (XXXXX) = RECORD DIMENSION
- X = NAIL SET ON LOT LINE ON FOUNDATION WALL EXT.

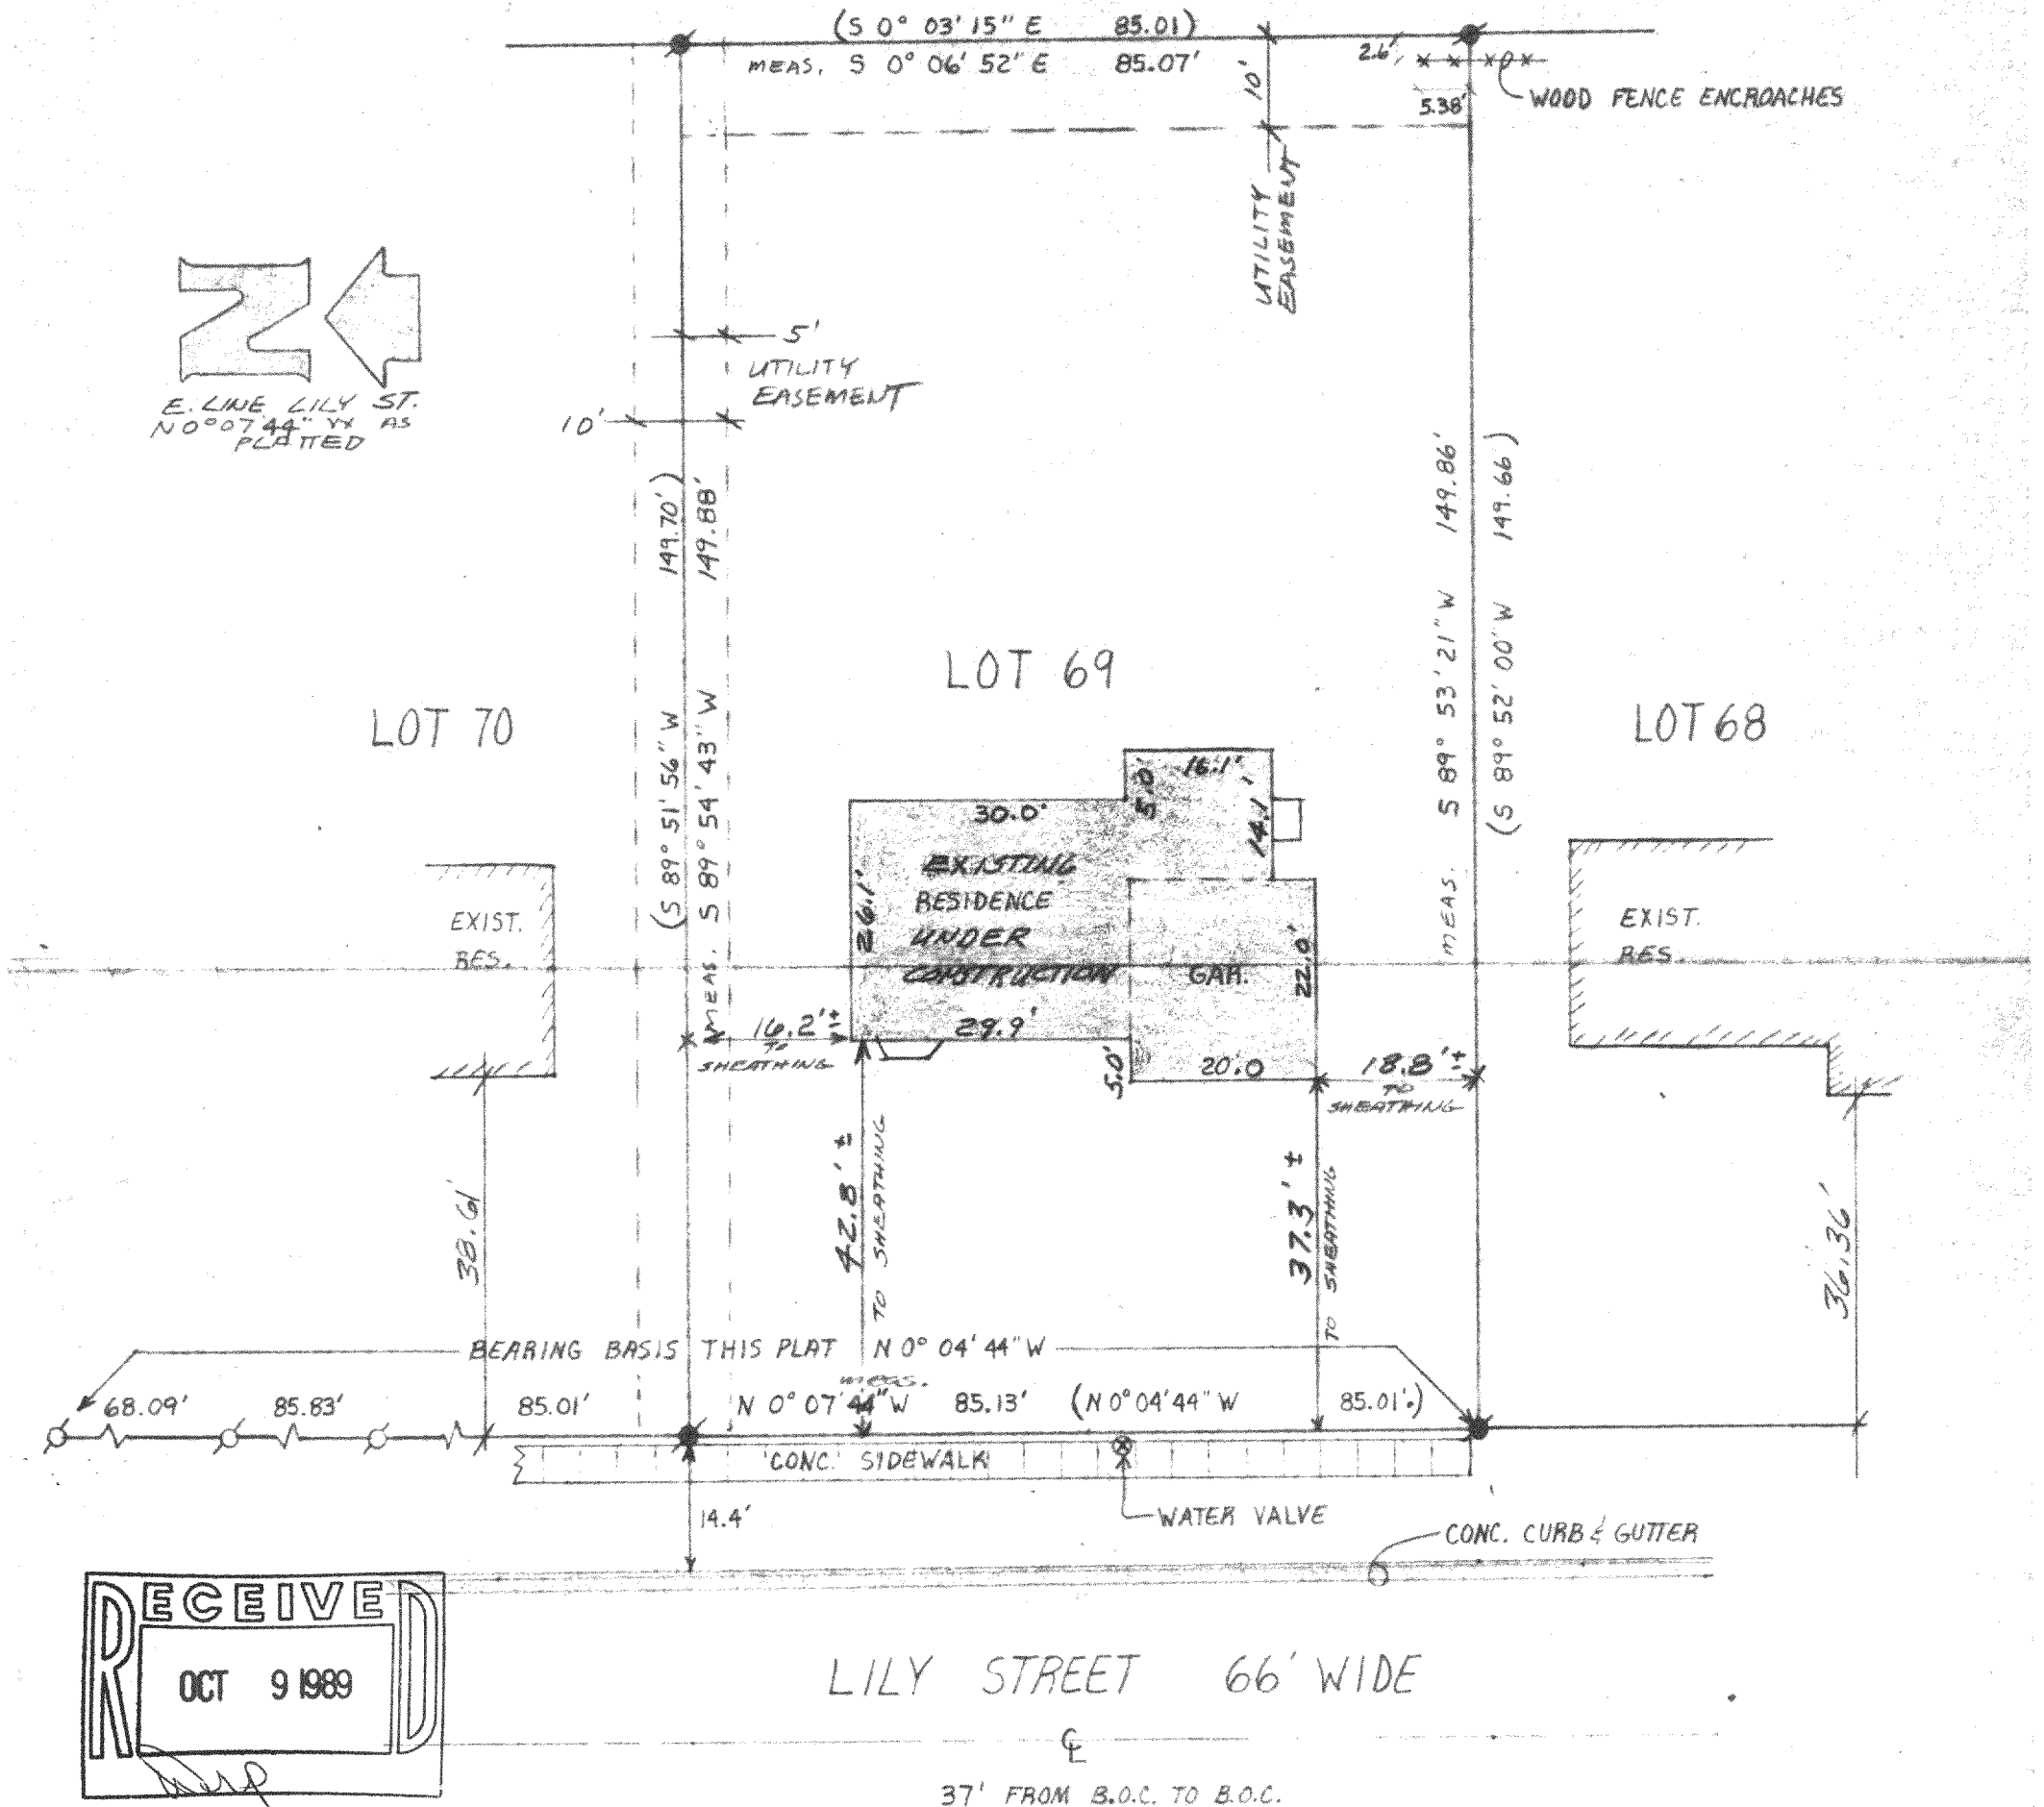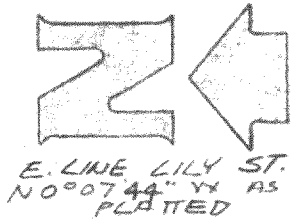


NOTE: COPIES OF THIS MAP TO WHICH THE FOLLOWING CERTIFICATE WILL APPLY ARE BLUE LINE PRINTS SHOWING SURVEYOR'S SEAL AND SIGNATURE IN BLACK INK. COPIES BY ANY OTHER MEANS MAY HAVE ALTERATIONS WHICH DO NOT REPRESENT THE SURVEYOR'S WORK PRODUCT.

I hereby certify that the above described property has been surveyed under my direction and that the above map is a true representation thereof and shows the size and location of the property, its exterior boundaries, the location of all visible structures and dimensions of all principal buildings thereon, boundary fences, apparent easements, roadways and visible encroachments, if any. This survey is made for the use of the present owners of the property, and also those who purchase, mortgage, or guarantee the title thereto within one year from the date hereof.

DATED: 6/19/89

REVISED: 7/31/89 TO SHOW RESIDENCE UNDER CONSTRUCTION

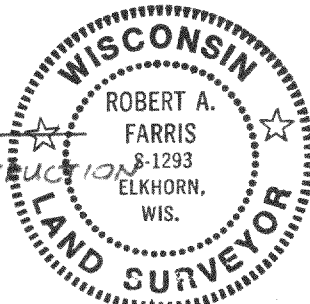

PROJ. NO. 3243