


PLAT OF SURVEY
OF
LOT 10, LYNNDALE SUBDIVISION
VILLAGE of EAST TROY
WALWORTH COUNTY, WISCONSIN

HILLTOP DRIVE (66' WIDE)

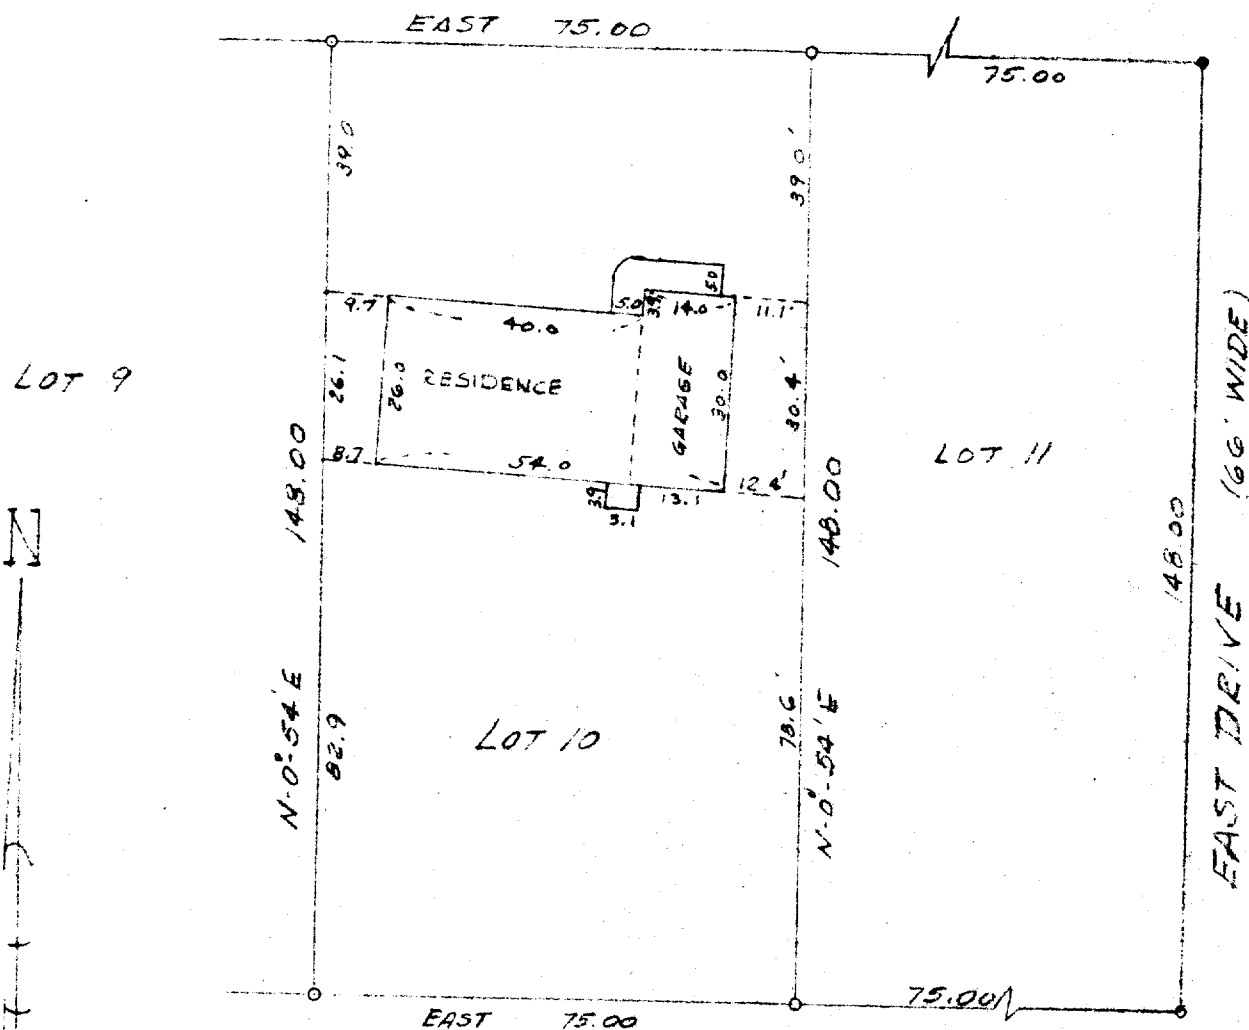

SURVEY AND PLAT BY
JENSEN & JOHNSON
 CIVIL ENGINEERS AND SURVEYORS
 Elkhorn, Wisconsin

LEGEND

- — Iron Pipe
 - — Concrete Monument
- Scale 1" = 30'

WE CERTIFY: That we have surveyed the above described property and that the plat shown hereon is an accurate survey and a true representation thereof and correctly shows the exterior boundary lines and all divisions of said property, and all buildings located thereon.

Date DECEMBER 8, 1960 Lloyd L. Jensen
 LLOYD L. JENSEN, Partner

Wisconsin Registered Land Surveyor, No. S-211

RLS-10