



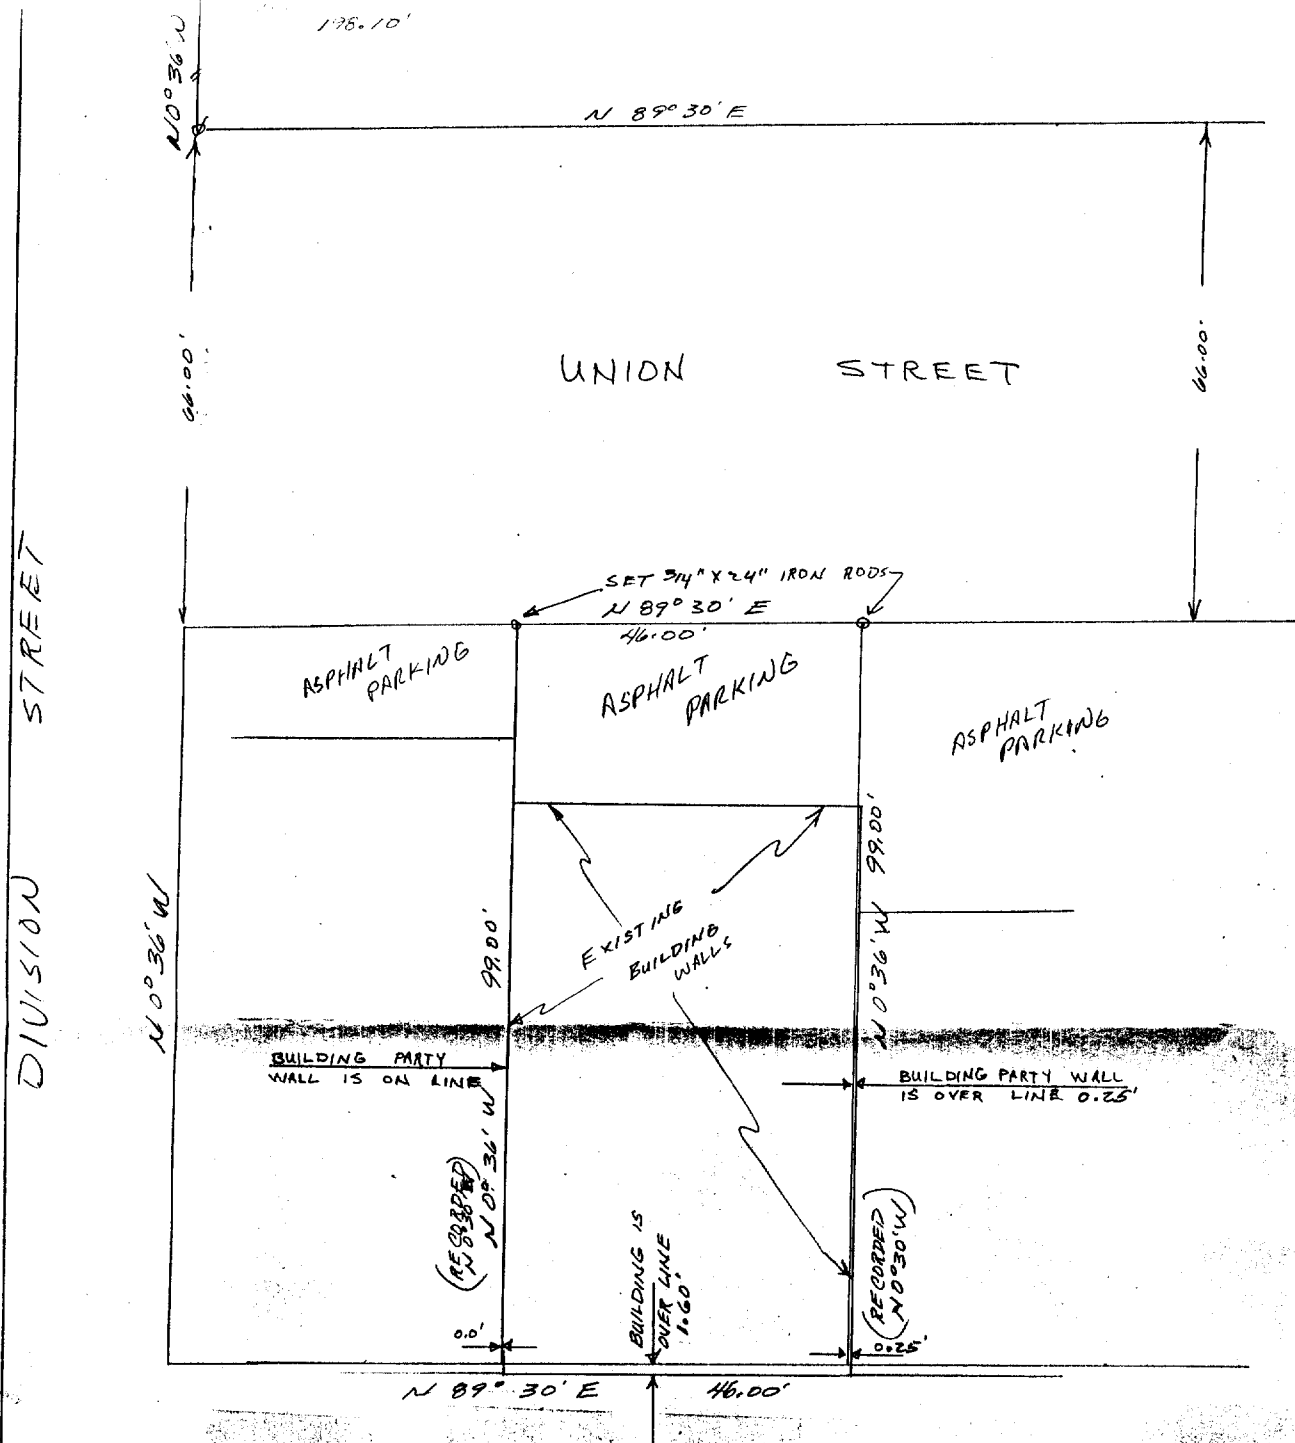

PLAT OF SURVEY OF WEST 1/2 OF LOT 3, LOT 4,
AND THE EAST 6 FEET OF LOT 5, BLOCK 6, ORIGINAL
PLAT OF VILLAGE OF EAST TROY, WALWORTH COUNTY,
WISCONSIN.

SCALE 1"=20'

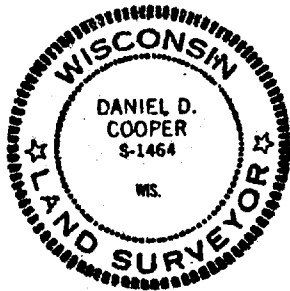


I hereby certify that I have surveyed the
property described hereon and that the
map shown hereon is a true and accurate
representation thereof to the best of my
professional knowledge and belief.

Dated this 26th day of July, 1989

Daniel D. Cooper
Daniel D. Cooper, RLS No. 3-1464

D. Cooper & CO., INC
Rt 4 Box 508B • Elkhorn WI 53121

DRAWING NO. 3508

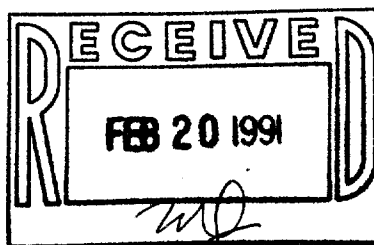

Reduced

TAX KEY #

ROP 00061