



**ABELL**  
**SURVEYING & MAPPING**  
**DELAVAL, WISCONSIN 53115**  
**414-728-6787**

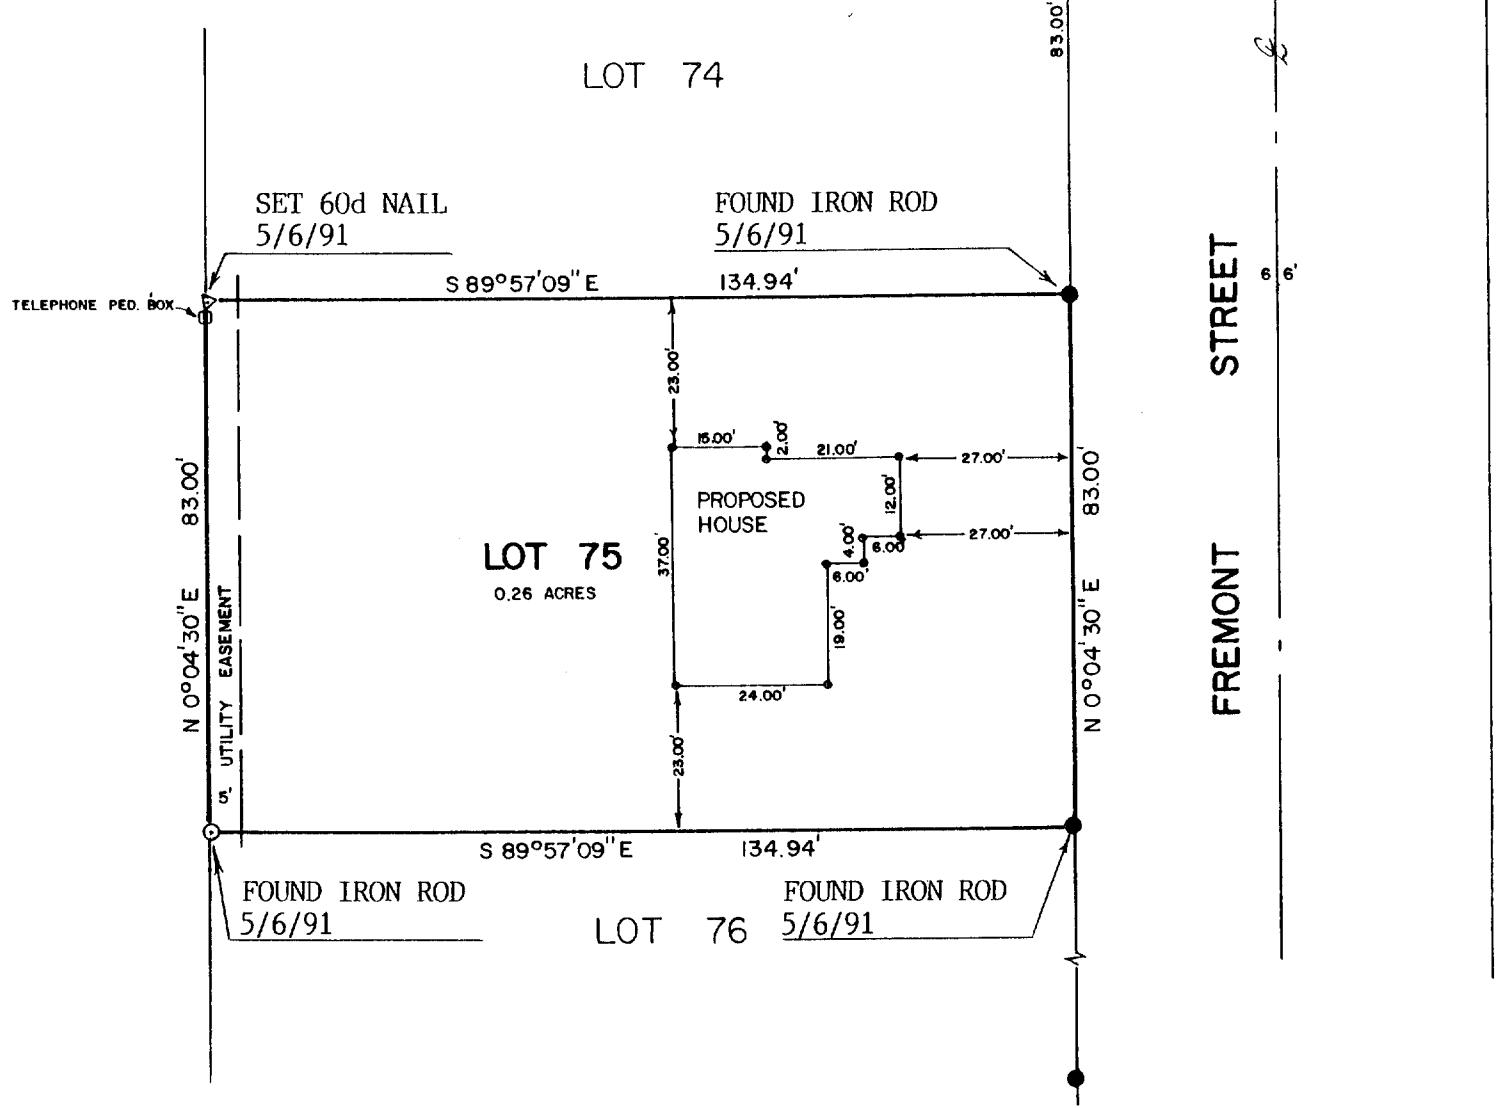

PLAT OF SURVEY OF

LOT 75 OF LYNNDALE SUBDIVISION ADDITION NO. 2, LOCATED  
IN THE VILLAGE OF EAST TROY, WALWORTH COUNTY, WISCONSIN.

ORDERED BY: HACKBARTH BUILDERS  
1823 FREMONT STREET  
EAST TROY, WI. 53120

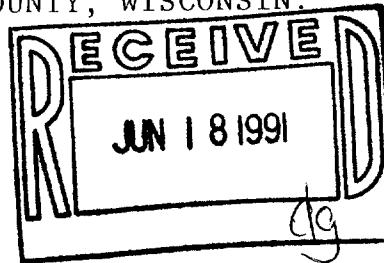

NOTE: BEARINGS ARE AS SHOWN ON THE SUBDIVISION PLAT.

REVISED: MAY 6, 1991 TO SHOW THE LOCATION OF THE  
PROPERTY CORNERS ONLY.

ORDERED BY: SUE JENSEN  
EAST TROY, WI.



I HEREBY CERTIFY THAT I HAVE SURVEYED THE ABOVE DESCRIBED PROPERTY AND THAT THE  
ABOVE MAP IS A TRUE REPRESENTATION THEREOF AND SHOWS THE SIZE AND LOCATION OF  
THE PROPERTY, ITS EXTERIOR BOUNDARIES, THE LOCATION OF ALL VISIBLE STRUCTURES  
AND DIMENSIONS OF ALL PRINCIPAL BUILDINGS THEREON, BOUNDARY FENCES, APPARENT  
EASEMENTS, ROADWAYS AND VISIBLE ENCROACHMENTS, IF ANY, TO THE BEST OF MY  
KNOWLEDGE AND BELIEF.

SCALE - 1"=30'

LEGEND

- - IRON ROD FOUND
- - IRON ROD SET
- △ - 12" NAIL SET  $\pm 0.2'$
- - 60 PENNY NAIL SET

NORTH OF TELE. PED. *David F. Abell*  
DAVID F. ABELL  
WISCONSIN REGISTERED LAND SURVEYOR, S-1596

March 16, 1990  
 DATE: *March 16, 1990* JOB NUMBER - 90040  
 NOTE: THIS IS NOT A CERTIFIED COPY UNLESS SEALED.