


PLAT OF SURVEY

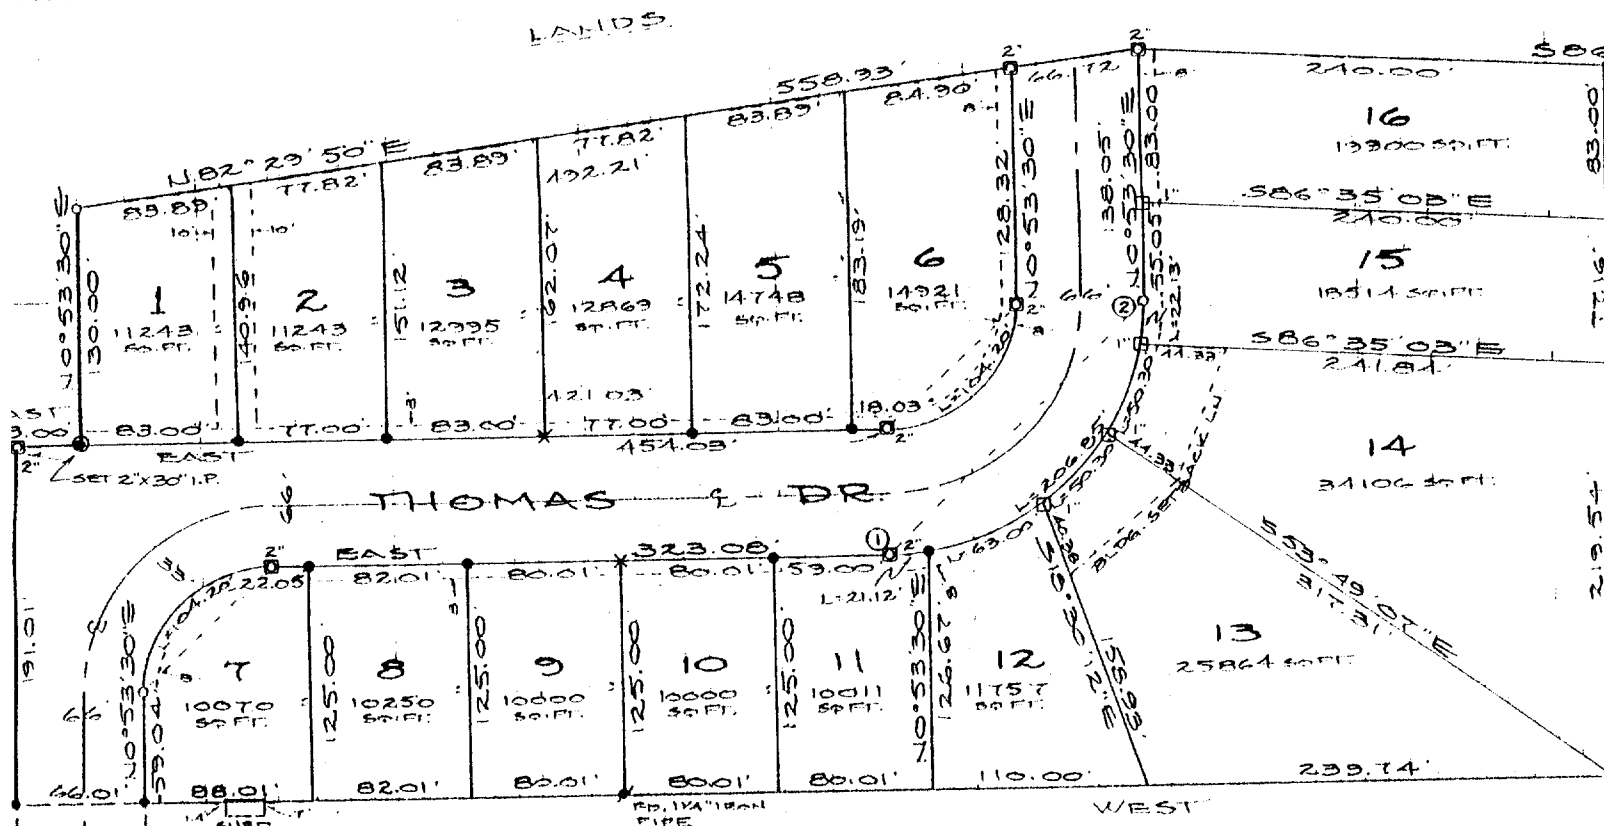

□ Found Iron Pipes

• Set 1"x24" Iron Pipe

x Scratched x in steel transformer box

	CURVE NO.	CENTRAL ANGLE	RADIUS	BEARING	CHORD DISTANCE
Lot 6		89°06'30"	67.00'	N45°26'45"E	94.01'
Lot 7		89°06'30"	67.00'	N45°26'45"E	94.01'
Lot 17		293°15'16"	60.00'	WEST	66.01'
1-2		89°06'30"	133.00'	N45°26'45"E	186.62'
Lot 11		9°05'54"	"	N85°27'03"E	21.10'
Lot 12		27°08'24"	"	N67°19'54"E	62.41'
Lot 13		21°40'08"	"	N42°55'38"E	50.00'
Lot 14		21°40'08"	"	N21°15'30"E	50.00'
Lot 15		9°31'56"	"	N5°39'28"E	22.10'

SCALE - 1" = 100'

Plat of Survey to reset lot corners removed during utility installation on Thomas Drive for Lots 1-12 GLENN VIEW ESTATES in Section 20, Village of East Troy, Walworth County, WI.



CERTIFICATION

I hereby certify that the property described above has been surveyed under my responsible direction and supervision and that this map is a correct representation of the lot lines and dimensions.

Date 7-9-90

James B. Woodman
Registered Land Surveyor S-1239

Prepared for: Neumann Developments
4450 Milton Avenue
Janesville, WI 53545
and
Wisconsin Electric Power Co.
Attn: Jim Clapel
700 Kane St.
Burlington, WI 53105

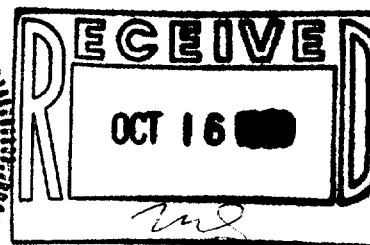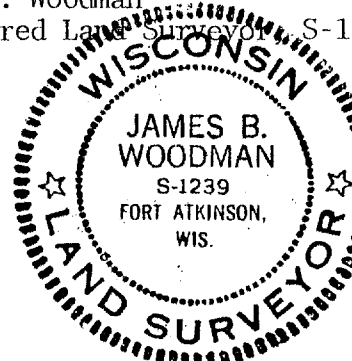

JN 88S-158

WOODMAN, ANDERSON & ASSOCIATES

210 Madison Avenue, Fort Atkinson, WI 53538

Registered Land Surveyors

Phone (414) 563-8162

RCN 10041