


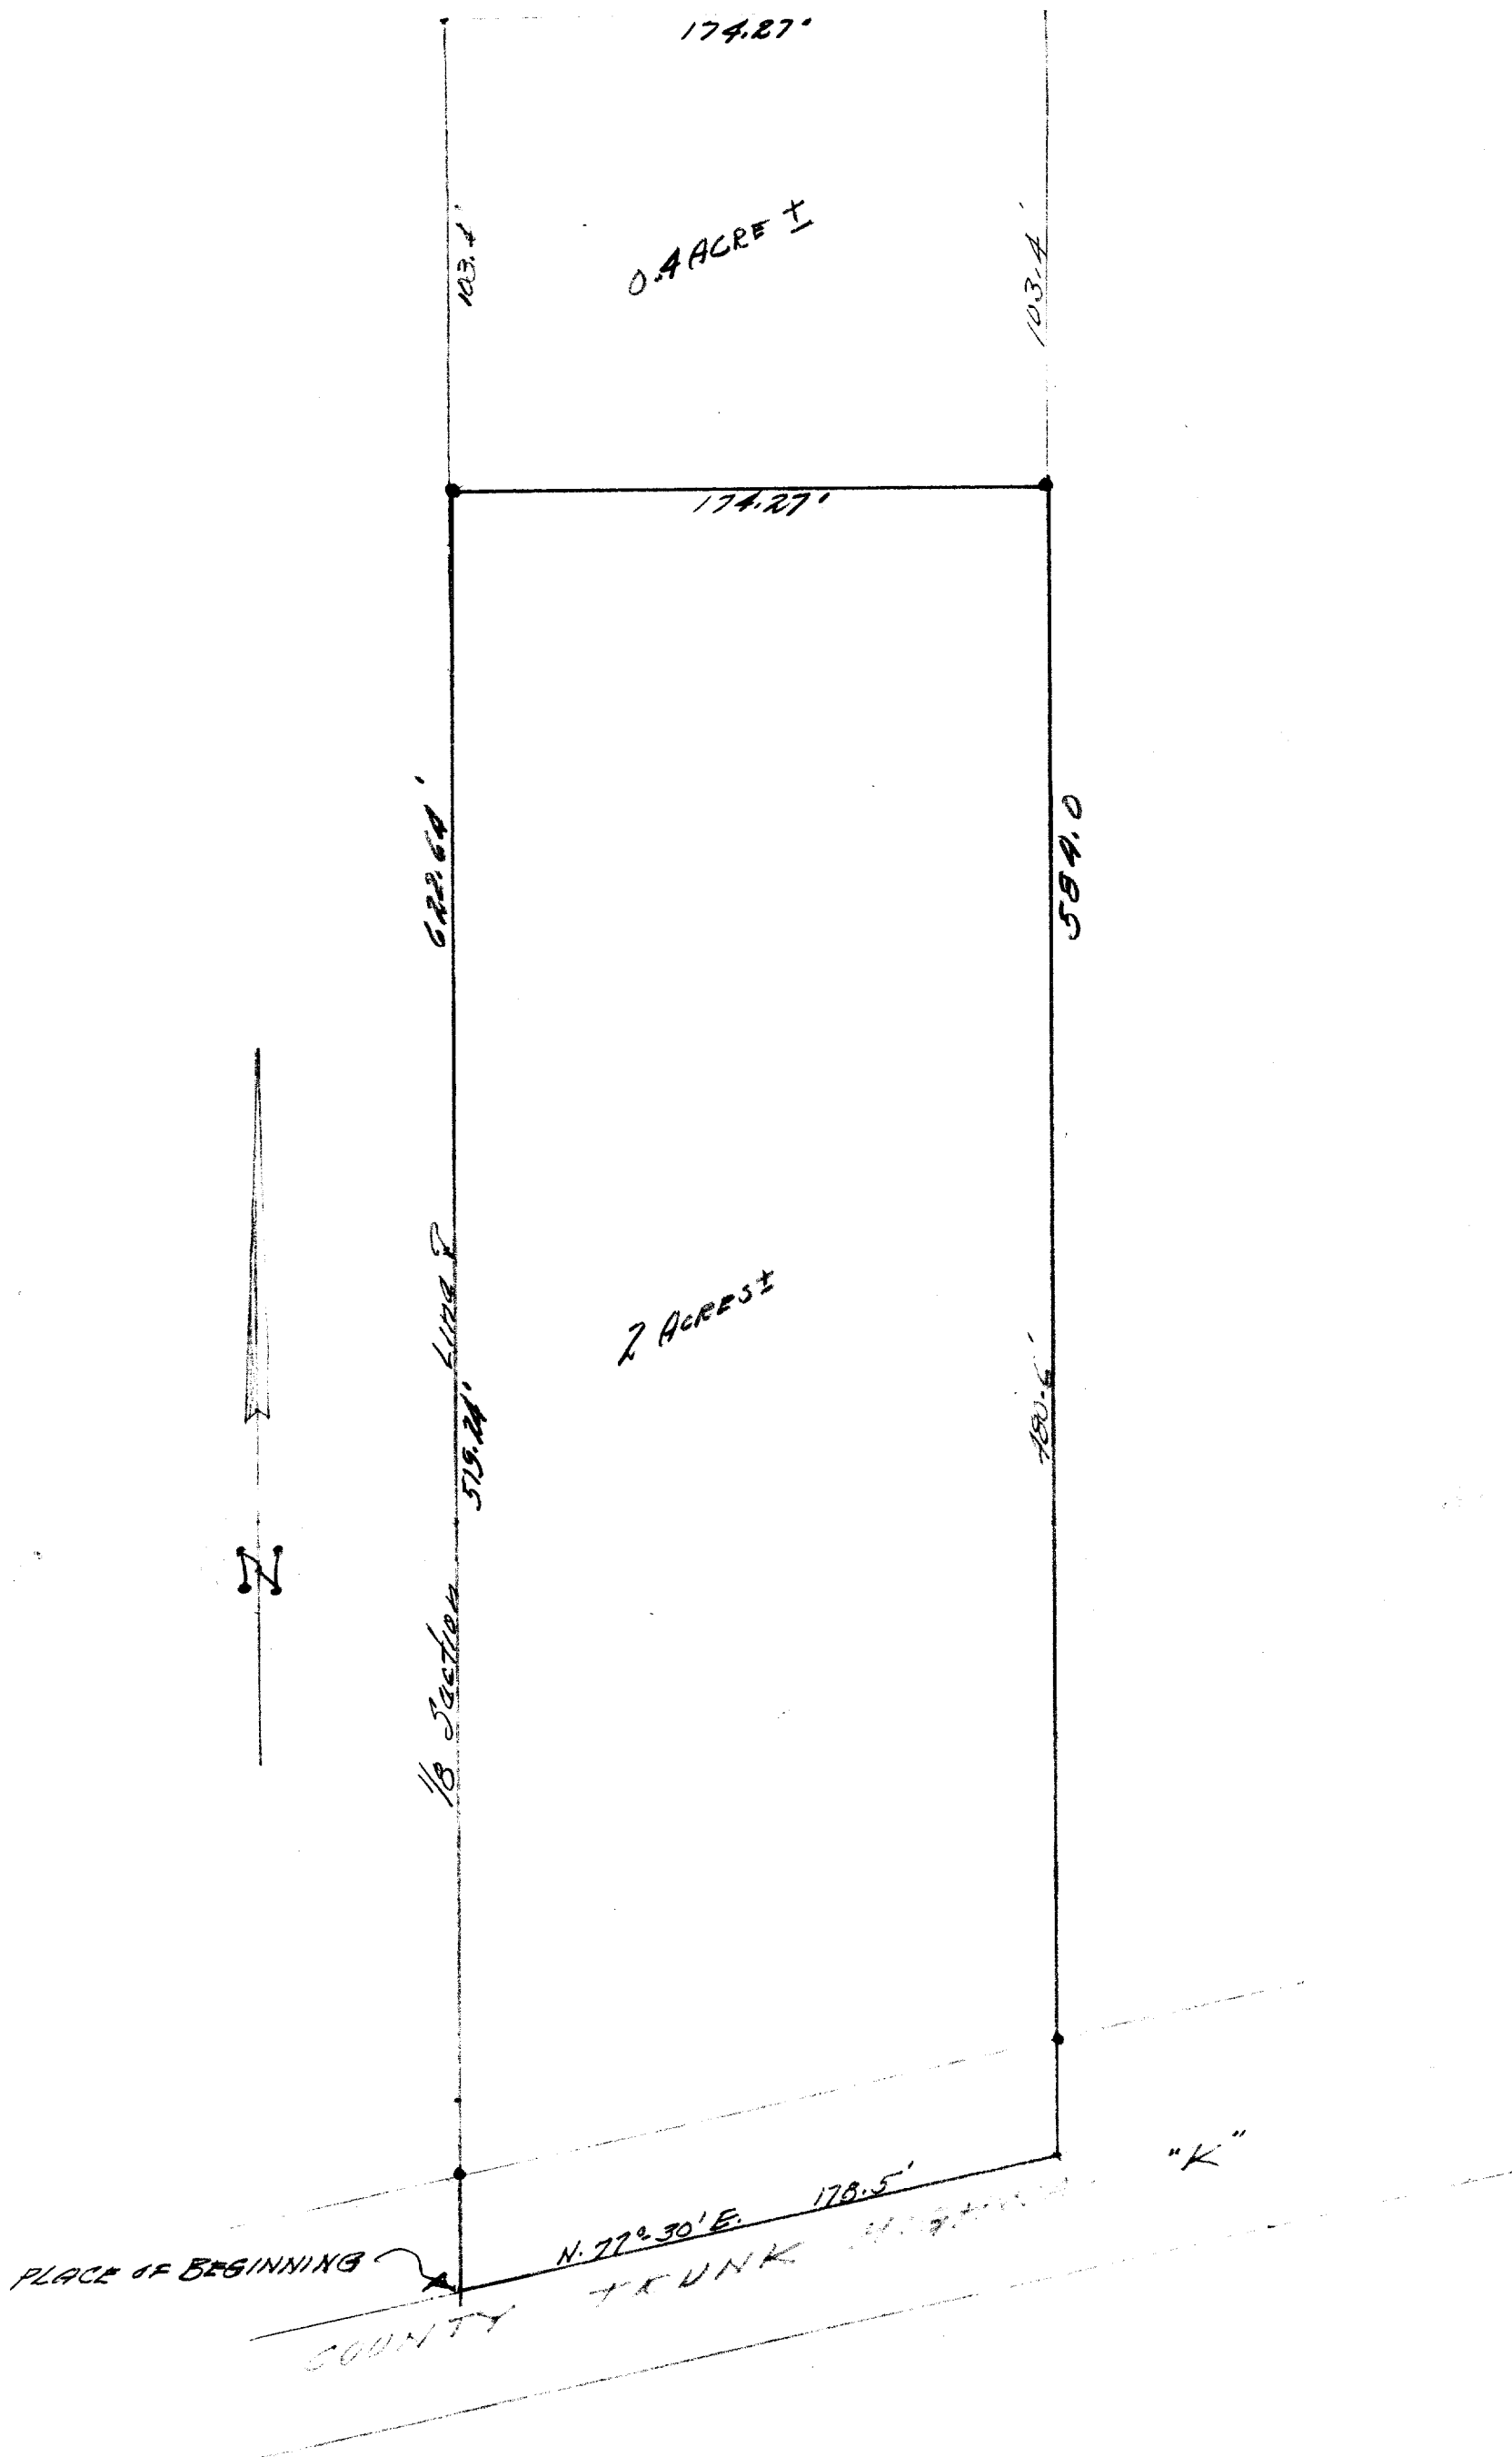

DESCRIPTION:

Commencing at a point where the centerline of County Trunk Highway "K" intersects the East, N. and S. 1/8 section line of Section 19, Town 4 north, Range 18 east of the 4th P. M., thence N. 77° 30' E., along the centerline of said highway 178.5 feet to a point, thence North 480.6 feet to an iron stake, thence West 174.27 feet to an iron stake, thence South 519.24 feet to the place of beginning. Containing 2 acres more or less.

CERTIFICATE:

I, hereby certify that I have on this the 26th day of July 1947, surveyed the above described property according to the official records on file in the office of the Recorder of Deeds in and for Walworth County Wisconsin and find that the measurements and bearings of the boundary lines of said property substantially agree with those in the above description and that no encroachments exist.

SIGNED AND SEALED THIS 1ST DAY OF AUGUST 1947.

Joseph M. Biagi
Joseph M. Biagi, Professional Engineer.
Elkhorn Wisconsin.