
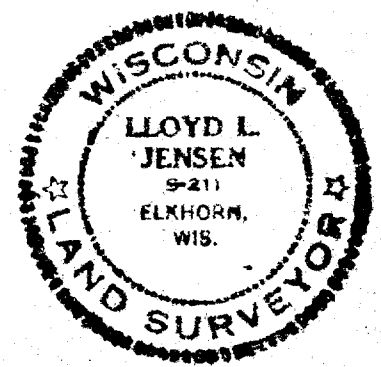


FRONT STREET
36' WIDE

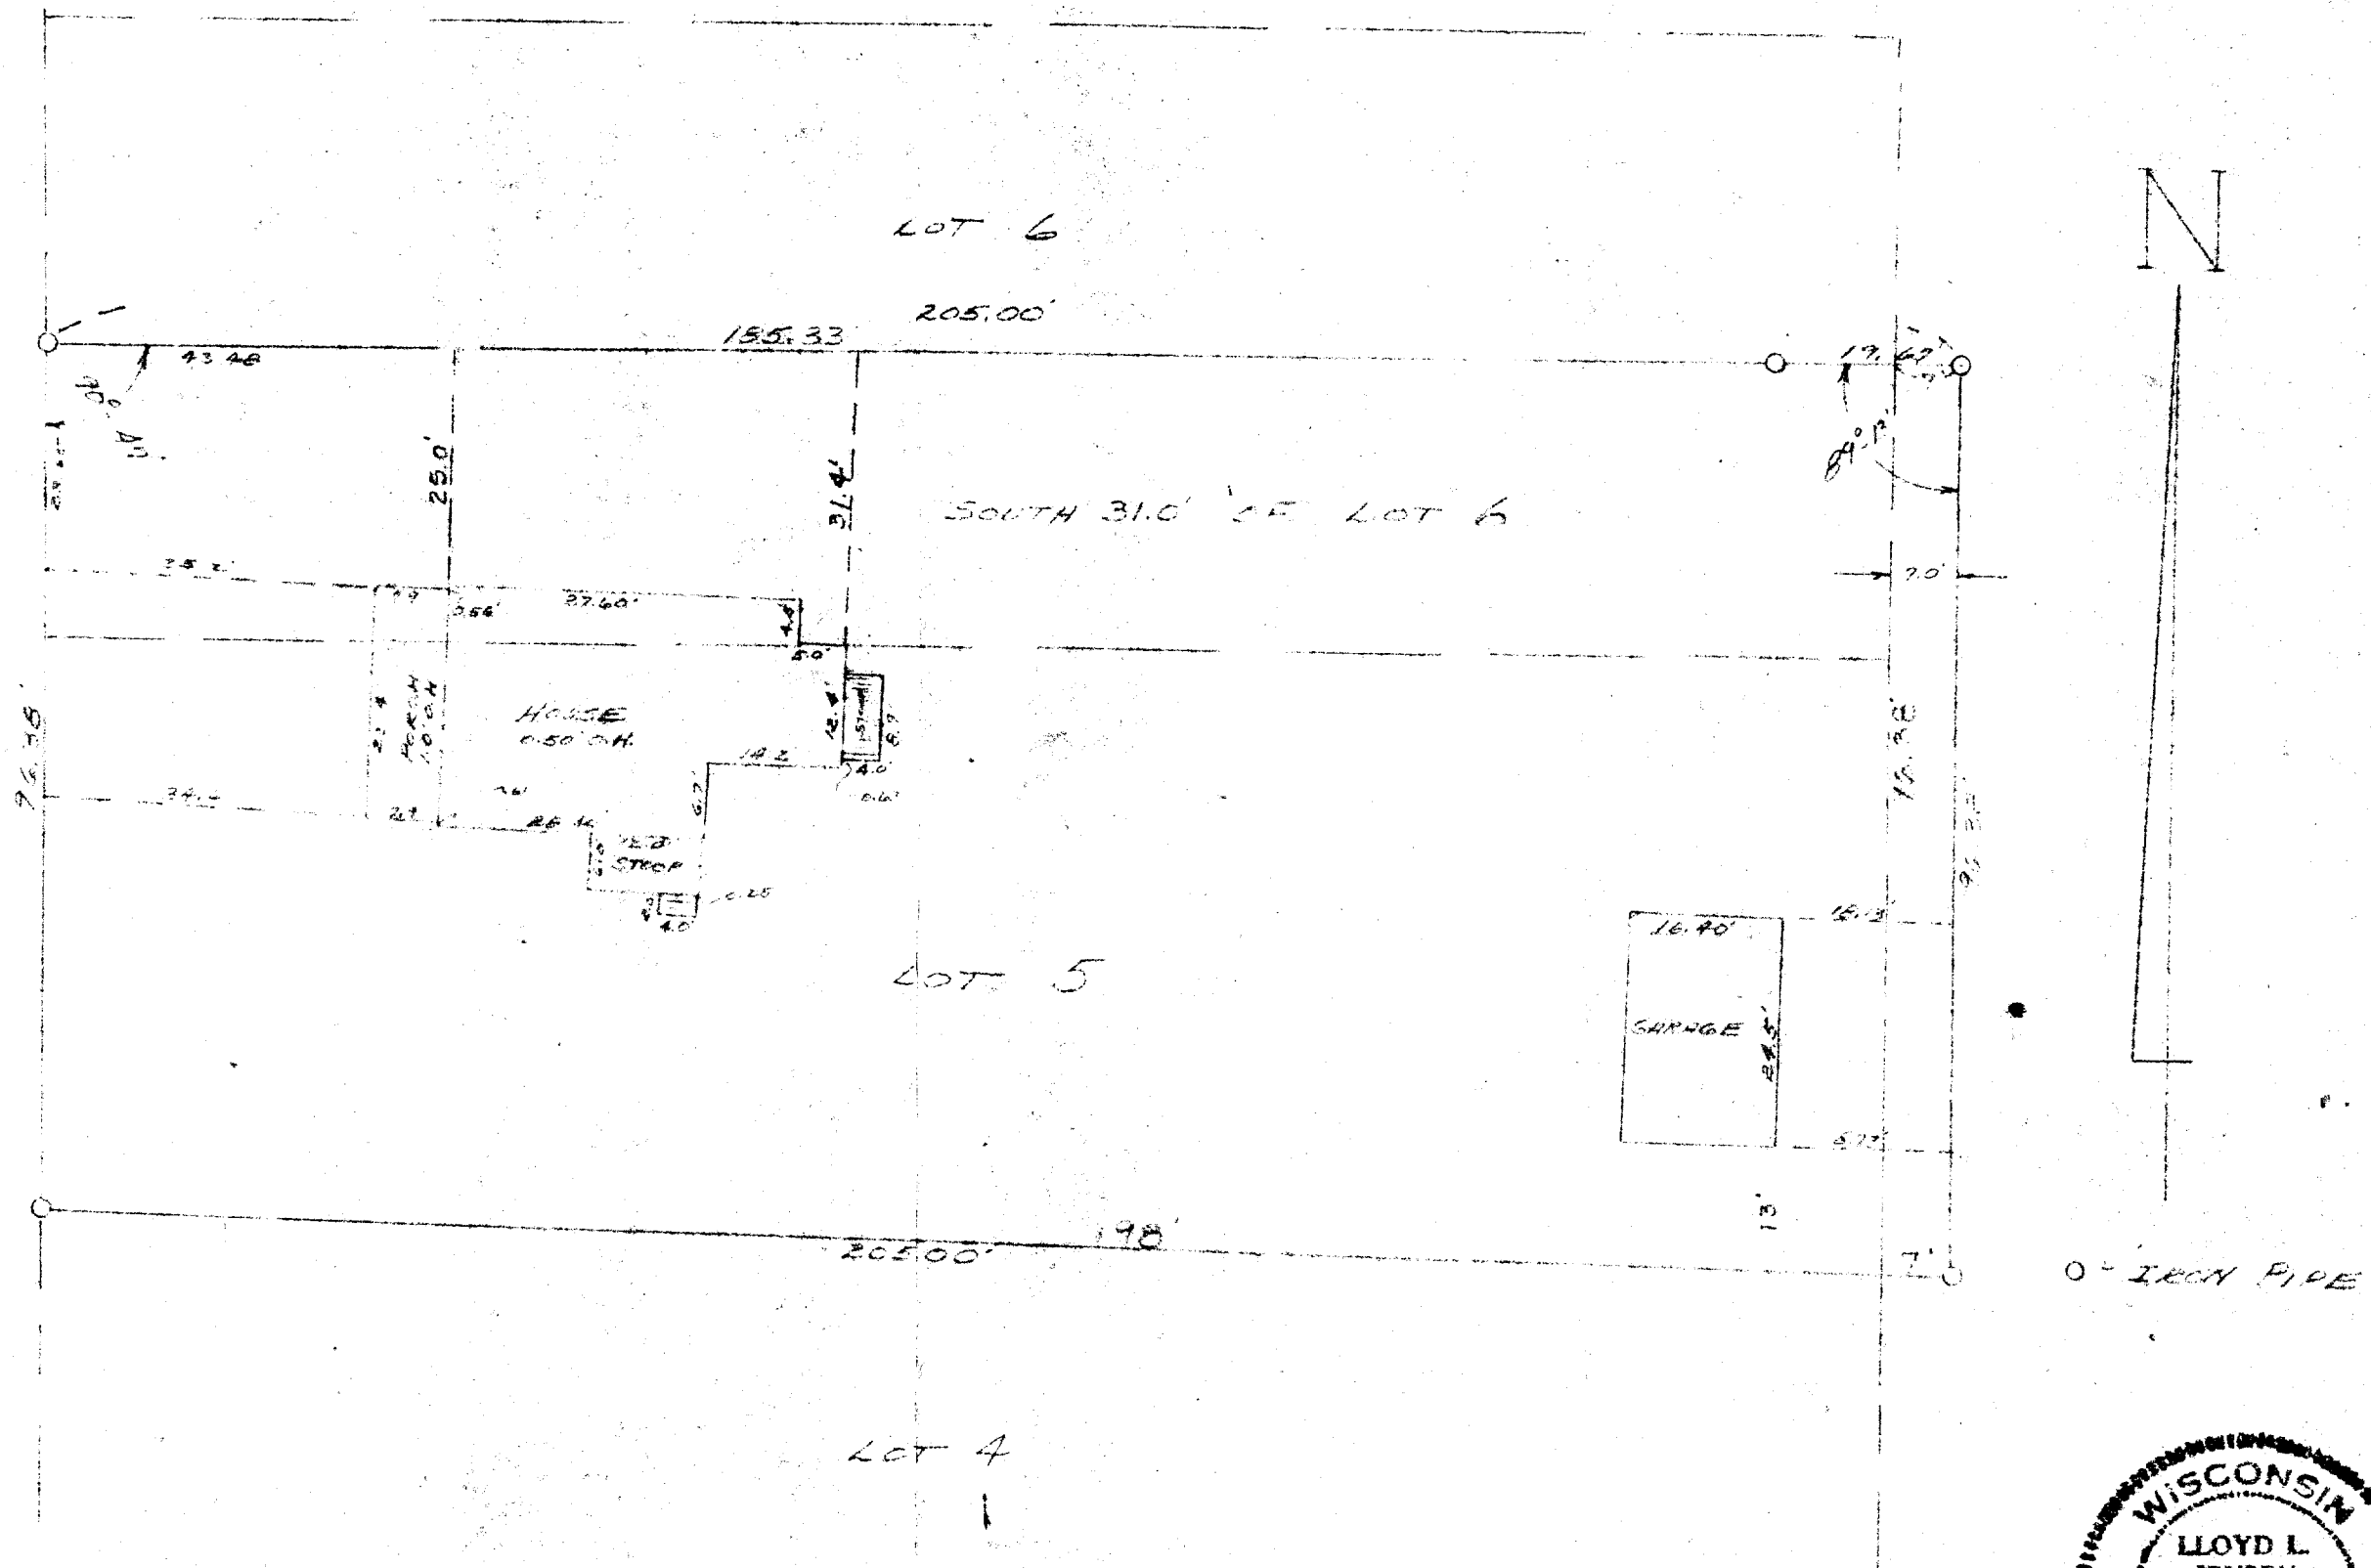

DESCRIPTION OF LAND SURVEYED

Lot 5 and the South 31.00 feet of Lot 6 of Block I of Edwards Addition to the Village of East Troy. Also begin at the Southeast corner of said Lot 5; thence East 7.0 feet; thence North 96.38 feet; thence West 7.00 feet to the East line of said Lot 6, 96.38 feet to the place of beginning.

I certify that I have surveyed the above described property and that the above plat is an accurate survey and a true representation thereof and correctly shows the exterior boundary lines and location of any buildings and other improvements of said property and the correct measurements thereof.

Dated this 20th day of September, 1965.

Lloyd L. Jensen
Lloyd L. Jensen, Surveyor

3-35 J

**PLAT OF SURVEY
OF**

LAND IN THE VILLAGE
OF EAST TROY WISCONSIN.

Lloyd L. Jensen
Surveyor

SCALE 1" = 20'

DATE SEPT 1965

RE-A-5 RXUR-129A