


PLAT OF SURVEY

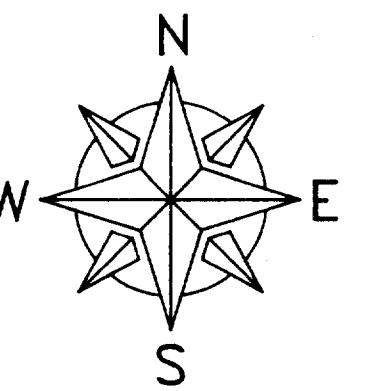


BASIS OF BEARINGS IS THE EAST LINE OF
LYNNDALE SUBDIVISION, WHICH IS RECORDED TO BEAR
N.00°54'00"E.

100' 50' 0 100'
A horizontal scale bar with tick marks at 100', 50', 0, and 100' from left to right. The '0' is centered under the horizontal line. The '100'' marks are at the far left and far right, and the '50'' mark is in the middle. The scale bar is a thick black line with small tick marks extending from the main line at each labeled point.

SCALE IN FEET

LEGEND

- WALWORTH COUNTY CONC. MONUMENT FOUND
- D.O.T. STEEL & CONC. MONUMENT FOUND
- 1 1/2" IRON PIPE FOUND
- 3/4" x 24" SOLID IRON ROD SET
WEIGHING 1.50 LBS./L.F.

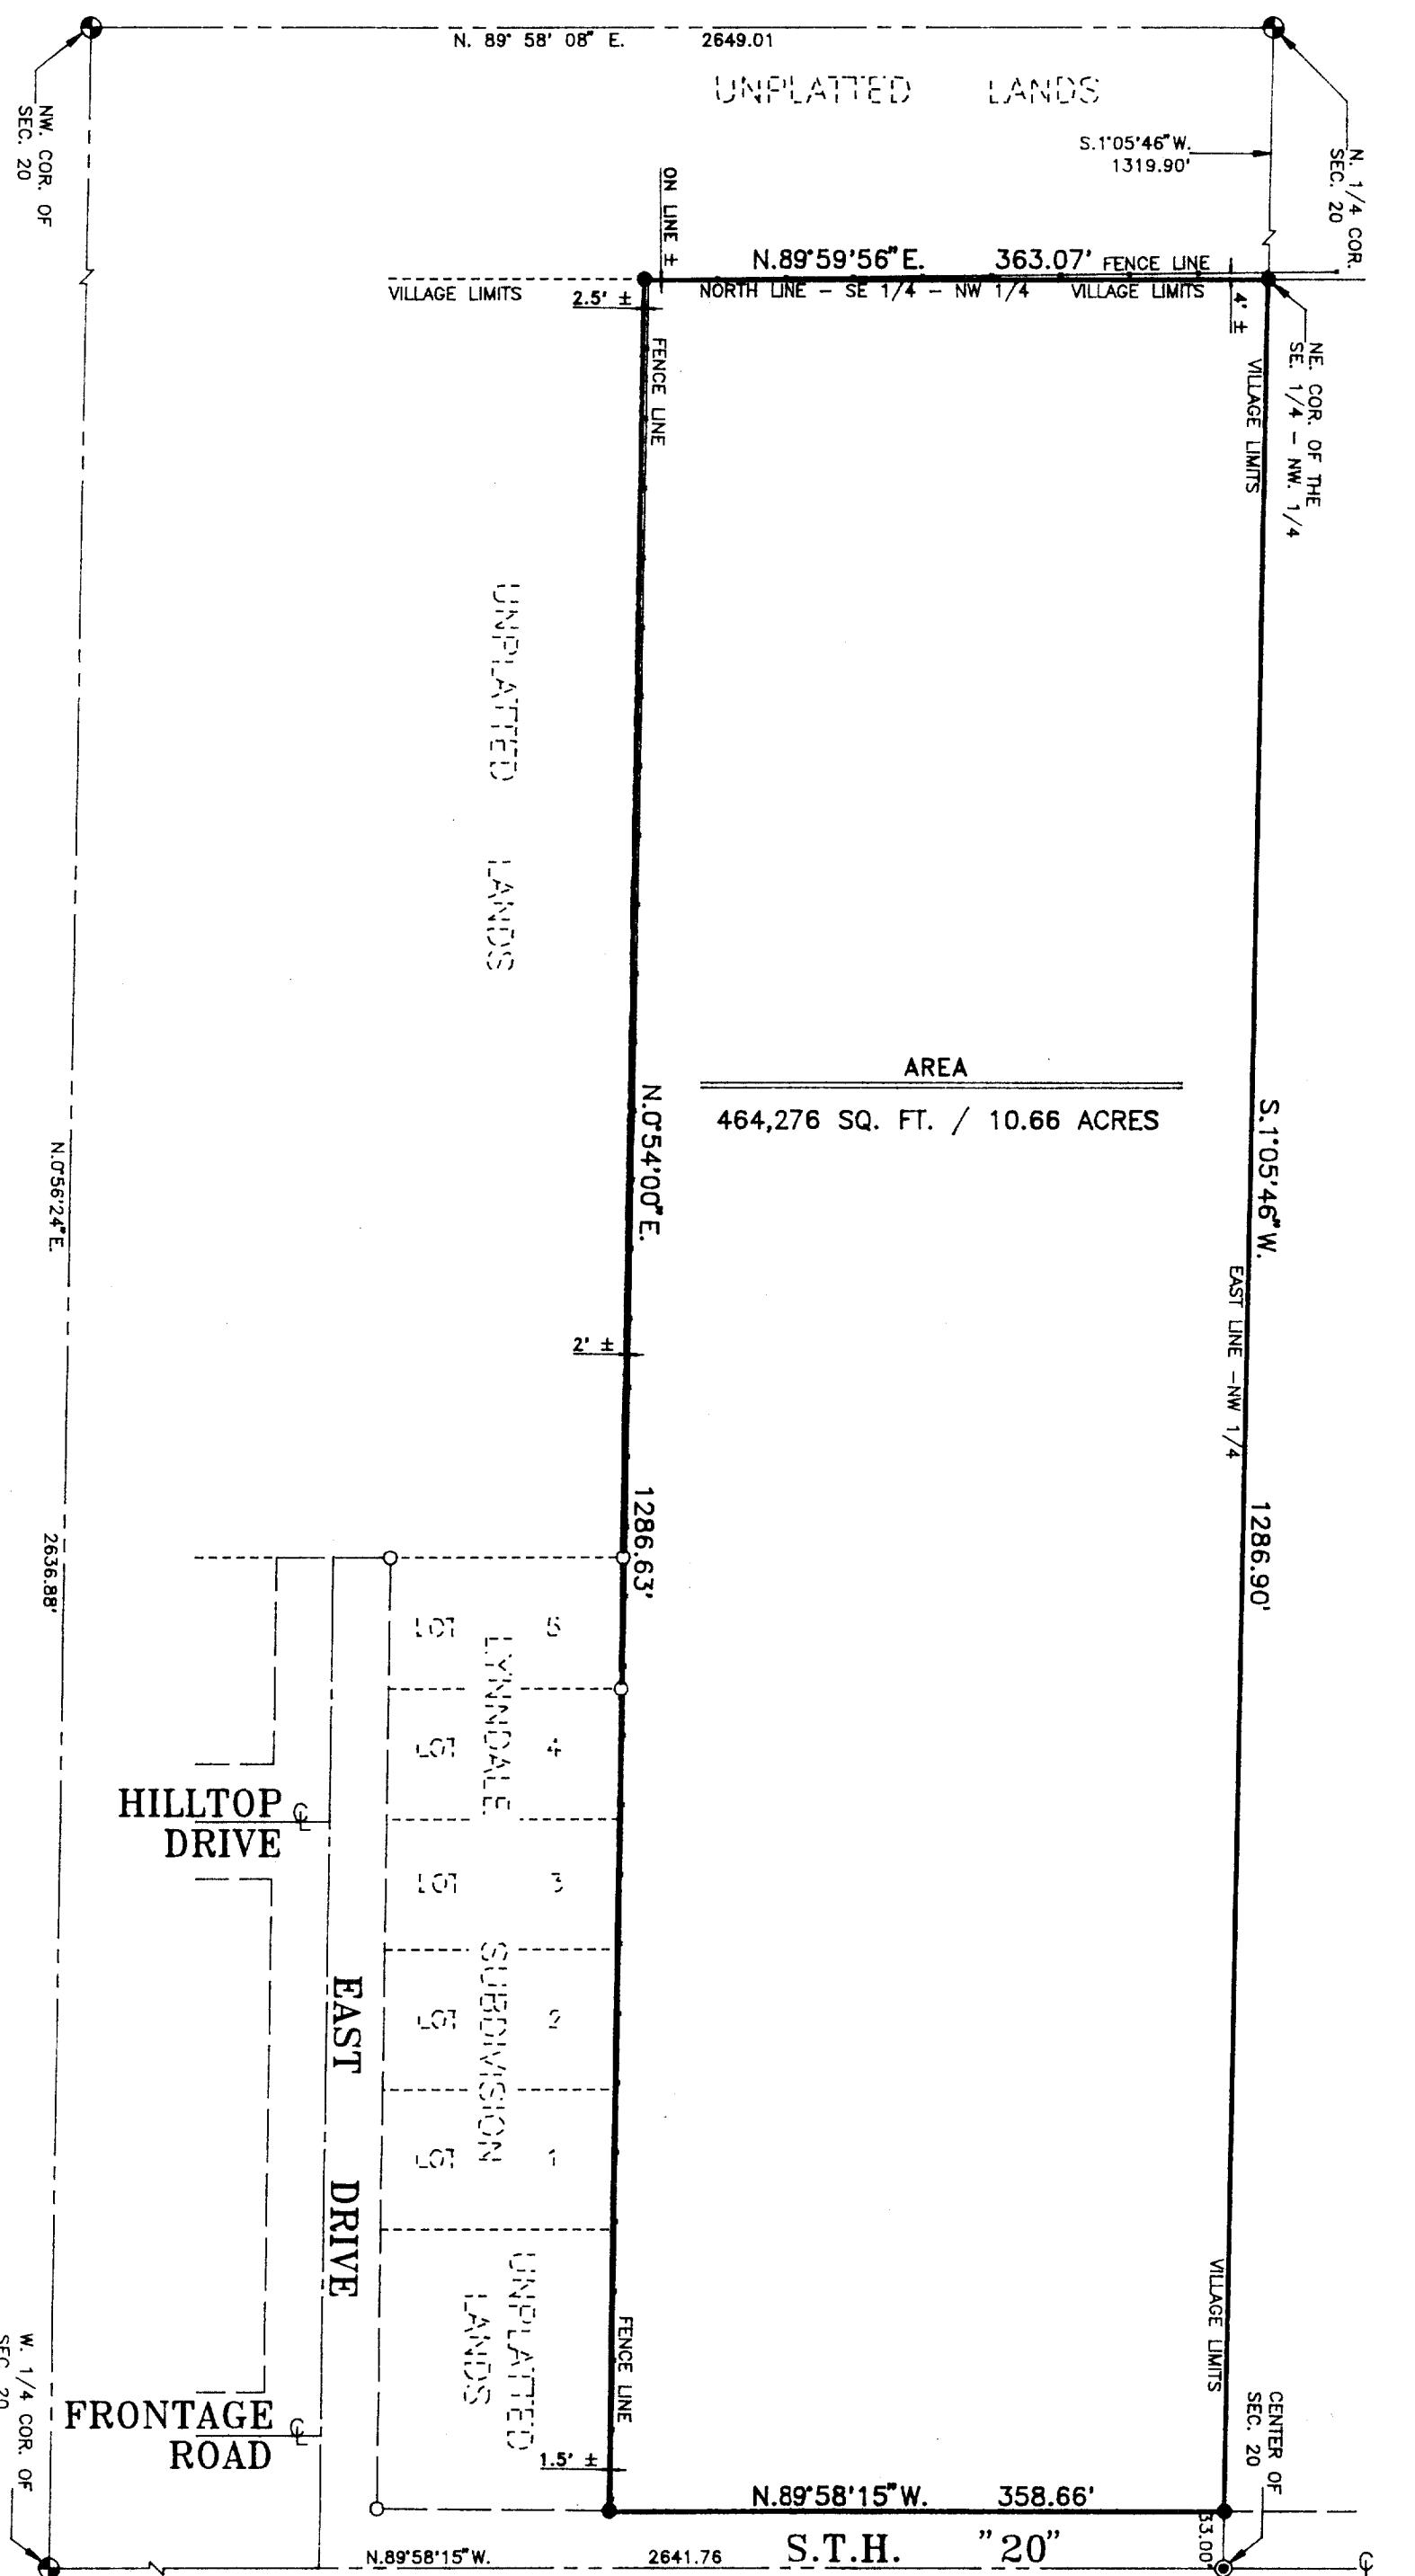

SURVEYOR'S CERTIFICATE



I, Robert W. Condon, Registered Land Surveyor, do hereby certify that by the order of East Troy Bible Church, I have surveyed, monumented, and mapped a part of the SE 1/4 of the NW 1/4 of Section 20, T. 4 N., R. 18 E., Village of East Troy, Walworth County, Wisconsin, described as follows:

Commencing at the North 1/4 corner of said Section 20; thence S.1°05'46"W., along the East line of said NW 1/4, 1319.90 feet to the Northeast corner of said SE 1/4 of the NW 1/4 and the point of beginning; thence continuing S.1°05'46"W., along said East line 1286.90 feet to the Northerly right-of-way line of S.T.H. "20", said point being N.1°05'46"E., 33.00 feet from the center of said Section 20; thence N.89°58'15"W., along said right-of-way line and being parallel with the South line of said NW 1/4, 358.66 feet; thence N.0°54'00"E., along the East line of Lynndale Subdivision and its Northerly and Southerly extension 1286.63 feet to the North line of aforesaid SE 1/4 of the NW 1/4; thence N.89°59'56"E., along said North line 363.07 feet to the point of beginning.

I do further certify that this is a correct representation of the boundaries of land surveyed and that I have fully complied with Chapter A-E7 of the Administrative Code to the best of my knowledge and belief.

Robert W. Condon
Robert W. Condon, R.L.S. #S-1851

an. 21, 1992
Date

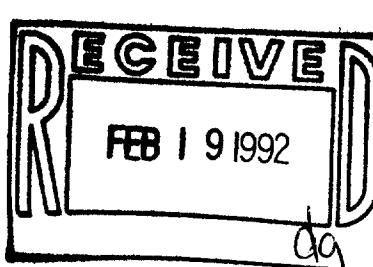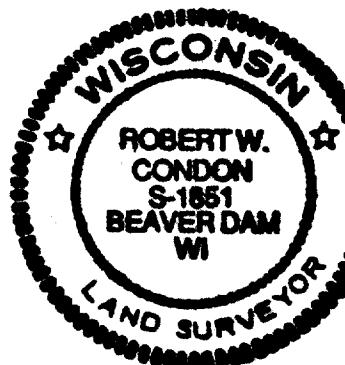

EAST TROY BIBLE CHURCH

PROPERTY SURVEY

DRAWN BY: R.W.C.	DATE	SHEET
APPROVED: R.W.C.	1-15-92	1 OF 1
SCALE:	JOB NO.	
1" = 100'	1-8223	