


PLAT OF SURVEY

LEGAL DESCRIPTION:
Lot 95 of Troyjens Subdivision Addition
Number One, Located in the Southwest 1/4 of
Section 19, Town 4 North, Range 18 East,
Village of East Troy, County of Walworth,
State of Wisconsin.

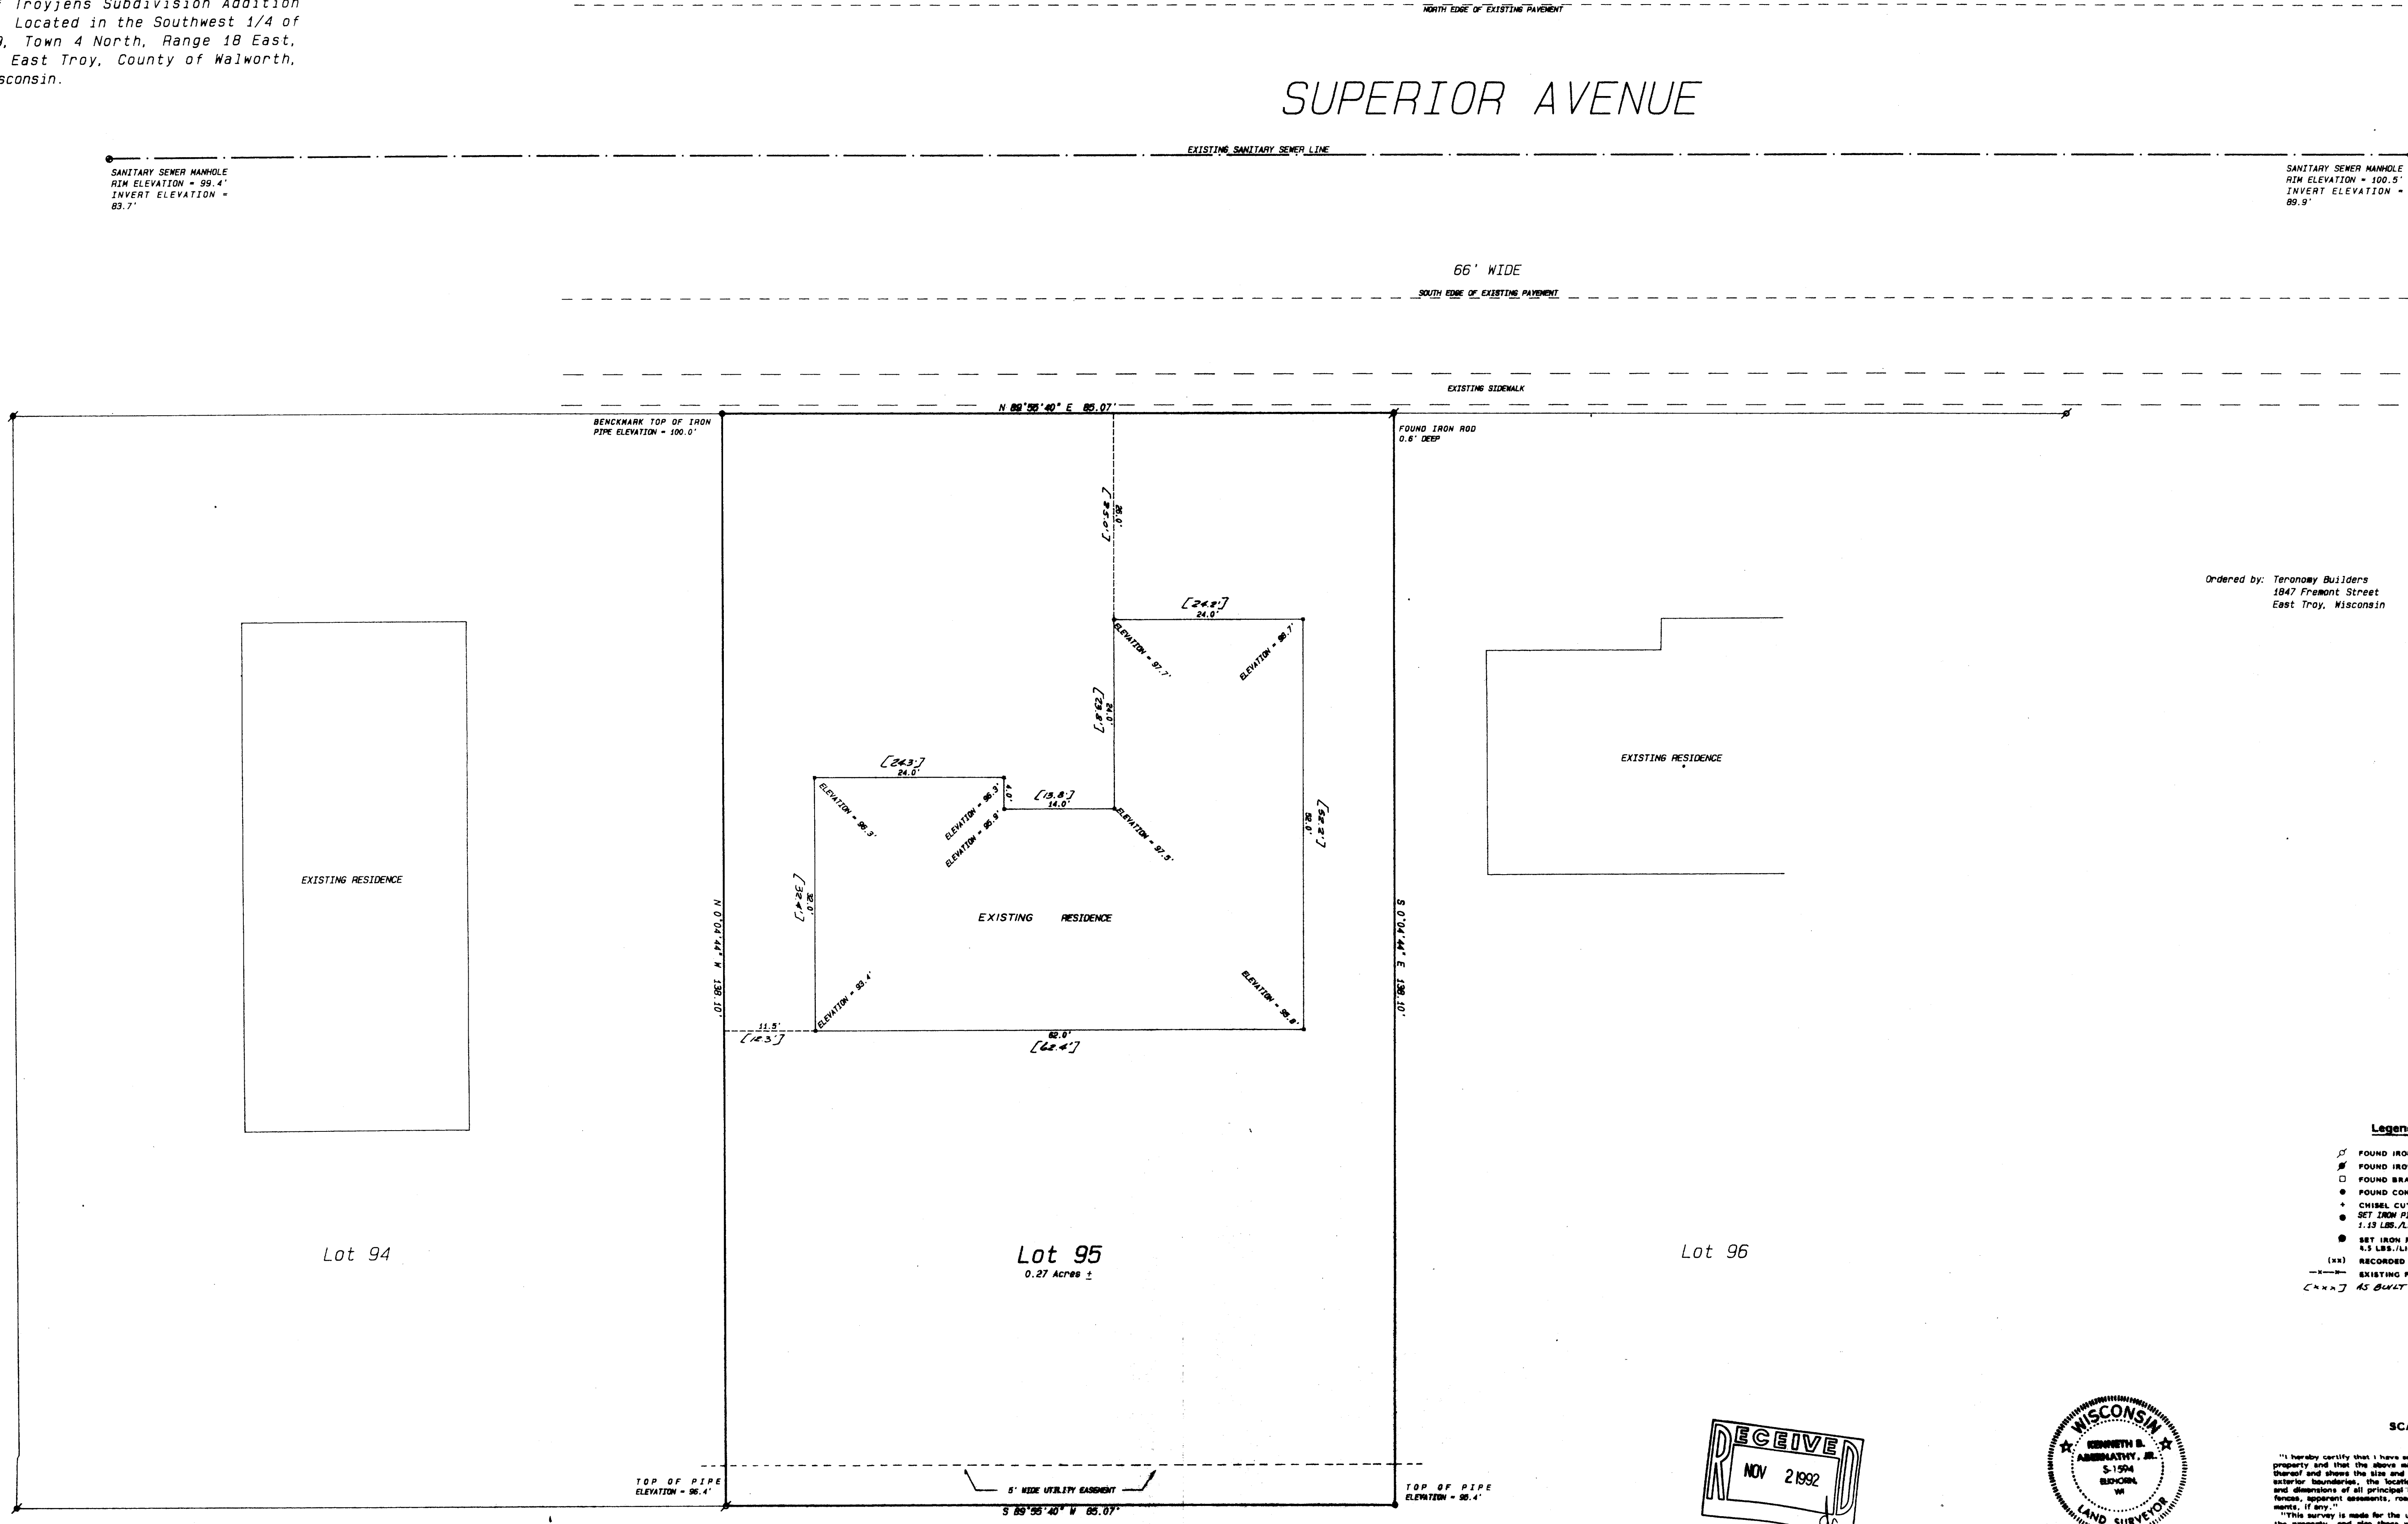

Ordered by: Teronomy Builders
1847 Fremont Street
East Troy, Wisconsin

- Legend
- FOUND IRON PIPE
 - FOUND IRON ROD
 - FOUND BRASS CAPPED MONUMENT
 - FOUND CONCRETE MONUMENT
 - SET IRON PIPE, 24" LONG, WEIGHING 1.19 LBS./LINEAL FT., 1" DIA.
 - SET IRON ROD, 36" LONG, WEIGHING 4.5 LBS./LINEAL FT., 1-11/16" DIA.
 - RECORDED AS DIMENSION
 - EXISTING FENCE
 - AS BUILT MEASUREMENT

SCALE: 1"= 40 FEET

"I hereby certify that I have surveyed the above described property and that the above map is a true representation thereof and shows the size and location of the property, its exterior boundaries, the location of all visible structures and dimensions of all principal buildings thereon, boundary lines, apparent easements, roadways and visible encroachments, if any."

"This survey is made for the use of the present owners of the property, and also those who purchase, mortgage, or guarantee the title thereto within one year from date hereof."

Kenneth B. Abernathy, Jr.
KENNETH B. ABERNATHY, JR.
WISCONSIN REGISTERED LAND SURVEYOR,
S-1594

Date: March 14, 1991 Job No. 1991-307
Revised: 9/25/92 AS BUILT LOCATION