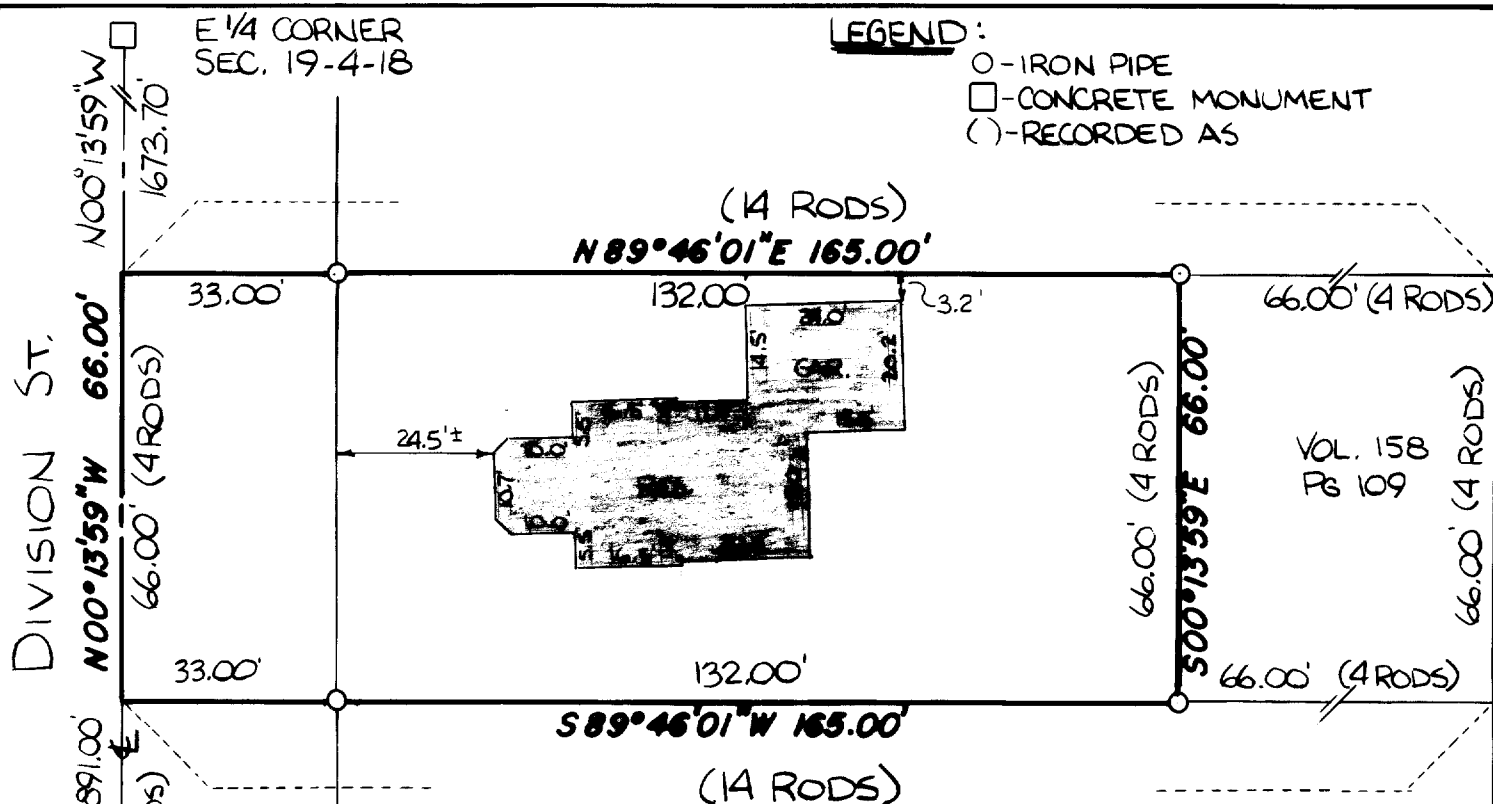


**DESCRIPTION:**

Commencing 54 rods North of the Southeast corner of Sec. 19, in Township 4 North, Range 18 East, and running North 4 rods, thence East 14 rods, thence South 4 rods, and thence West 14 rods to the place of beginning, in the Village of East Troy.

Excepting and reserving therefrom that certain piece or parcel of land deeded to Equity Co-operative Feed and Fuel Company, dated June 8, 1931 and recorded May 20, 1932 in Vol. 158 of Deeds on page 109 in Register of Deeds Office in and for Walworth County, Wisconsin.

CERTIFICATE:

" I have surveyed the above-described property and the above map is a true representation thereof and shows the size and location of the property, its exterior boundaries, the location and dimensions of all structures thereon, fences, apparent easements and roadways and visible encroachments, if any. This survey is made for the exclusive use of the present owners of the property, and also those who purchase, mortgage, or guarantee the title thereto within one year from date hereof; and as to them I warrant the accuracy of said survey and map."

DATE:

December 19, 1975



Joseph M. Bieri

8-12