


MORTGAGE INSPECTION

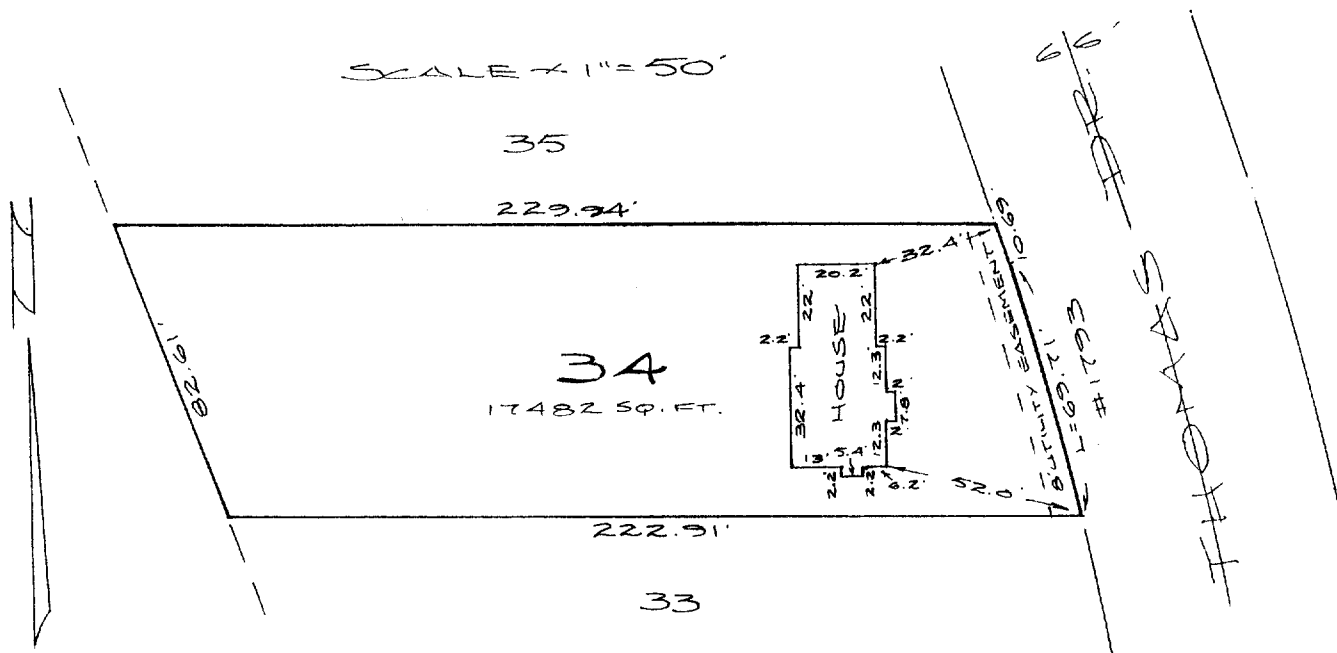

NOTE: In accordance with A-E 7.01 (2) this inspection has been exempted in writing by Don Bucholtz from the requirements of A-E 7.01 Minimum Standards for Property Surveys. Lot dimensions are shown as recorded on the original plat. These dimensions were not necessarily verified in the field and no lot stakes were set in the course of this inspection. The Legal Description is shown as previously recorded or as provided by the person ordering this inspection. This inspection does not constitute a complete property survey and cannot be relied on as such. Buildings shown hereon represent the outside building walls and do not reflect any roof overhang unless otherwise shown. The above description is subject to any and all easements or agreements, recorded or unrecorded.

DESCRIPTION

Lot 34, SECOND ADDITION TO GLENN VIEW ESTATES in the NW $\frac{1}{4}$ of Section 20, T4N, R18E, Village of East Troy, Walworth County, Wisconsin.


CERTIFICATION

I certify that the property described above has been inspected under my responsible direction and supervision and that the above map is an accurate representation of the size and location of the property and the location and dimensions of all visible structural improvements, if any.

This inspection is made for the exclusive use of the present owners and also those who purchase, mortgage or guarantee the title thereto and is certified for one year from date hereto.

Date 10-21-92

Prepared for: Don Bucholtz
1793 Thomas Drive
East Troy, WI 53120

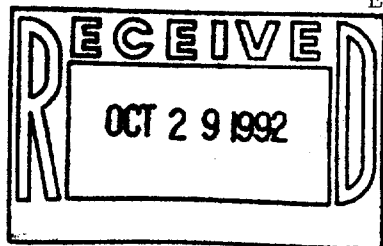

James B. Woodman
Registered Land Surveyor S-1239

