


PLAT OF SURVEY
-OF-

LOT 5, MARION SUBDIVISION, located in the Northwest 1/4 of the Northwest 1/4 of Section 29, Township 4 North, Range 18 East in Walworth County, Wisconsin.



Proposed house was staked on actual corners with 5 foot control on the longest house line. The Contractor will be responsible to field verify all stakes for location and dimension prior to construction. If any discrepancies should arise, notify this office at once.

Survey For: Denise Pohlman

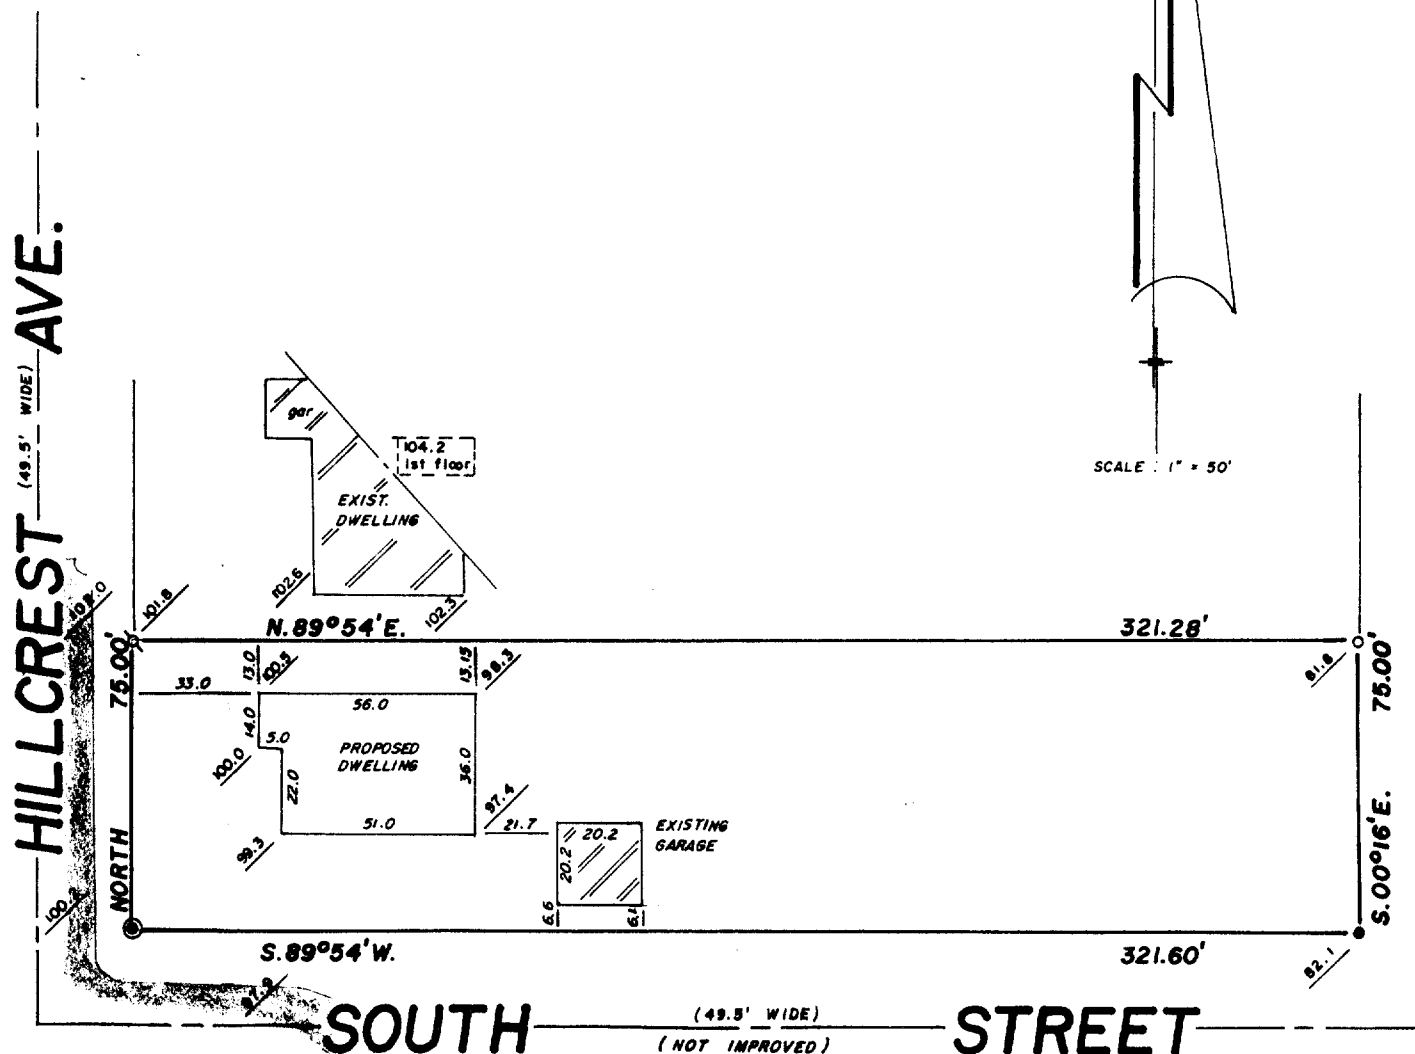


LEGEND

- FOUND IRON PIPE
- FOUND CONC MONUMENT
- FOUND 2" IRON PIPE
- ✕ SET IRON PIPE

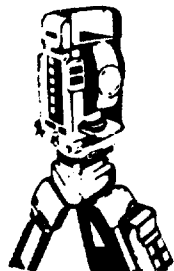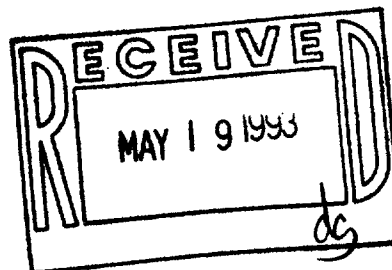

B.W. SURVEYING

Land Surveys
Mapping And Planning
35117 Academy Road
Burlington, Wisconsin 53105
(414) 534-4109

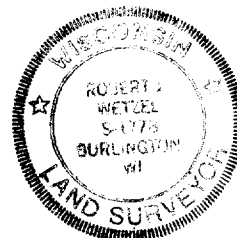

THIS IS NOT AN ORIGINAL PRINT
UNLESS THIS SEAL IS RED

Robert J. Wetzel
ROBERT J. WETZEL
REGISTERED LAND SURVEYOR - 1778

MARCH 11, 1993
DATE

1181
JOB NUMBER

003-382

RMS-4

PLAT OF SURVEY
-OF-


LOT 5, MARION SUBDIVISION, located in the Northwest 1/4 of the Northwest 1/4 of Section 29, Township 4 North, Range 18 East in Walworth County, Wisconsin.

Proposed house was staked on actual corners with 5 foot control on the longest house line. The Contractor will be responsible to field verify all stakes for location and dimension prior to construction. If any discrepancies should arise, notify this office at once.

Survey For: Denise Pohlman



I hereby certify that the existing foundation shown on this plat of survey is located as shown thus (), dated this 20th day of May, 1993.

Robert J. Wetzel
Robert J. Wetzel S-1778

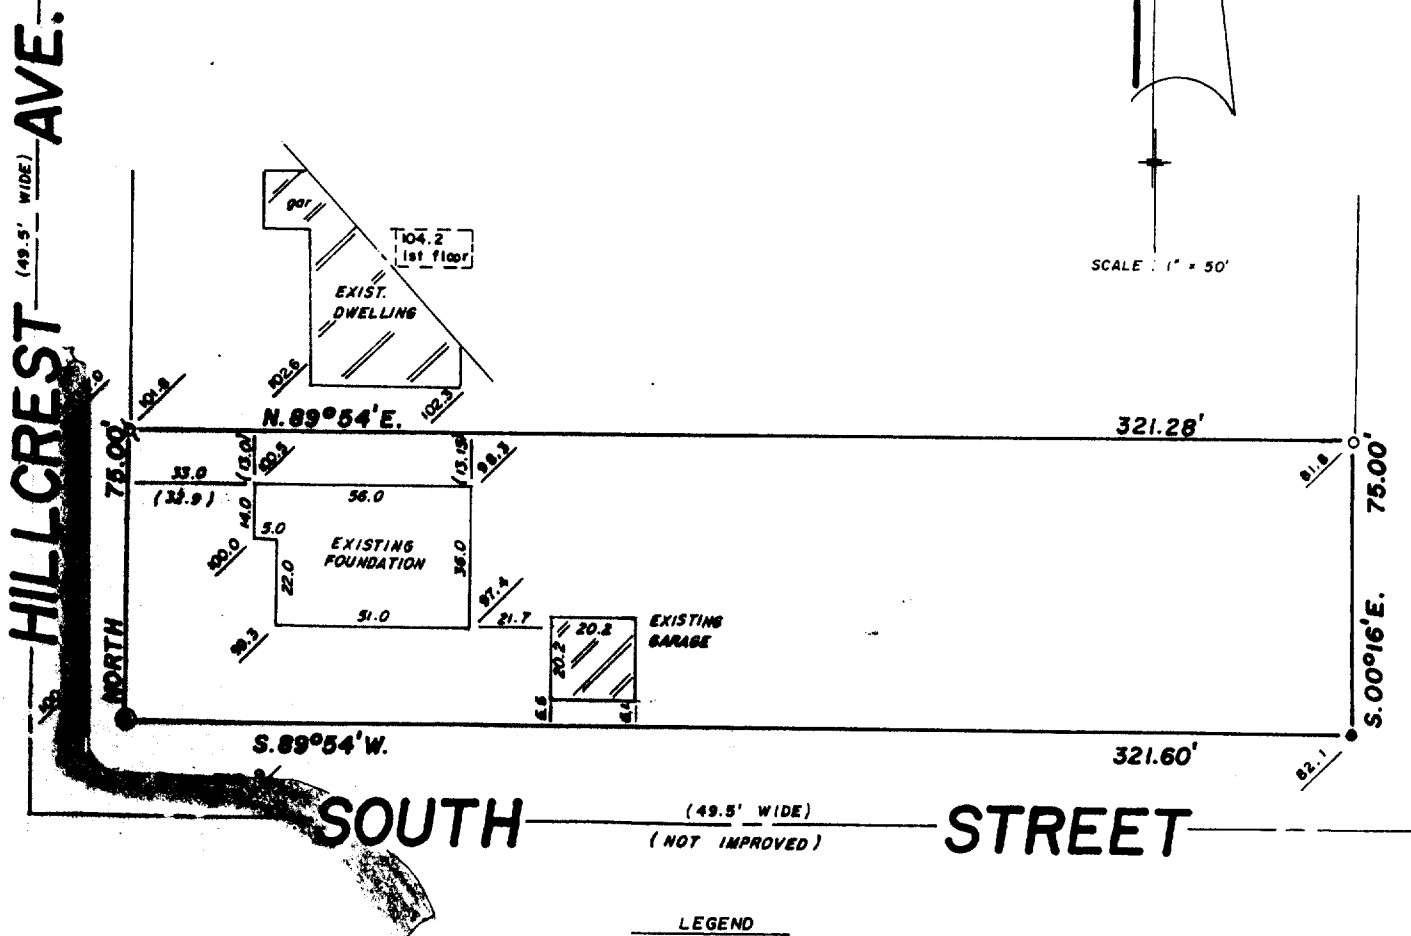

B.W. SURVEYING

Land Surveys
Mapping And Planning
35117 Academy Road
Burlington, Wisconsin 53105
(414) 534-4109

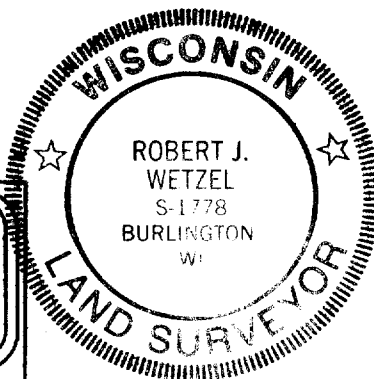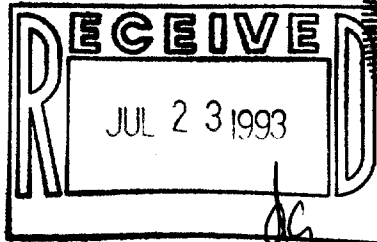

"I hereby certify that I have surveyed the above described property and that the above map is a true representation thereof and shows the size and location of the property, its exterior boundaries, the location of all visible structures and dimensions of all principal buildings thereon, boundary fences, apparent easements, roadways and encroachments, if any."

"This survey is made for the use of the present owners of the property, and those who purchase, mortgage, or guarantee the title thereto within one year from date hereof."

THIS IS NOT AN ORIGINAL PRINT
UNLESS THIS SEAL IS RED

Robert J. Wetzel
ROBERT J. WETZEL
REGISTERED LAND SURVEYOR - 1778

MARCH 11, 1993
DATE

1181
JOB NUMBER

RMS-4

003-382