

W. 238 S. 3712 BIG BEND ROAD
WAUKESHA, WIS. 53186


TELEPHONE
542-5616

RONALD H. ZIMMERMAN
REGISTERED LAND SURVEYOR

PLAT OF SURVEY

FOR

WAUKESHA SAVINGS & LOAN

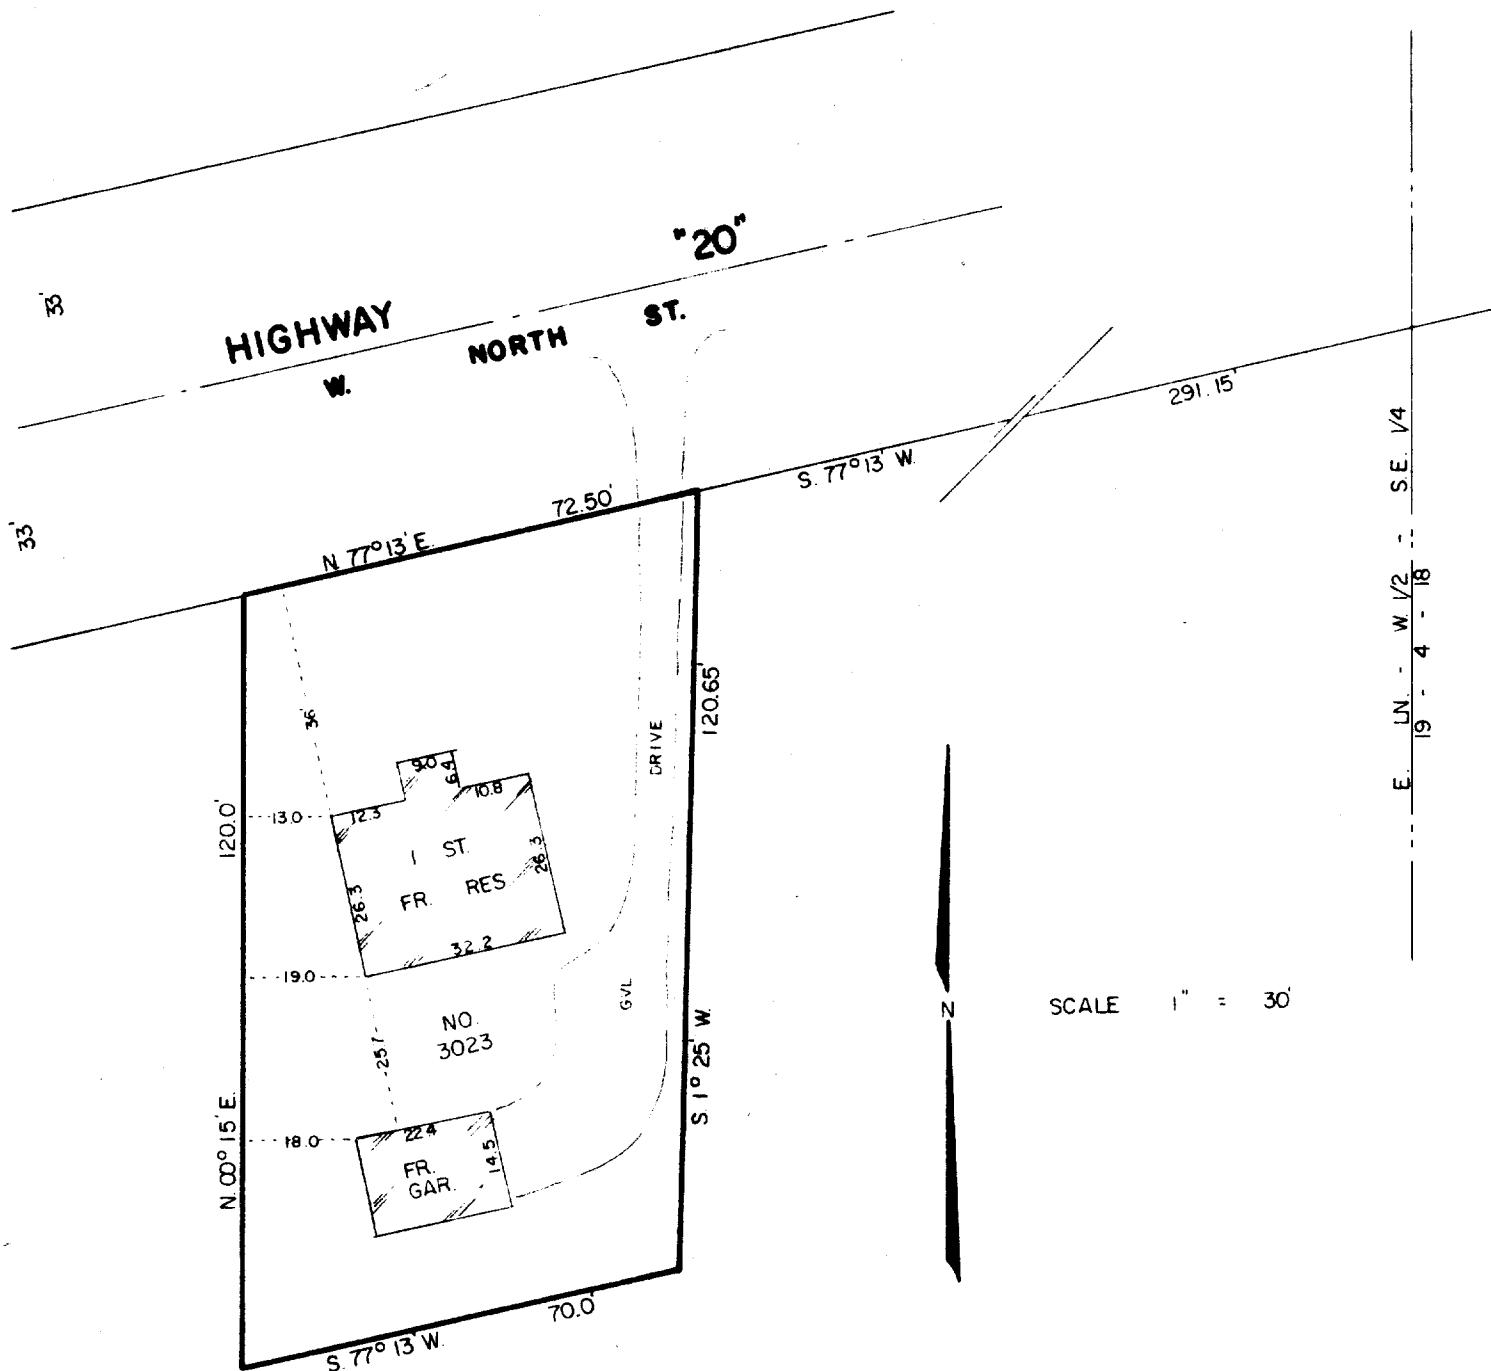

DESCRIPTION (Continued)

A parcel of land located in the West 1/2 of the Section 30, Township 1 North, Range 12 East of Walworth County, Wisconsin, containing 1.00 acre, more or less, as follows, to-wit: Beginning at the intersection of the center line of said Highway W. North St. and the East line of said Highway W. North St.; thence South 77° 13' West along the North line of said Highway W. North St. 291.15 feet to the place of beginning; thence South 1° 15' West 120.65 feet; thence South 77° 13' West 70.0 feet; thence North 1° 15' East 120.65 feet to the South line of said Highway W. North St.; thence North 77° 13' East along said Highway W. North St. 291.15 feet to the place of beginning.

STATE OF WISCONSIN)
COUNTY OF WAUKESHA) SS


CERTIFICATION

I, RONALD H. ZIMMERMAN, REGISTERED LAND SURVEYOR, DO HEREBY CERTIFY THAT I HAVE MADE A SURVEY OF THE PROPERTY DESCRIBED ABOVE AND THE EXISTING BUILDING AND IMPROVEMENTS LOCATED THEREON AND THAT THE PLAT HERewith DRAWN IS A CORRECT REPRESENTATION OF SAID SURVEY.

DATE NOV. 30, 1973

RONALD H. ZIMMERMAN

S - 868

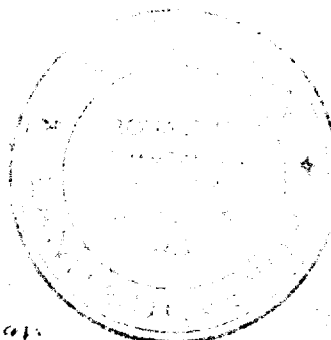

UP-31

3-3Z