


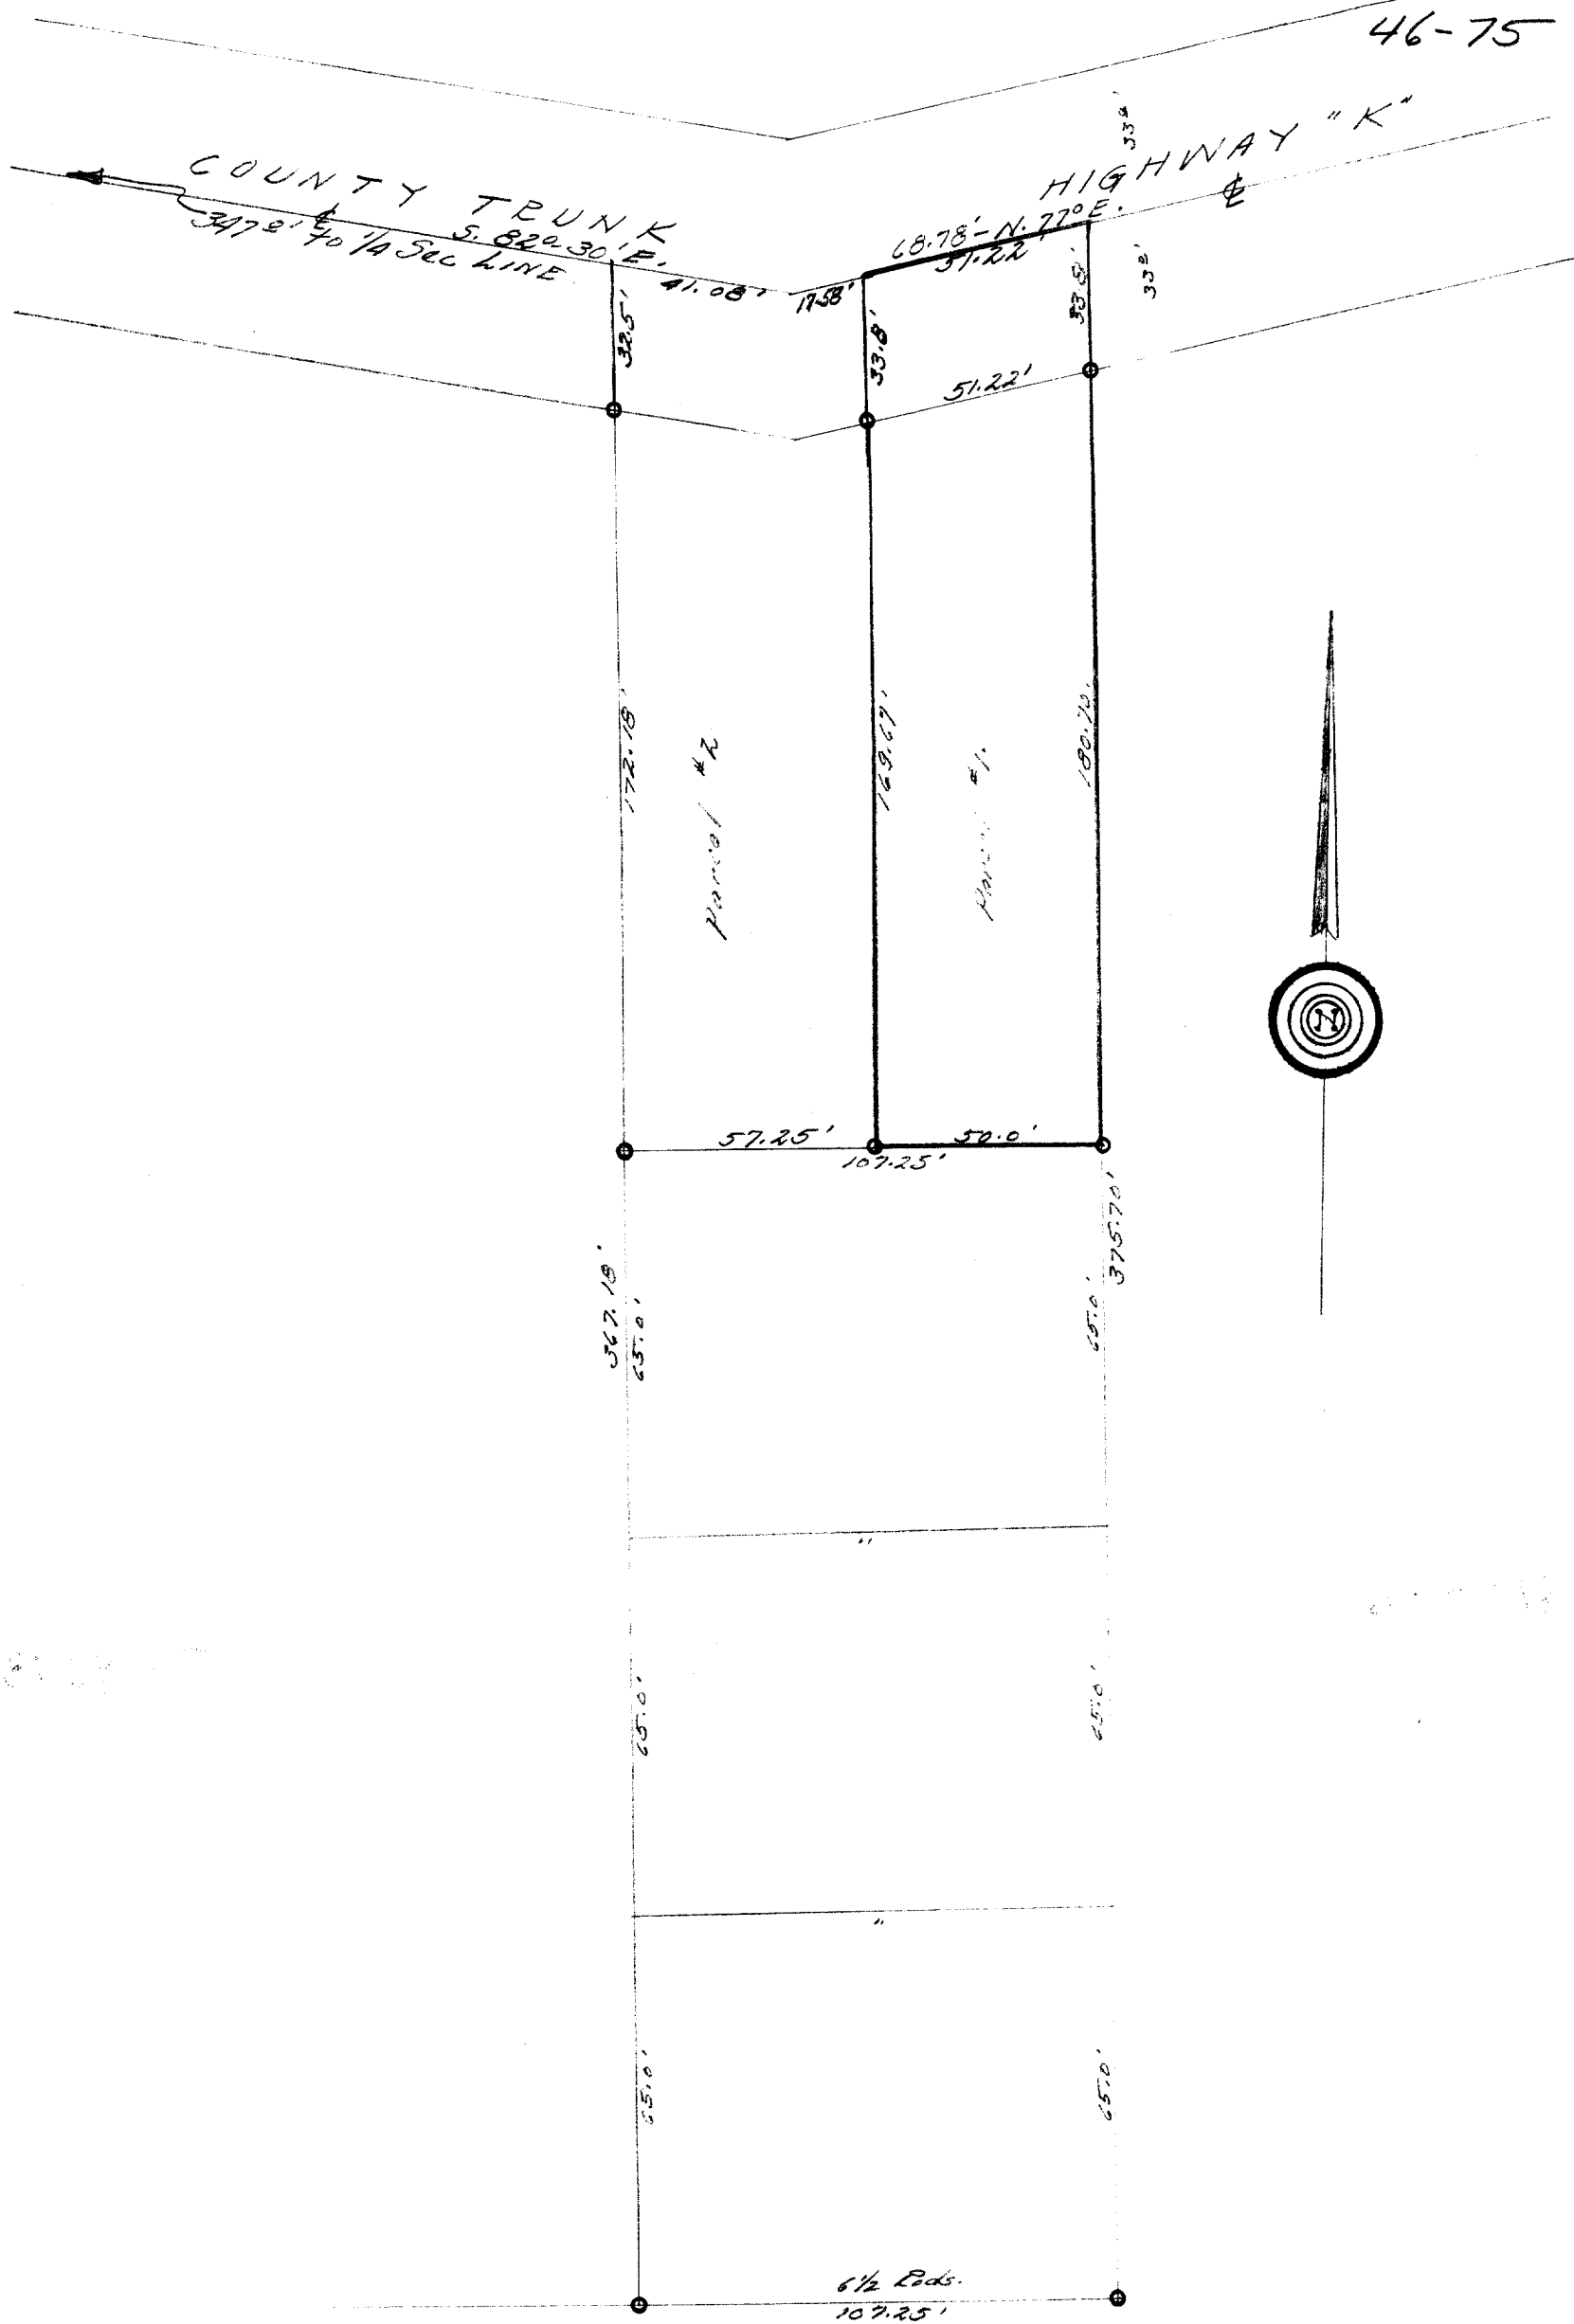

DESCRIPTION:

Parcel #1. Commencing at a point in the centerline of County Trunk Highway "K", that is 388.08 feet S. 82° 30' E., of the 1/4 section line of Section 19, Town 4 north, Range 18 east of the 4th Principal Meridian, thence N. 77° E., along the centerline of said highway 17.58 feet, to the place of beginning of this description; thence South 203.47 feet to an iron stake, thence East 50.0 feet to an iron stake, thence North 214.50 feet to a point in the centerline of said highway, thence S. 77° E., along the centerline of said highway 51.22 feet to the place of beginning.

Parcel #2. Commencing at a point in the centerline of County Trunk Highway "K", that is 347.2 feet S. 82° 30' E., of the 1/4 section line of Section 19, Town 4 north, Range 18 east of the 4th Principal Meridian, thence S. 82° 30' E., along the centerline of said highway, 41.08 feet, to a point, thence N. 77° E., along the centerline of said highway, 17.58 feet to a point, thence South 203.47 feet to an iron stake, thence West 57.25 feet to an iron stake, thence North 204.38 feet to the place of beginning.

CERTIFICATE:

I, hereby certify that I have on this the 3th day of September 1946, surveyed the above described property according to the official records on file in the office of the Recorder of Deeds in and for Walworth County, Wisconsin, and that the above is a true and correct representation of the survey as completed on this day.

SIGNED AND SEALED THIS 12TH DAY OF SEPTEMBER 1946.

Joseph M. Biagi
Joseph M. Biagi
Professional Engineer
Elkhorn Wisconsin.