

ABERNATHY and ASSOCIATES

Kenneth B. Abernathy Jr.

Wisconsin Registered Land Surveyor S-1594



Rt. 3, Box 273
Elkhorn, Wisconsin 53121
Phone: (414) 723-4260 (office)
(414) 723-4813 (residence)

PLAT OF SURVEY

LOT 56 OF THE FOURTH ADDITION TO GLENN VIEW
ESTATES SUBDIVISION LOCATED IN THE NORTHWEST
1/4 OF SECTION 20, TOWN 4 NORTH, RANGE 18
EAST, VILLAGE OF EAST TROY, WALWORTH COUNTY,
WISCONSIN.

ORDERED BY: NEUMANN HOMES
4450 MILTON AVE.
SUITE 206
JANESVILLE, WI. 53121

NOTE:
SUBJECT TO ANY EASEMENTS RECORDED OR UNRECORDED.

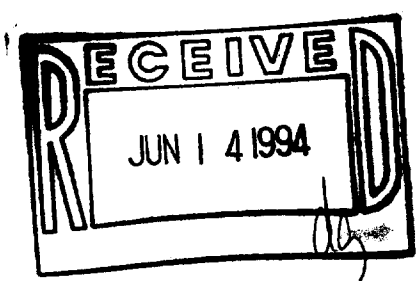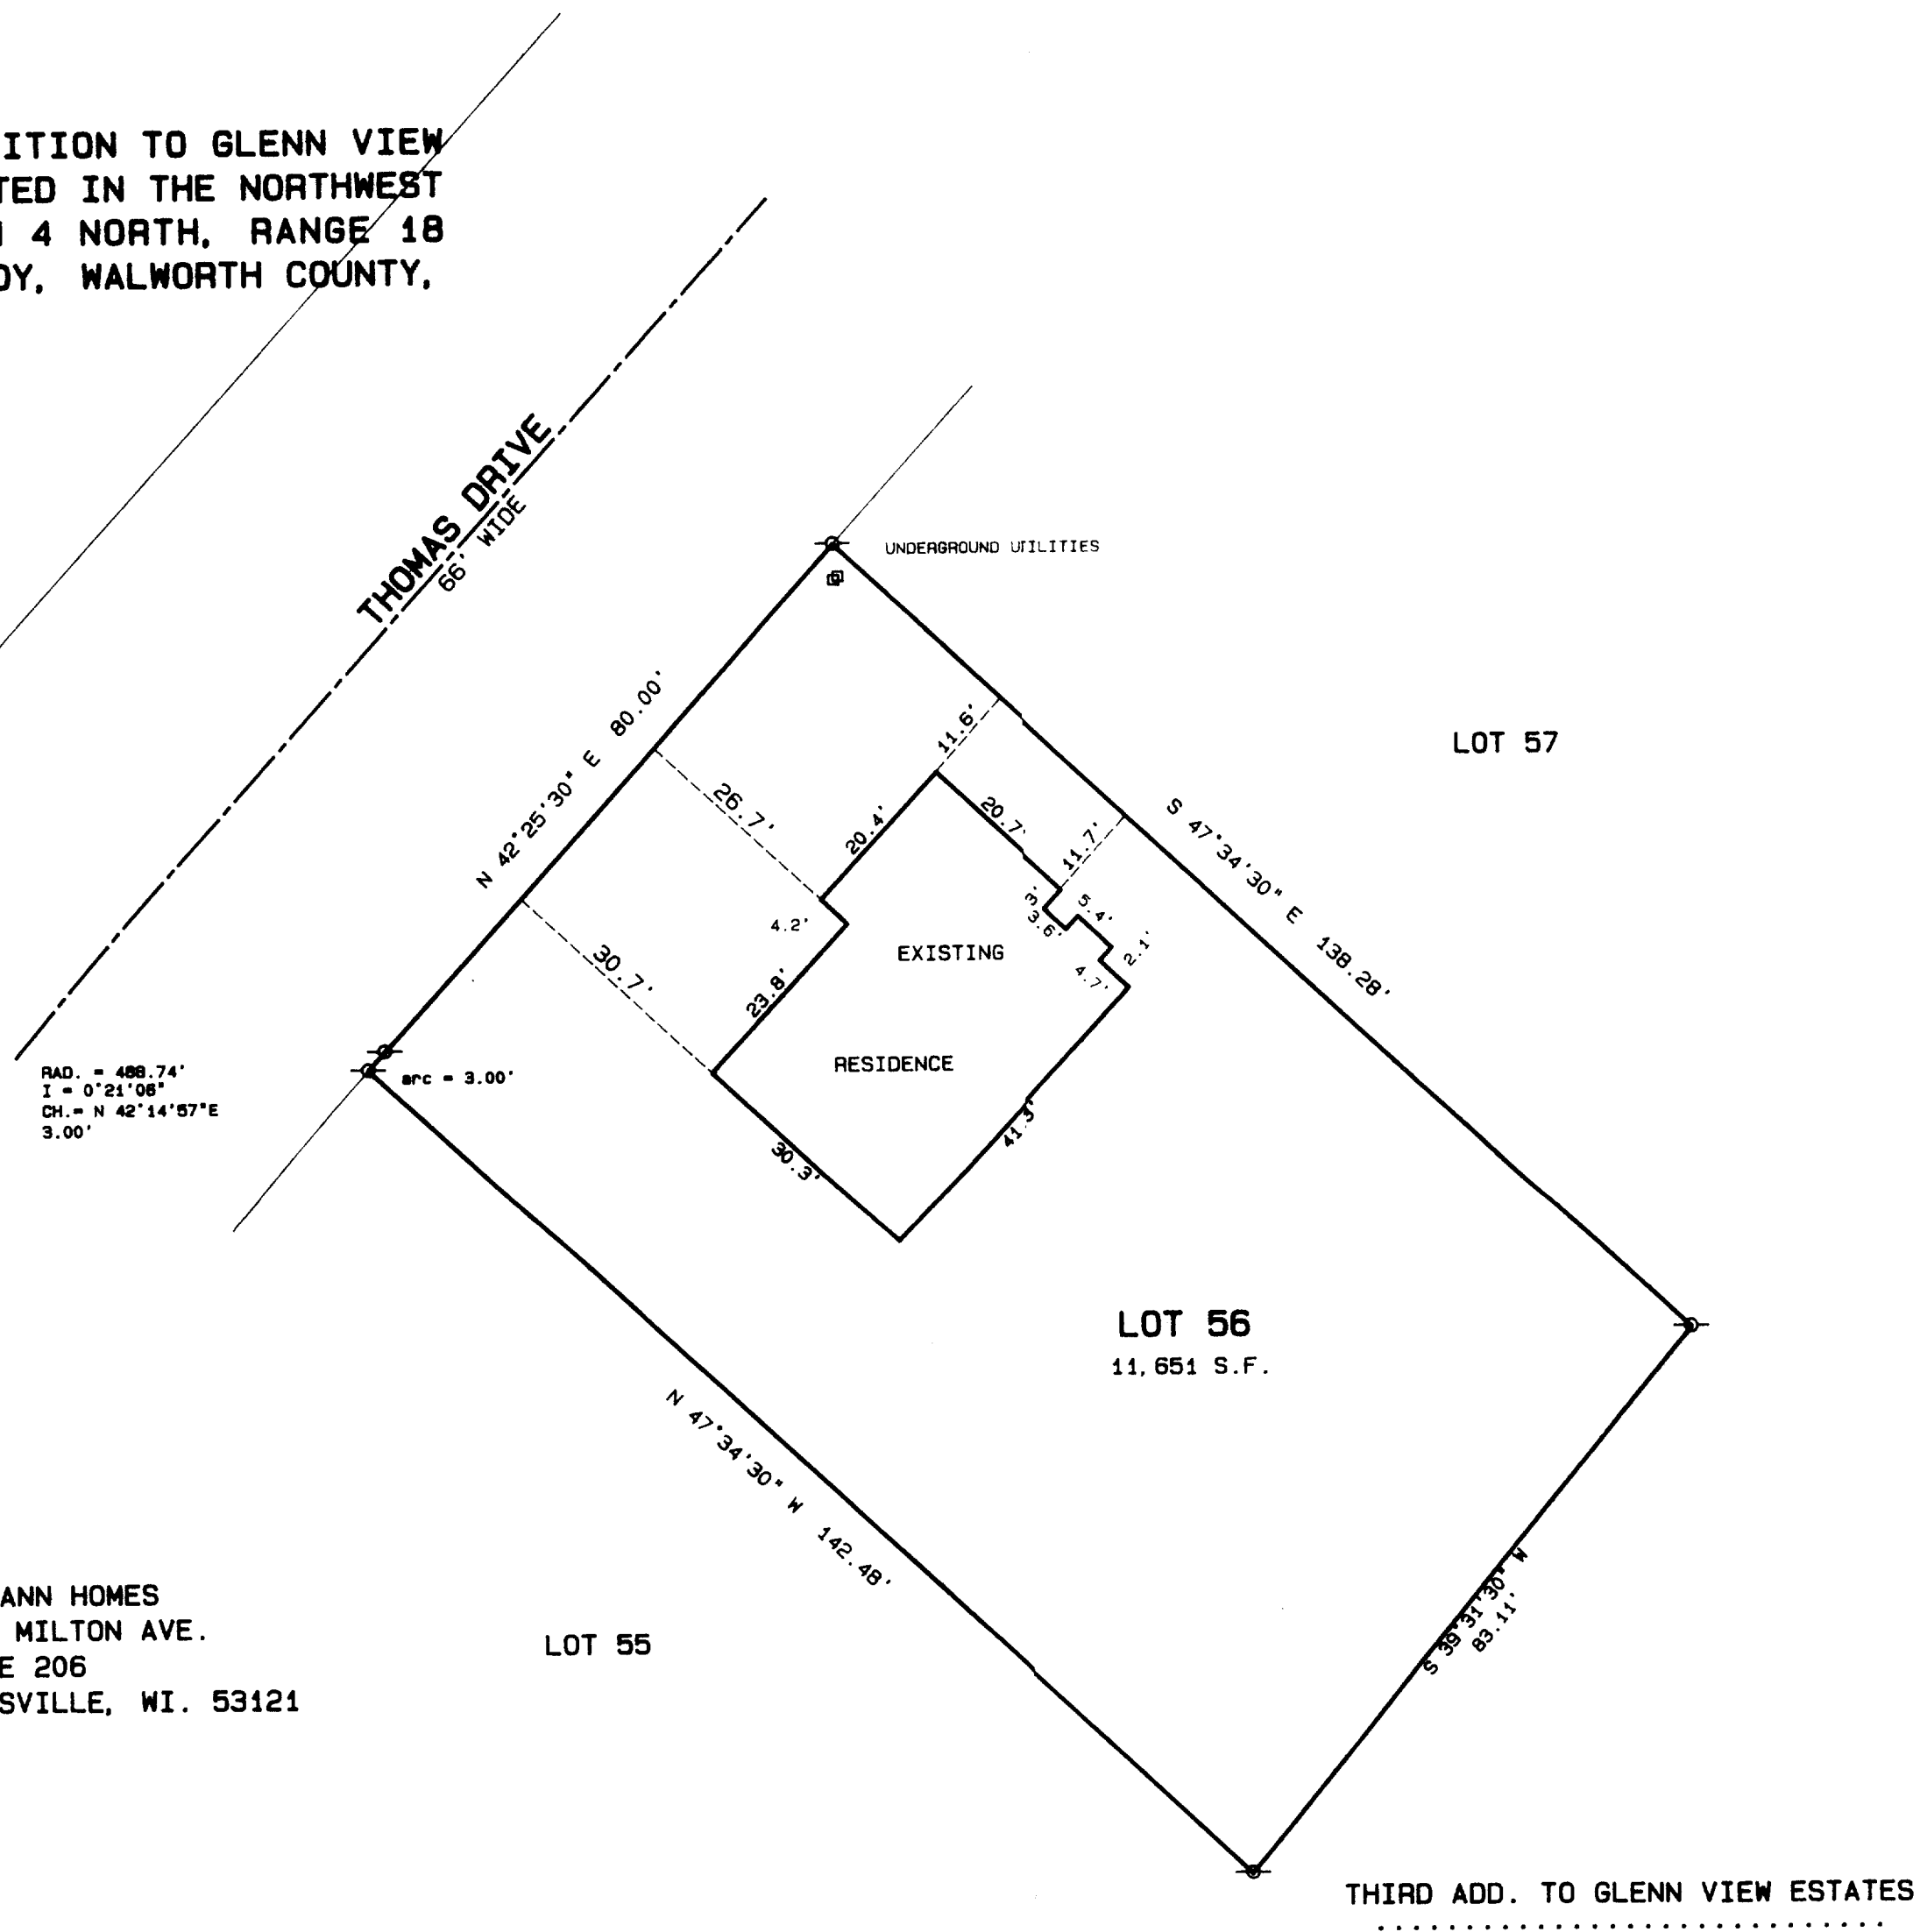

Kenneth B. Abernathy, Jr.
KENNETH B. ABERNATHY, JR.
WISCONSIN REGISTERED LAND SURVEYOR,
S-1594

Date: APRIL 26, 1994 Job No. 94-425