



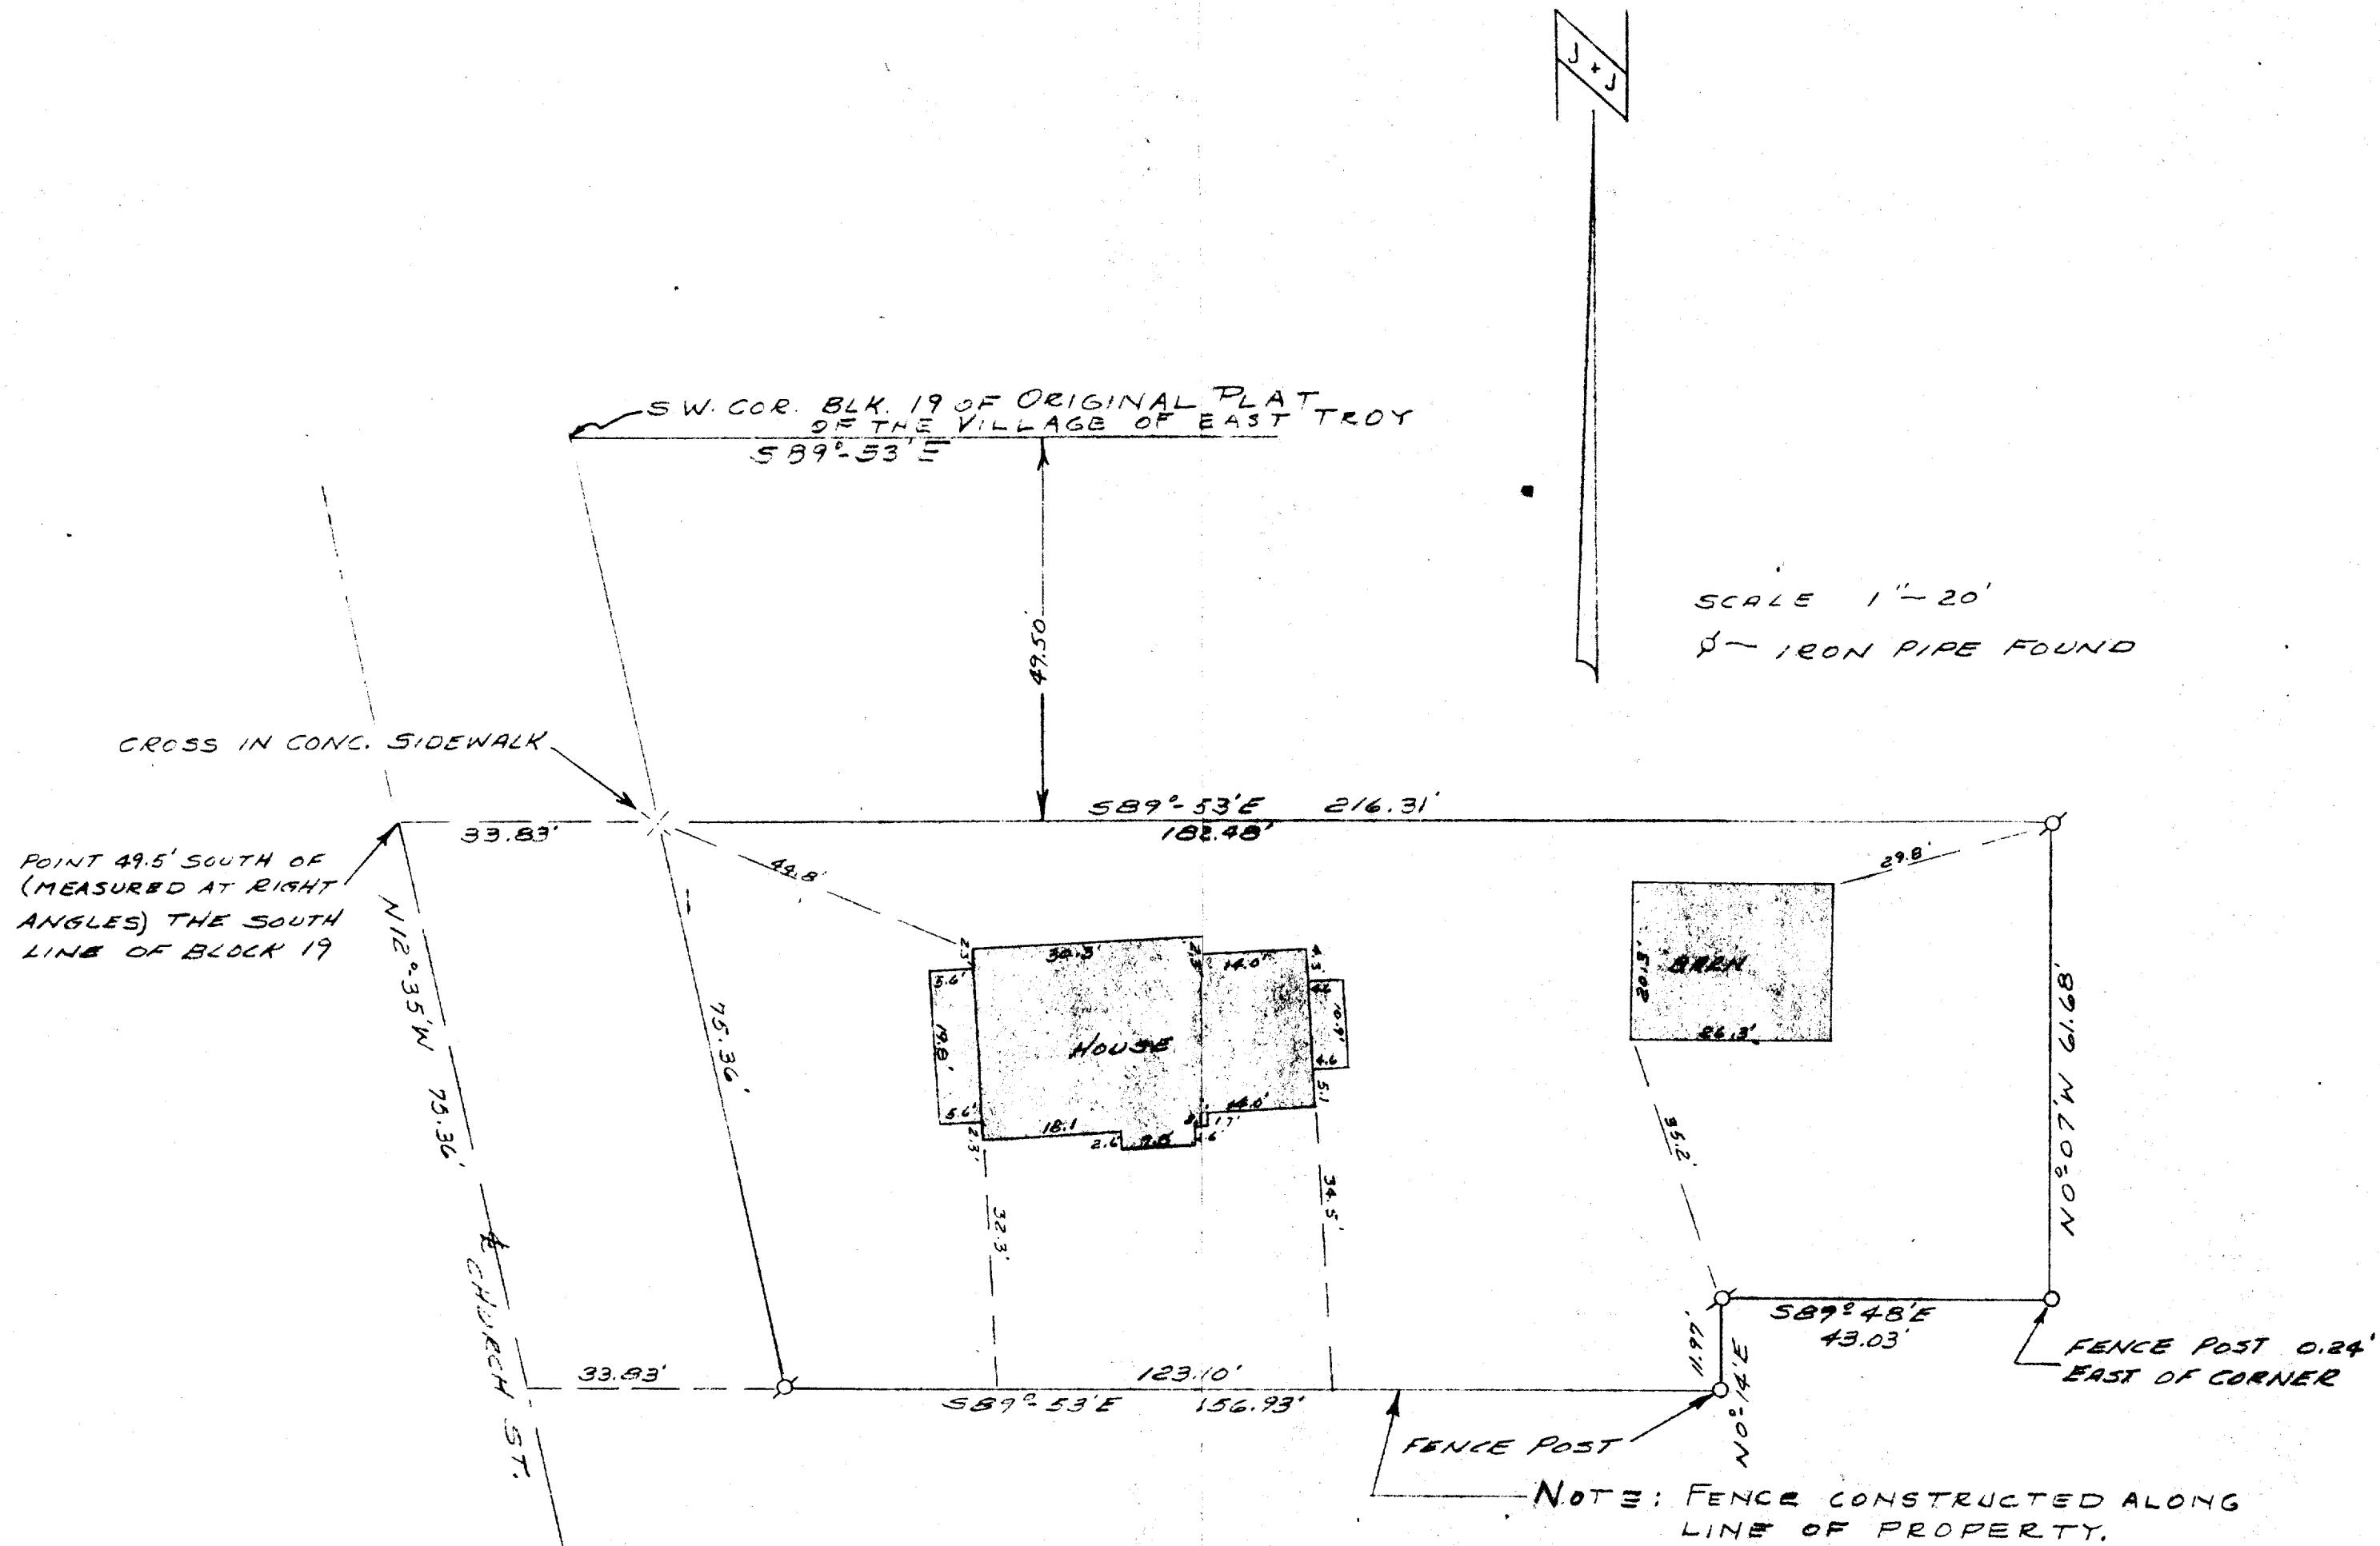

PLAT OF SURVEY
OF A PARCEL OF LAND LOCATED
IN THE NW $\frac{1}{4}$ OF SECTION 29,
T4N R1BE WAL. CO. WIS.

UP-167

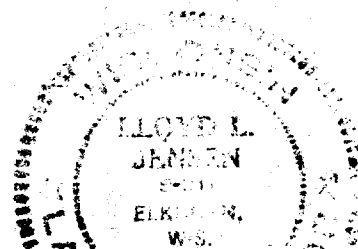

OCT. 8, 1968

Lloyd L. Jensen
LLOYD L. JENSEN
Co. SURVEYOR

3-41J