


ABERNATHY and ASSOCIATES
Kenneth B. Abernathy Jr.
Wisconsin Registered Land Surveyor S-1594


Rt. 3, Box 273
Elkhorn, Wisconsin 53121
Phone: (414) 723-4260 (office)
(414) 723-7209 (FAX)

PLAT OF SURVEY

LOT 78 OF THE FOURTH ADDITION TO
GLENN VIEW ESTATES SUBDIVISION,
LOCATED IN SECTION 20, TOWN 4
NORTH, RANGE 18 EAST, VILLAGE OF
EAST TROY, WALWORTH COUNTY,
WISCONSIN.

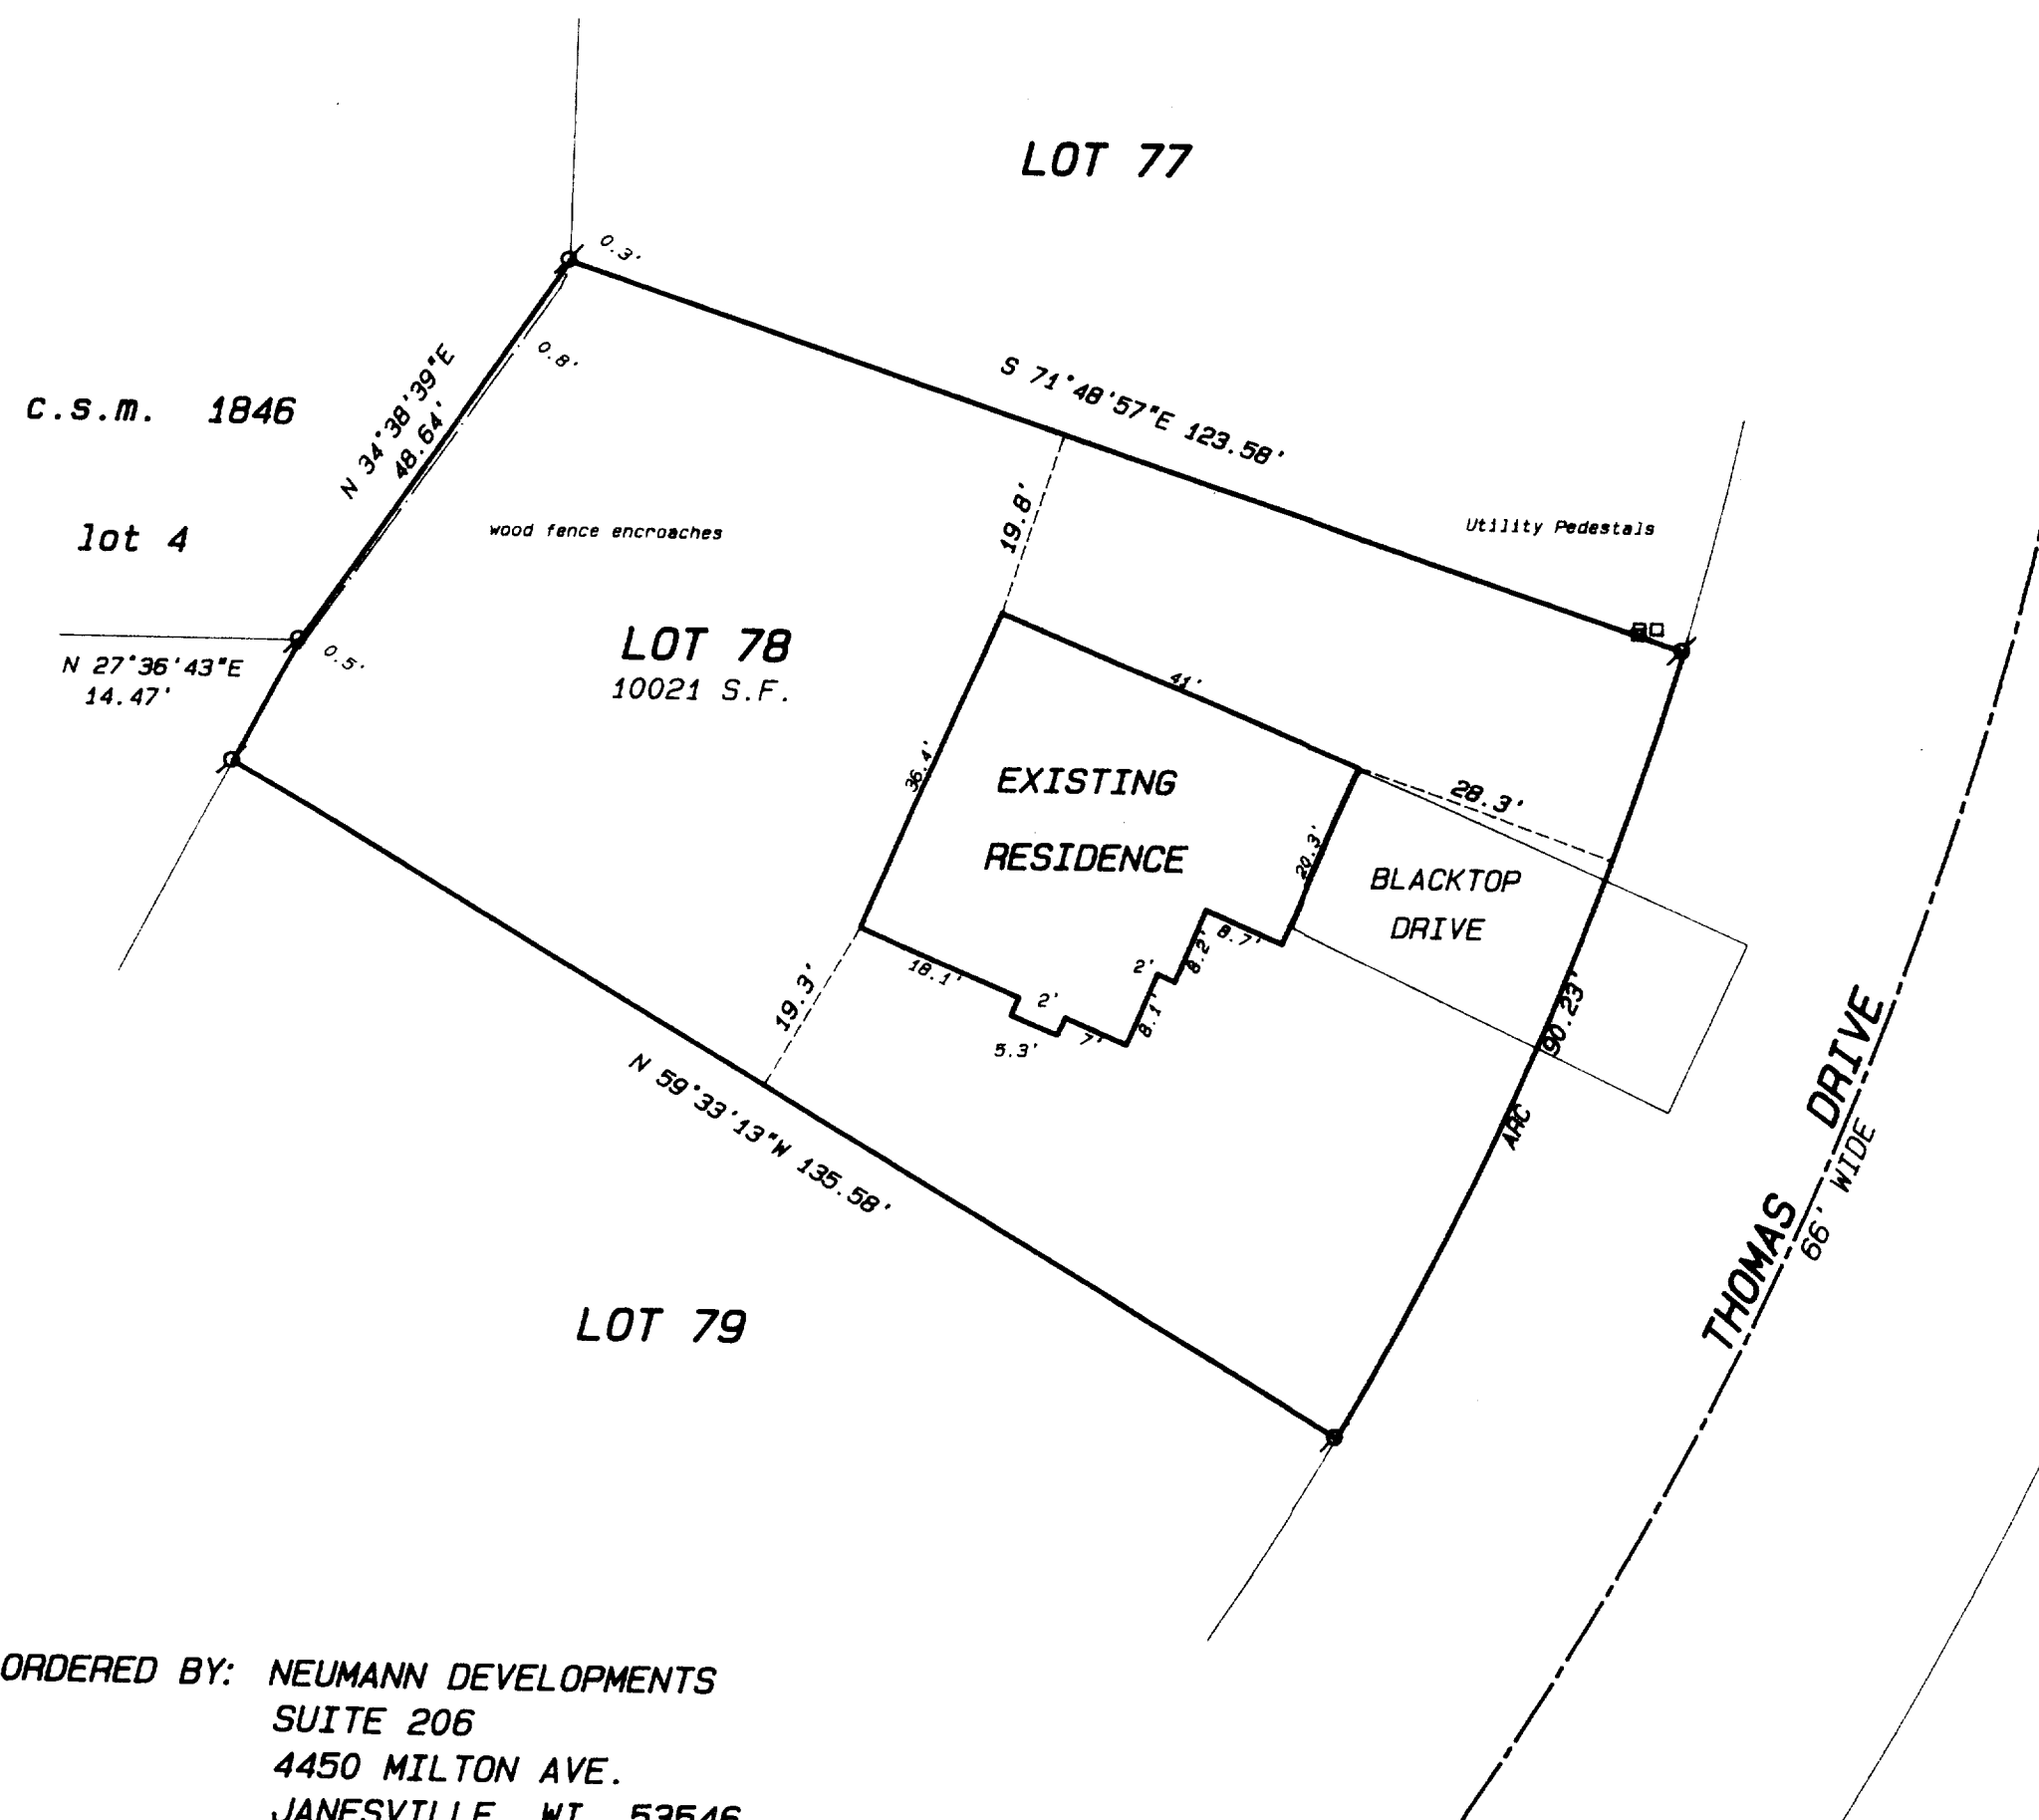

ORDERED BY: NEUMANN DEVELOPMENTS
SUITE 206
4450 MILTON AVE.
JANESVILLE, WI. 53546

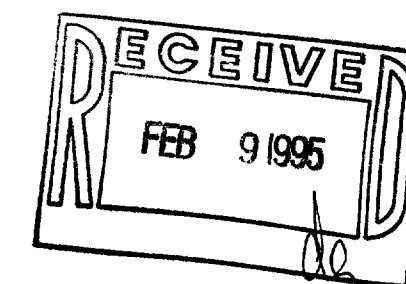

SCALE: 1" = 20 FEET

"I hereby certify that the above described property has been surveyed by me or under my direction and that the above map is a true representation thereof and shows the size and location of the property, its exterior boundaries, the location of all visible structures and dimensions of all principal buildings thereon, boundary fences, apparent easements, roadways and visible encroachments, if any."

"This survey is made for the use of the present owners of the property, and also those who purchase, mortgage, or guarantee the title thereto within one year from date hereof."

Kenneth B. Abernathy, Jr.
KENNETH B. ABERNATHY, JR.
WISCONSIN REGISTERED LAND SURVEYOR,
S-1594

Date: 12-15-94 Job No. 94.1209