



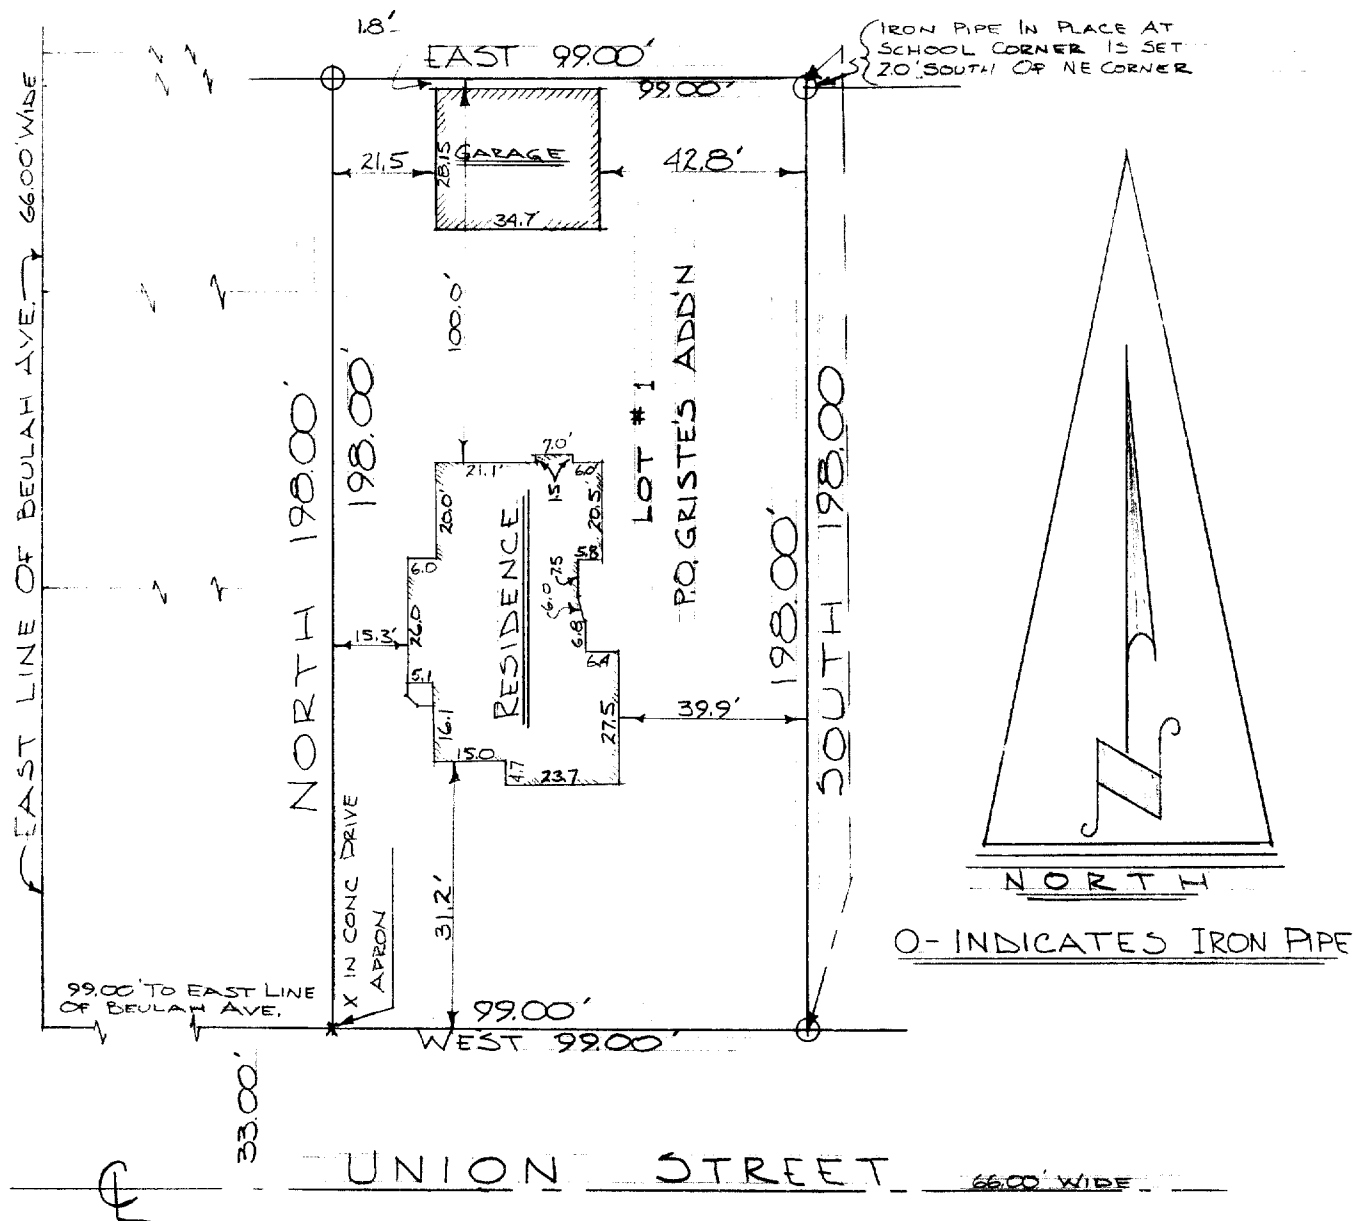

DESCRIPTION: Lot 1 of P. O. Griste's Addition to the Village of East Troy, Walworth County, Wisconsin.

CERTIFICATE: I, James F. Biagi, surveyor, do hereby certify that I have surveyed the property hereon described, and that the location of the improvements are as shown hereon.

November 22, 1963.

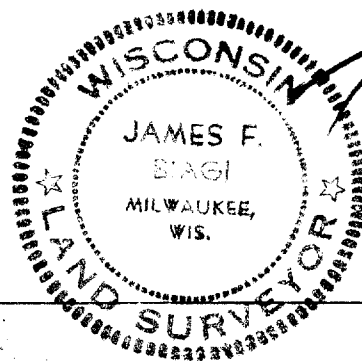

James F. Biagi RLS 272