


PLAT OF SURVEY
-OF-


LOT 2, BLOCK 3, EDWARDS ADDITION TO THE VILLAGE OF EAST TROY, located in Wauworth County, Wisconsin.

Survey For: Wayne & Delores Rich
Survey Location: 1950 Division Street

DIVISION STREET
(66' wide)


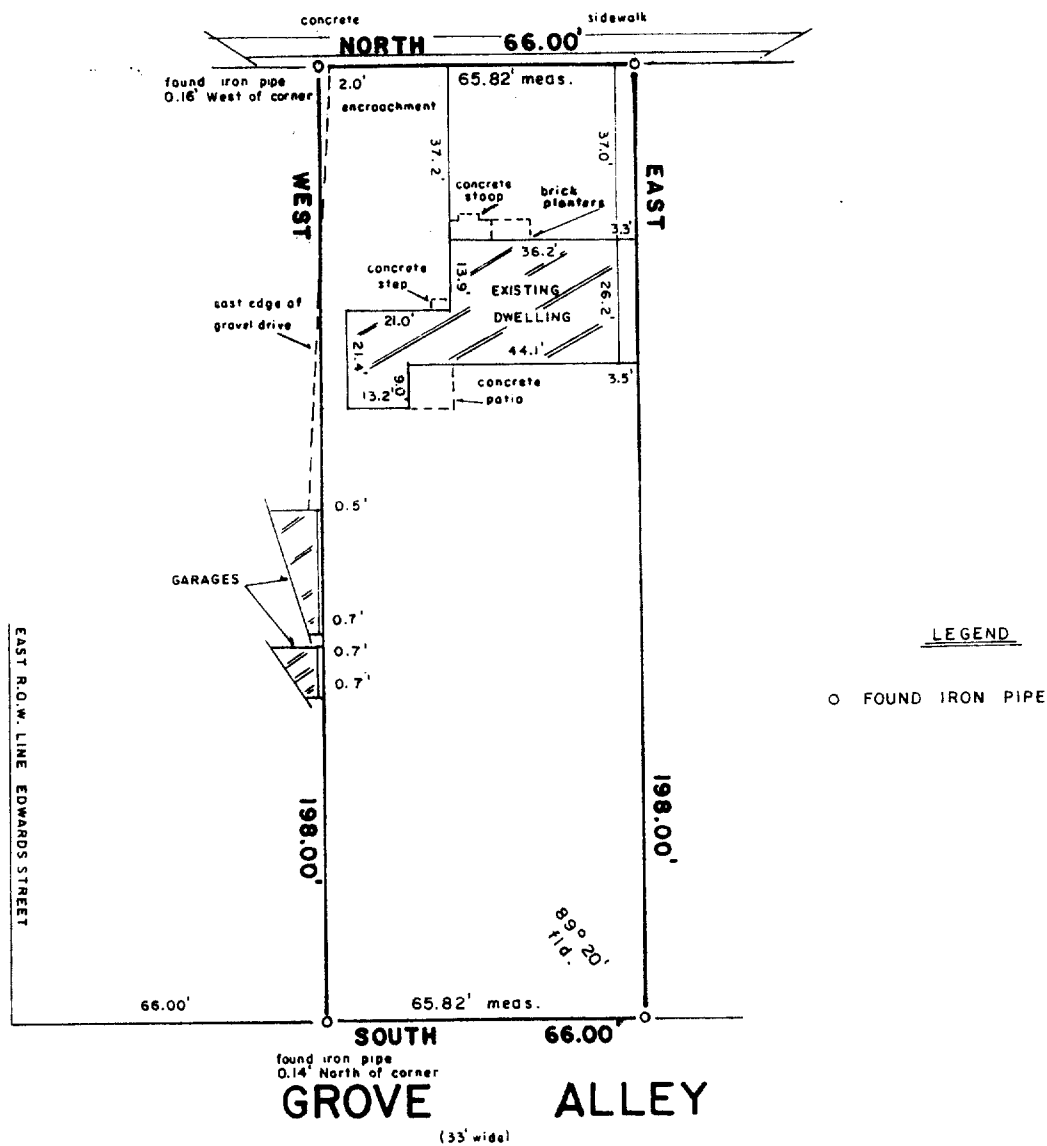


SCALE: 1" = 40'

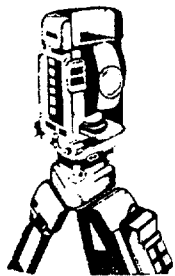

B.W. SURVEYING

Land Surveys
Mapping And Planning
425 Milwaukee Avenue
Burlington, WI 53105
(414) 767-0225

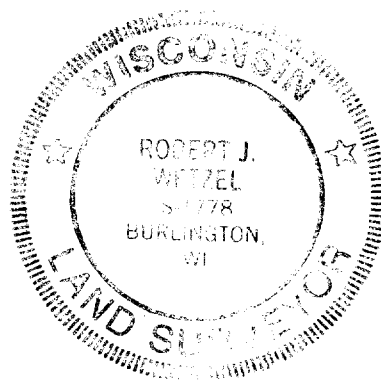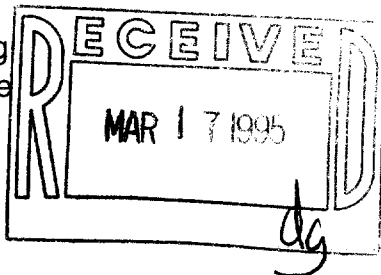

"I hereby certify that I have surveyed the above described property and that the above map is a true representation thereof and shows the size and location of the property, its exterior boundaries, the location of all visible structures and dimensions of all principal buildings thereon, boundary fences, apparent easements, roadways and encroachments, if any."

"This survey is made for the use of the present owners of the property, and those who purchase, mortgage, or guarantee the title thereto within one year from the date hereof."

THIS IS NOT AN ORIGINAL PRINT
UNLESS THIS SEAL IS RED

Robert J. Wetzel
ROBERT J. WETZEL
REGISTERED LAND SURVEYOR - 1778

1/3/95
DATE

1930
JOB NUMBER

REA-25

003-442