



PLAT OF SURVEY
 LOT 16 LYNNDAL SUBDIVISION
 SEC. 20, T. 4 N., R. 18 E.
 VILLAGE OF EAST TROY
 WALWORTH COUNTY, WISCONSIN

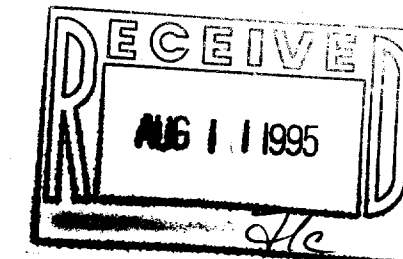

ASSIGNED W. LINE HILLTOP DRIVE
 S 16° 32' W
 PER RECORD PLAT


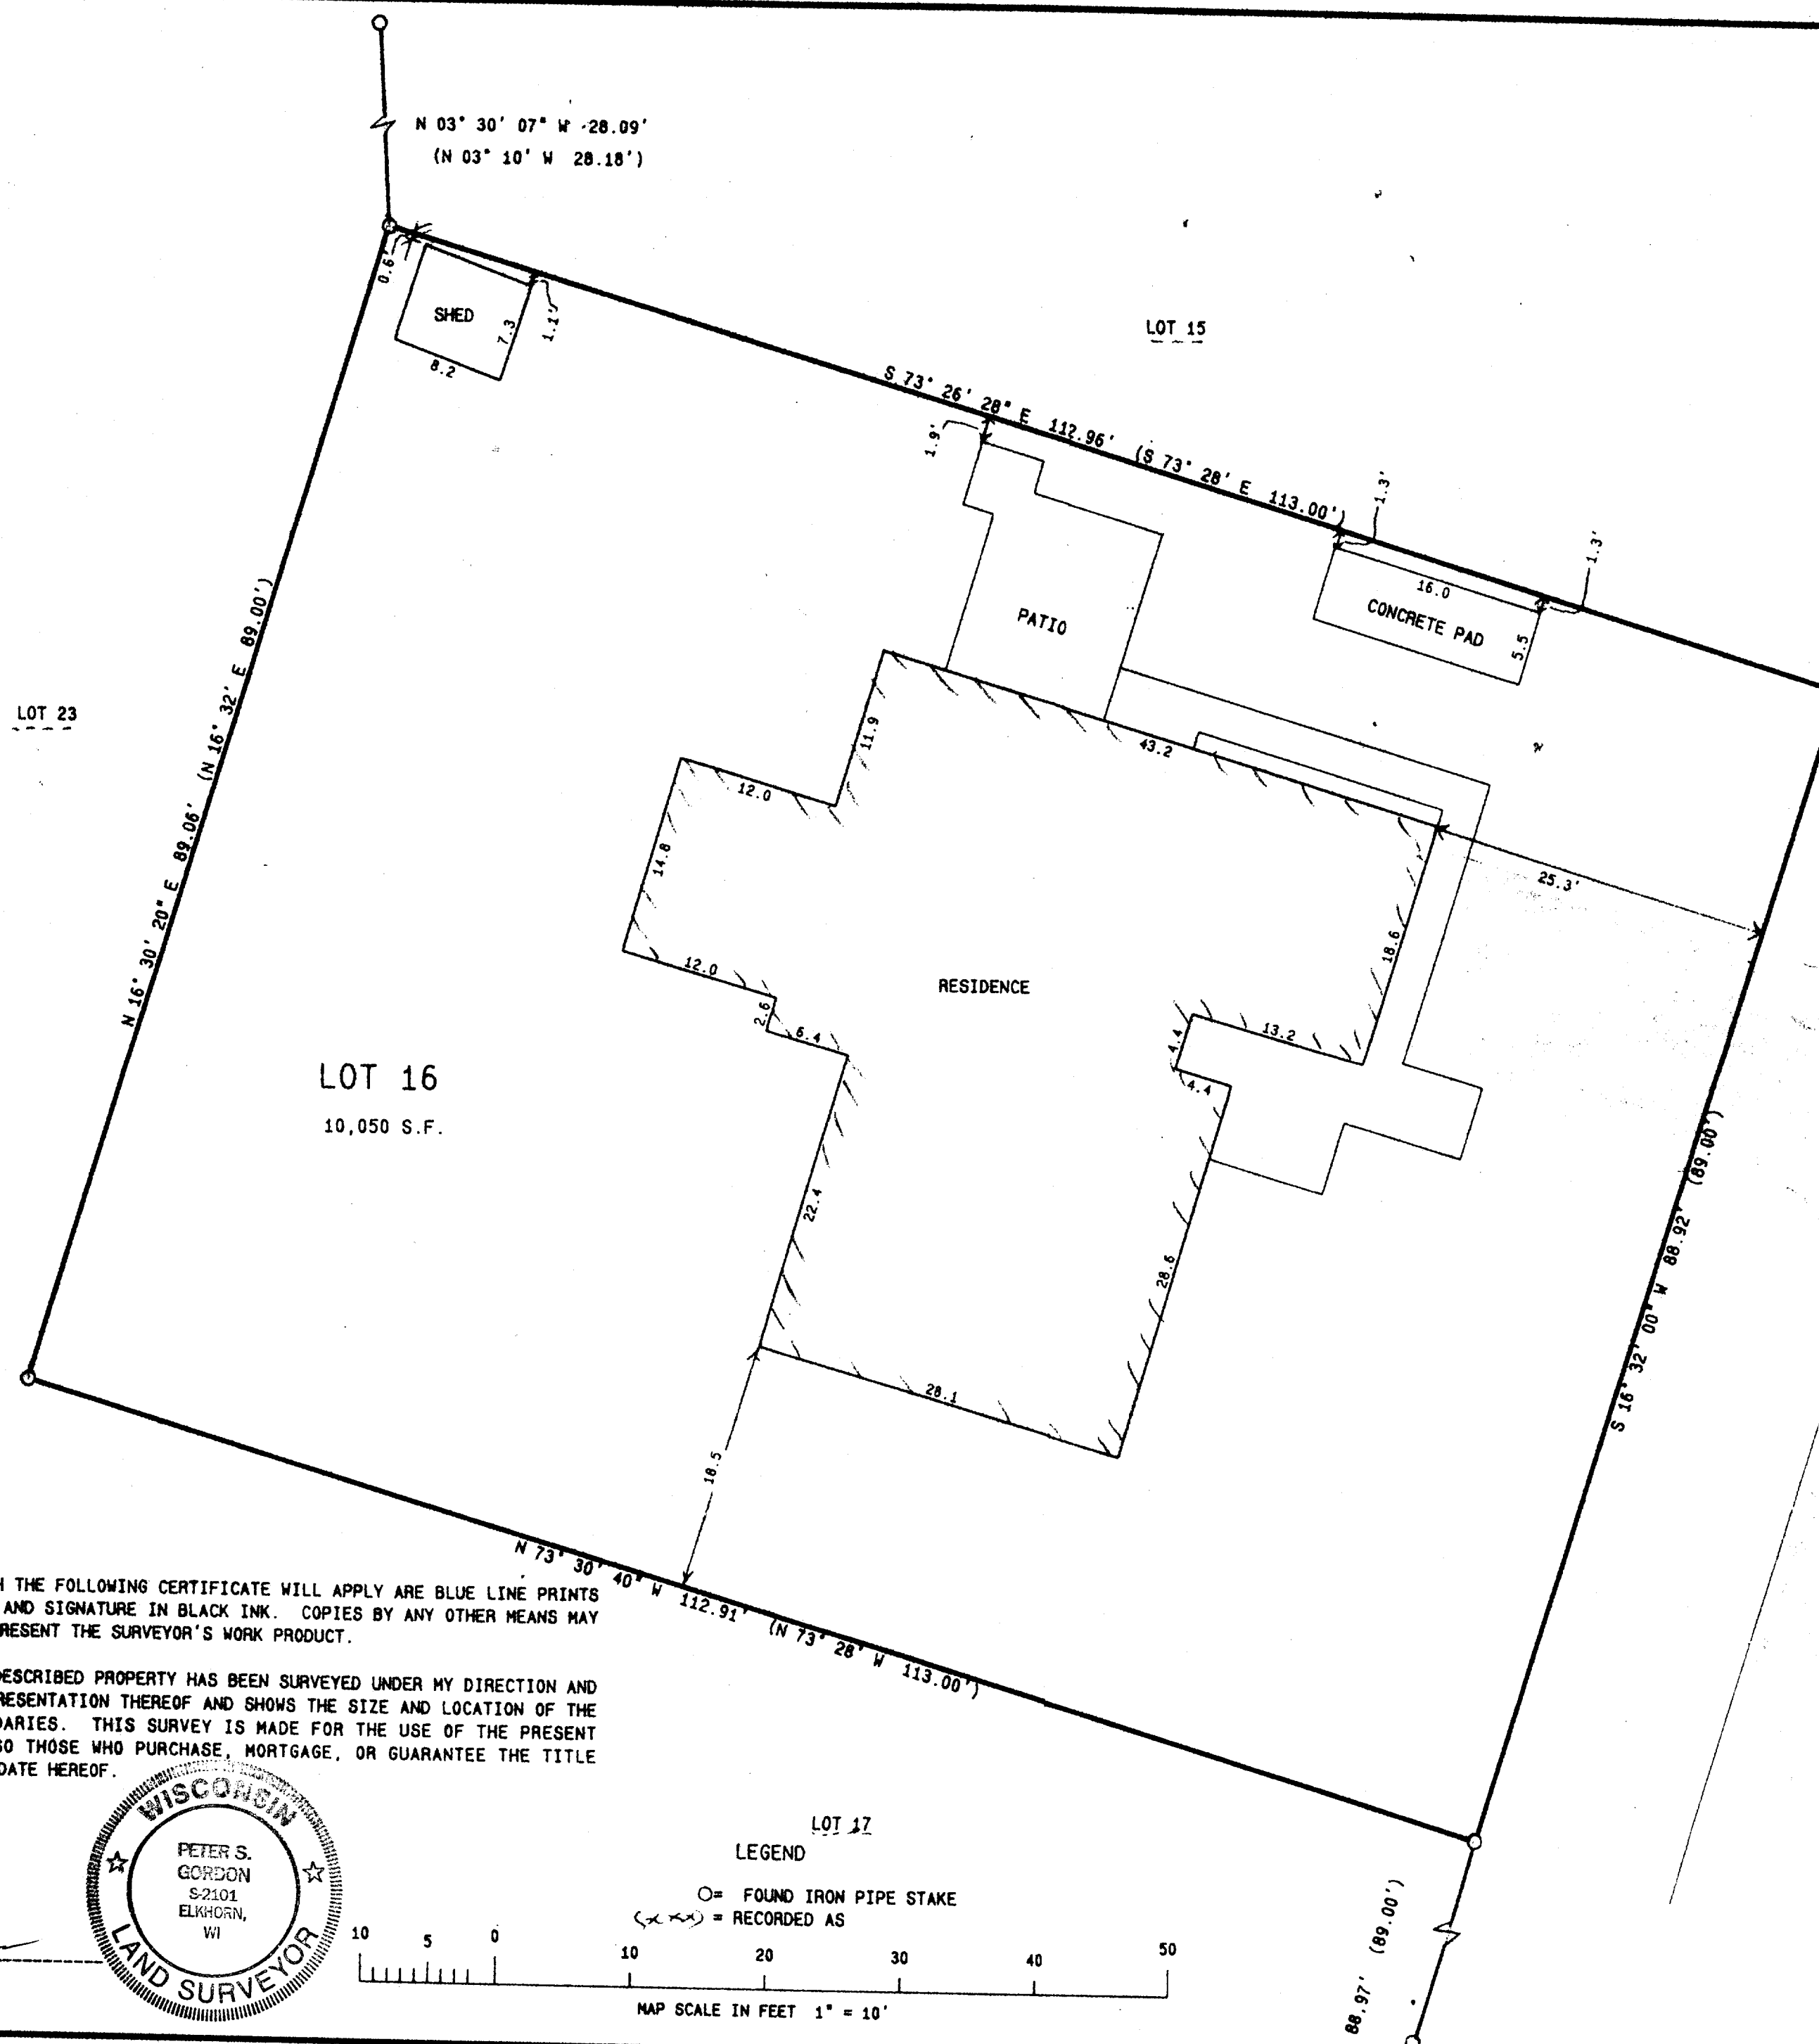


NOTE: COPIES OF THIS MAP TO WHICH THE FOLLOWING CERTIFICATE WILL APPLY ARE BLUE LINE PRINTS SHOWING SURVEYOR'S ORIGINAL SEAL AND SIGNATURE IN BLACK INK. COPIES BY ANY OTHER MEANS MAY HAVE ALTERATIONS WHICH DO NOT REPRESENT THE SURVEYOR'S WORK PRODUCT.

I HEREBY CERTIFY THAT THE ABOVE DESCRIBED PROPERTY HAS BEEN SURVEYED UNDER MY DIRECTION AND THAT THE ABOVE MAP IS A TRUE REPRESENTATION THEREOF AND SHOWS THE SIZE AND LOCATION OF THE PROPERTY AND ITS EXTERIOR BOUNDARIES. THIS SURVEY IS MADE FOR THE USE OF THE PRESENT OWNERS OF THE PROPERTY, AND ALSO THOSE WHO PURCHASE, MORTGAGE, OR GUARANTEE THE TITLE THERETO WITHIN ONE YEAR FROM THE DATE HEREOF.

DATED: 7-11-95

PETER S. GORDON R.L.S. 2101

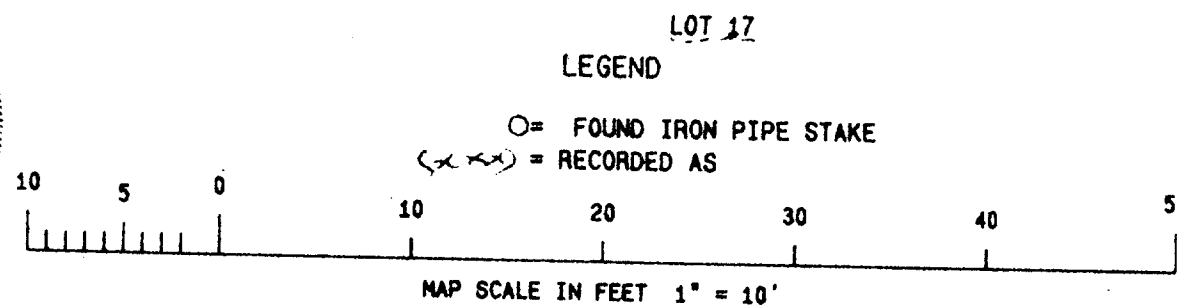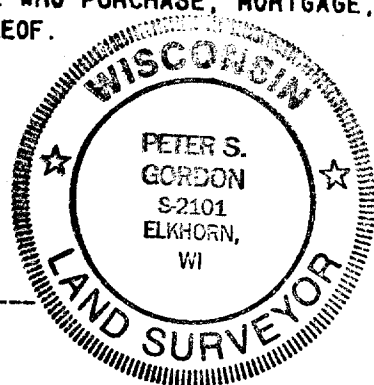

WORK ORDERED BY: ROY & CAROL MORRAL
 1869 HILLTOP DRIVE
 EAST TROY, WISCONSIN 53120

FARRIS, HANSEN & ASSOCIATES, INC.
 Engineering, Architecture, Surveying
 7 Ridgeway Court, P.O. Box 437
 ELKHORN, WISCONSIN 53121
 Office: (414) 723-2098
 Fax: (414) 723-5886

REVISIONS

PROJECT NO. 4328
 DATE 07/11/95
 SHEET NO. 1 OF 1