


3318

3318

DIVISION STREET

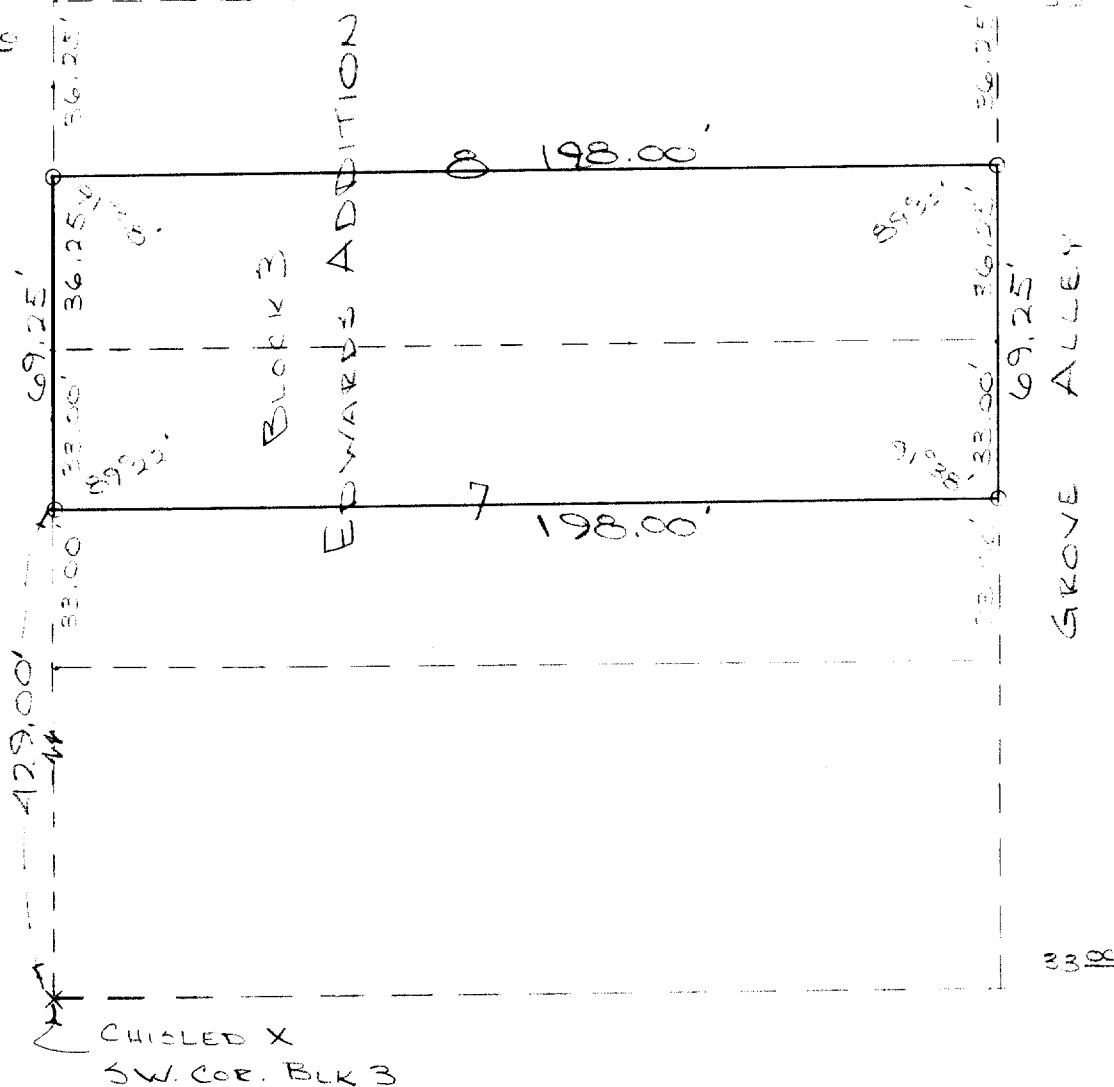

CHISELED X
SW. COR. BLK 3

EDWARDS STREET

O - INDICATES IRON PIPE

DESCRIPTION:

The N $\frac{1}{2}$ of Lot number Seven (7) and the S $\frac{1}{2}$ of Lot number Eight (8) Edwards Addition to the Village of East Troy, Walworth County, Wisconsin.

CERTIFICATE:

I, Joseph M. Biagi, surveyor, do hereby certify that I have surveyed the lands hereon described.

July 25, 1973

Joseph M. Biagi R.L.S. 12
Elkhorn, Wisconsin

(EDWARDS)

REA - 30

3-4513