


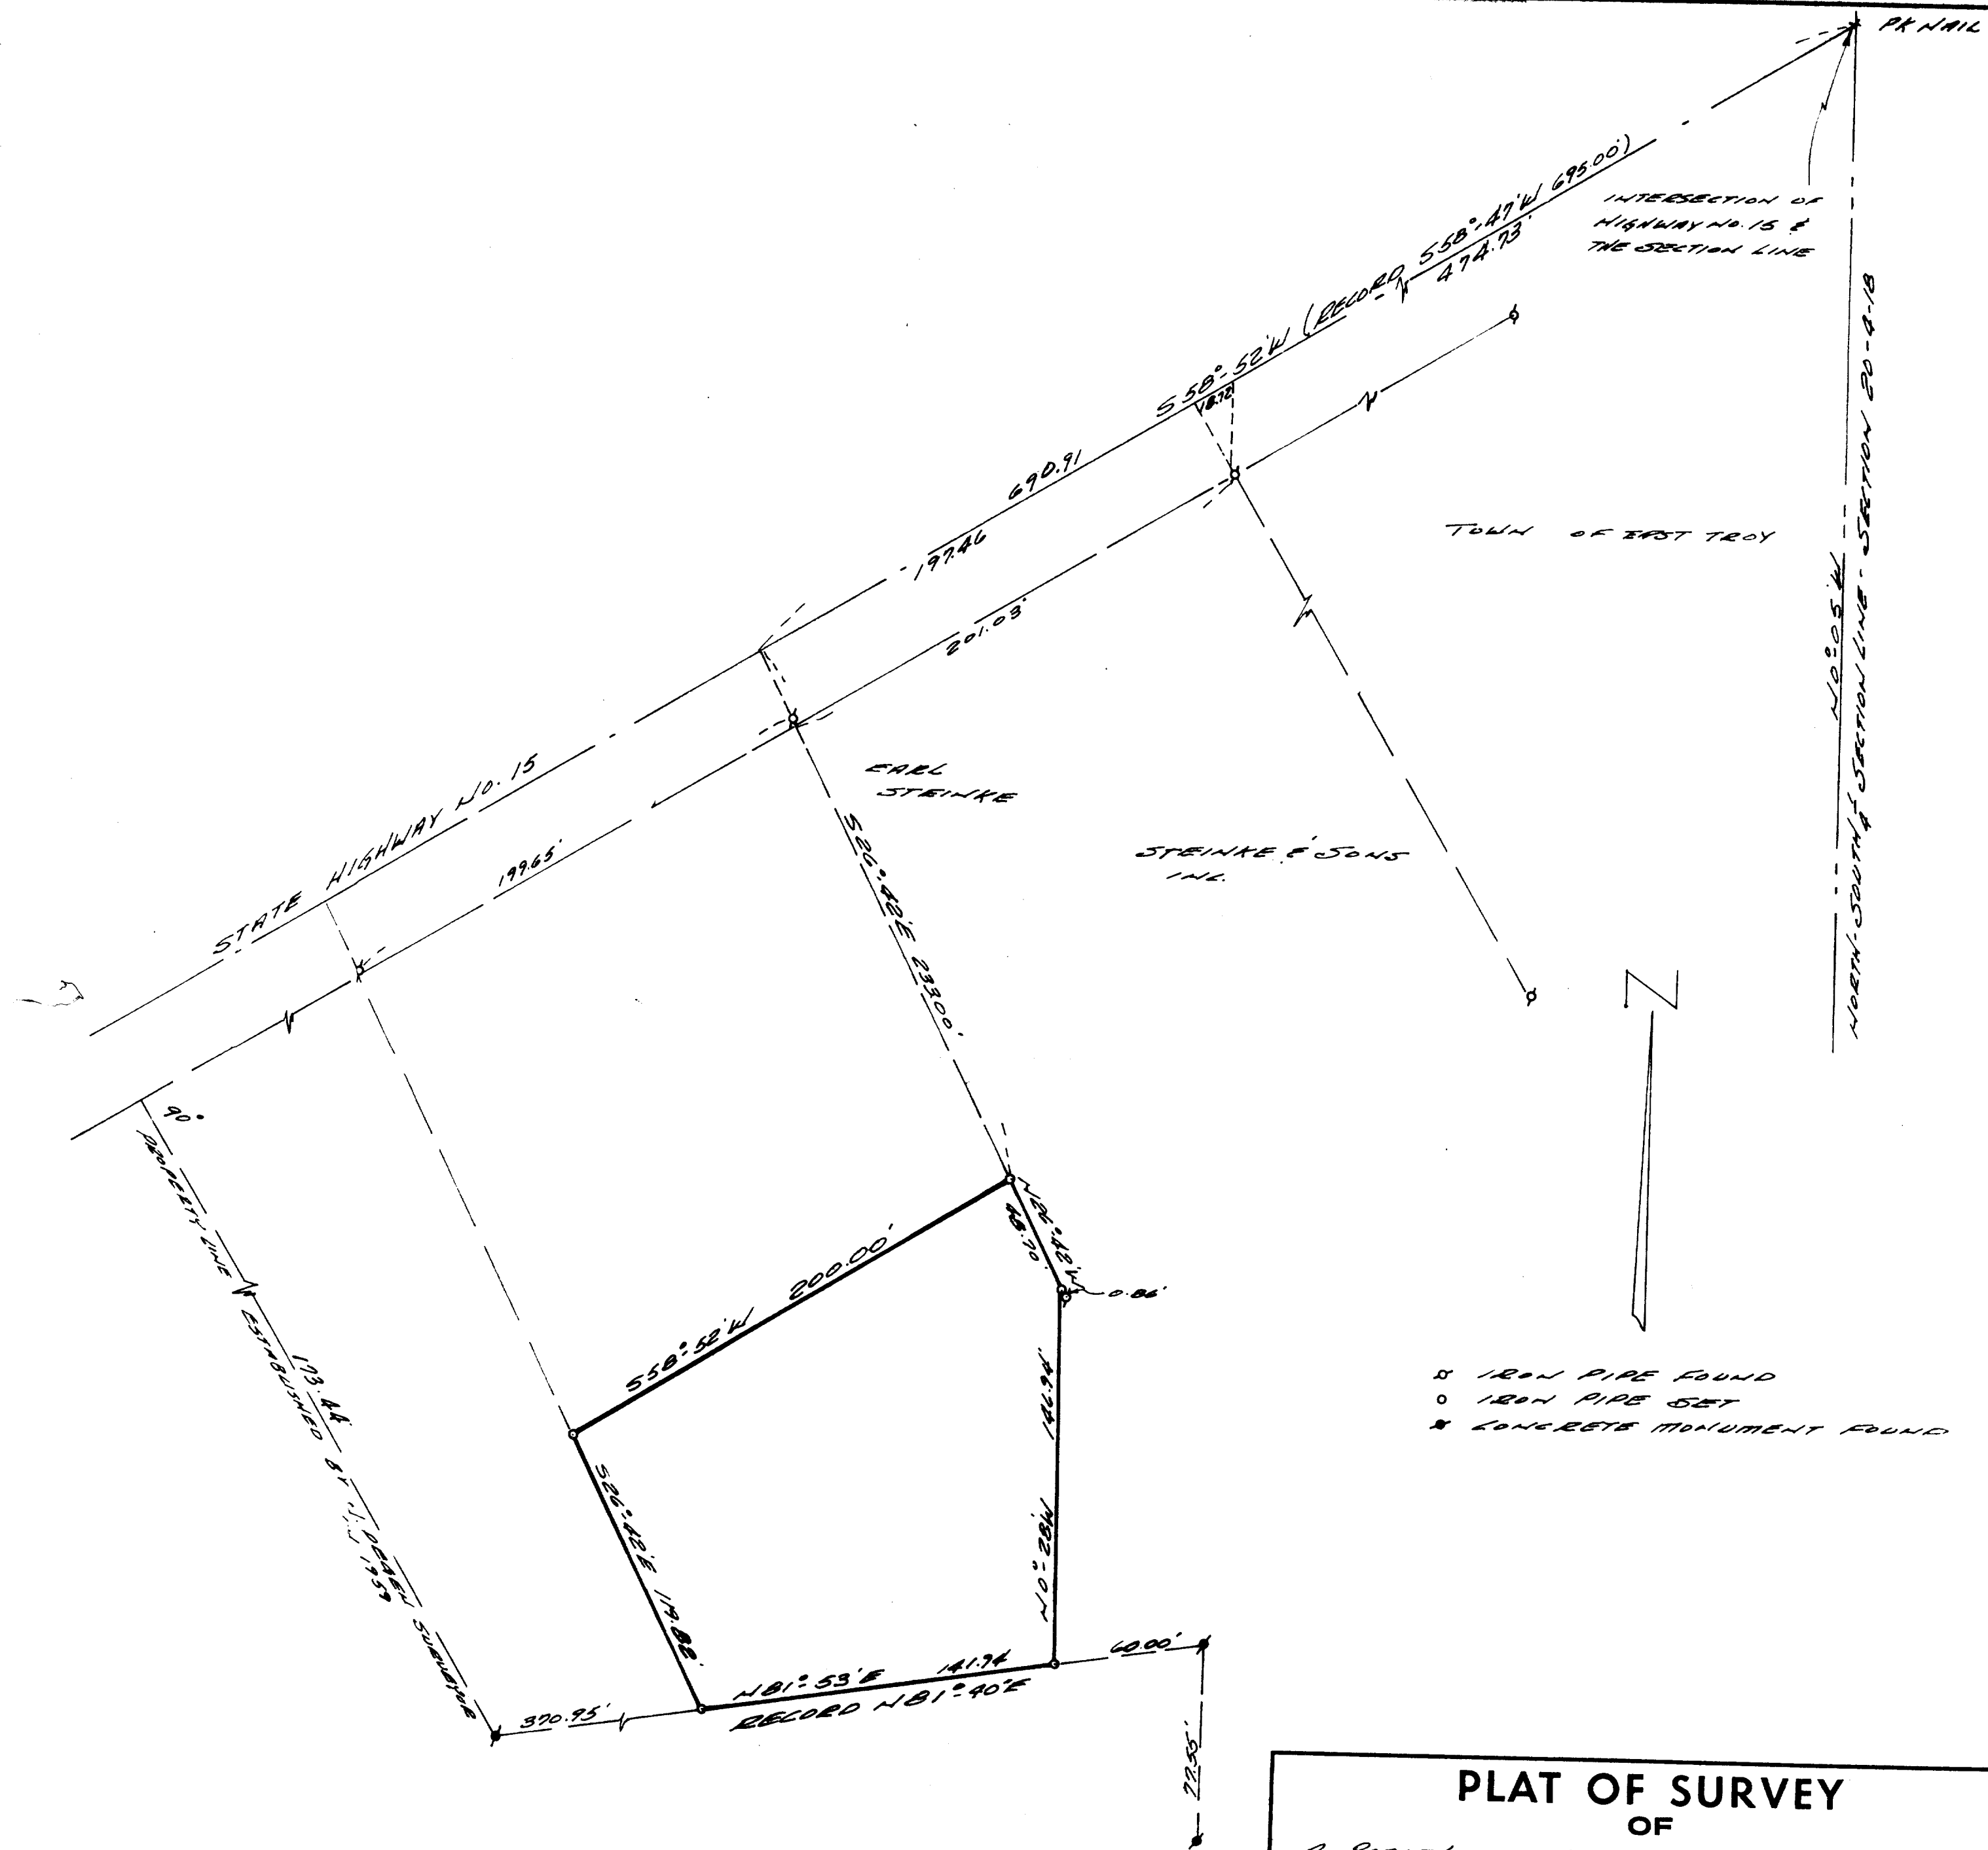

PLAT OF SURVEY OF

A PARCEL OF LAND LOCATED IN THE
S 1/2 OF SECTION 20, T4N R1E, VILLAGE
OF EAST TROY, WISCONSIN.

Lloyd Jensen
SURVEYOR

SCALE 1" = 60'

DATE 5/11/1972