

Plat of Survey

SCALE 1" = 40'

JAHNKE & JAHNKE ASSOCIATES INC.

Consultants in Engineering, Planning, Subdivisions and Surveying

711 W. MORELAND BLVD. -- WAUKESHA, WISCONSIN 53188

TELEPHONE (414) 542-5797 FAX (414) 542-7098

FOR: BIELINSKI BROS. BUILDERS, INC. RE: DUKLET

LEGAL DESCRIPTION: Lot 41, STERLING OAKS, being a subdivision of part of the SE 1/4 of the NW 1/4, and part of the NW 1/4 and SW 1/4 of the NE 1/4 of Section 20, Township 4 North, Range 19 East in the Village of East Troy, Walworth County, Wisconsin.

Bench Mark 853.35 (USGS) Hydrant "open" located at northwest corner of Lot 3.

852.7 - Existing elevation

Existing Top of Foundation 855.00

Suggested Residence Grade: First Floor 856.5*

Garage Opening 853.92

Top of Foundation 855.5*

3/27/97 - Basement constructed
and located as shown.

*suggested grades only

• Iron pipes found as part of this survey.


NOTE: Expose sanitary sewer lateral before construction to verify gravity flow from the basement.

REFERENCE MERIDIAN: The south line of the NE 1/4 of Section 20 was used as the reference meridian and has an assumed bearing of S88°45'21"W.

SURVEY CERTIFICATE: I have surveyed the above described property and the map shown is a true representation thereof and shows the size and location of the property, its exterior boundaries, the location and dimensions of all visible structures thereon, fences, apparent easements and roadways and visible encroachments if any. This survey is made for the exclusive use of the present owners of the property and also those who purchase, mortgage, or guarantee the title thereto within one (1) year from date hereof and as to them I warrant the accuracy of

LOT - 42
said survey and map.

OUT LOT - 1

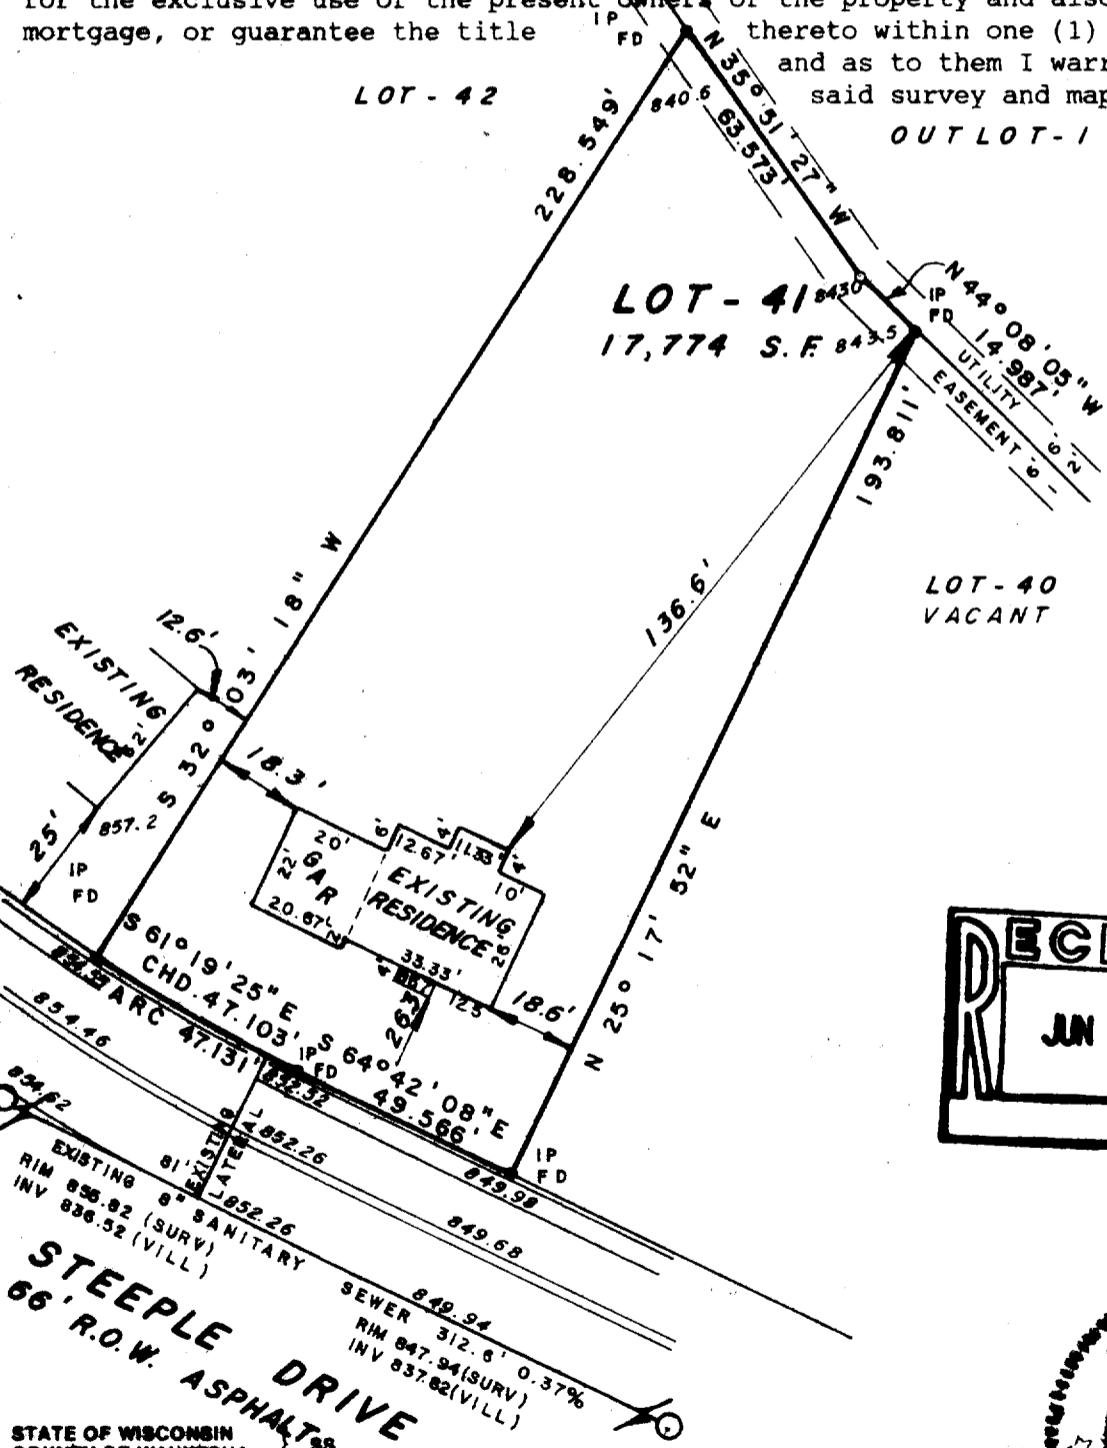

STATE OF WISCONSIN
COUNTY OF WAUKESHA


WE, JAHNKE & JAHNKE ASSOCIATES INC., DO HEREBY CERTIFY THAT WE HAVE MADE THIS SURVEY AND THAT THE INFORMATION AS SHOWN ON THE ABOVE PLAT OF SURVEY IS TRUE AND CORRECT REPRESENTATION THEREOF.

Revised 2/21/97 (Stakeout)

Revised 3/28/97 (Basement survey)

DATED THIS 13th DAY OF March 1996

PLAT No. U.S. Walworth 187 BOOK Walworth #9 PAGE 44

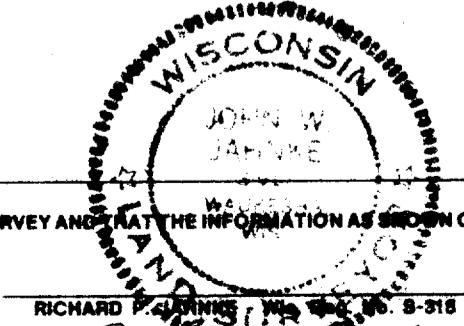

RICHARD P. CLARKSON, WIS. REG. NO. 8-318

JOHN W. JAHNKE - WIS. REG. NO. 8-317